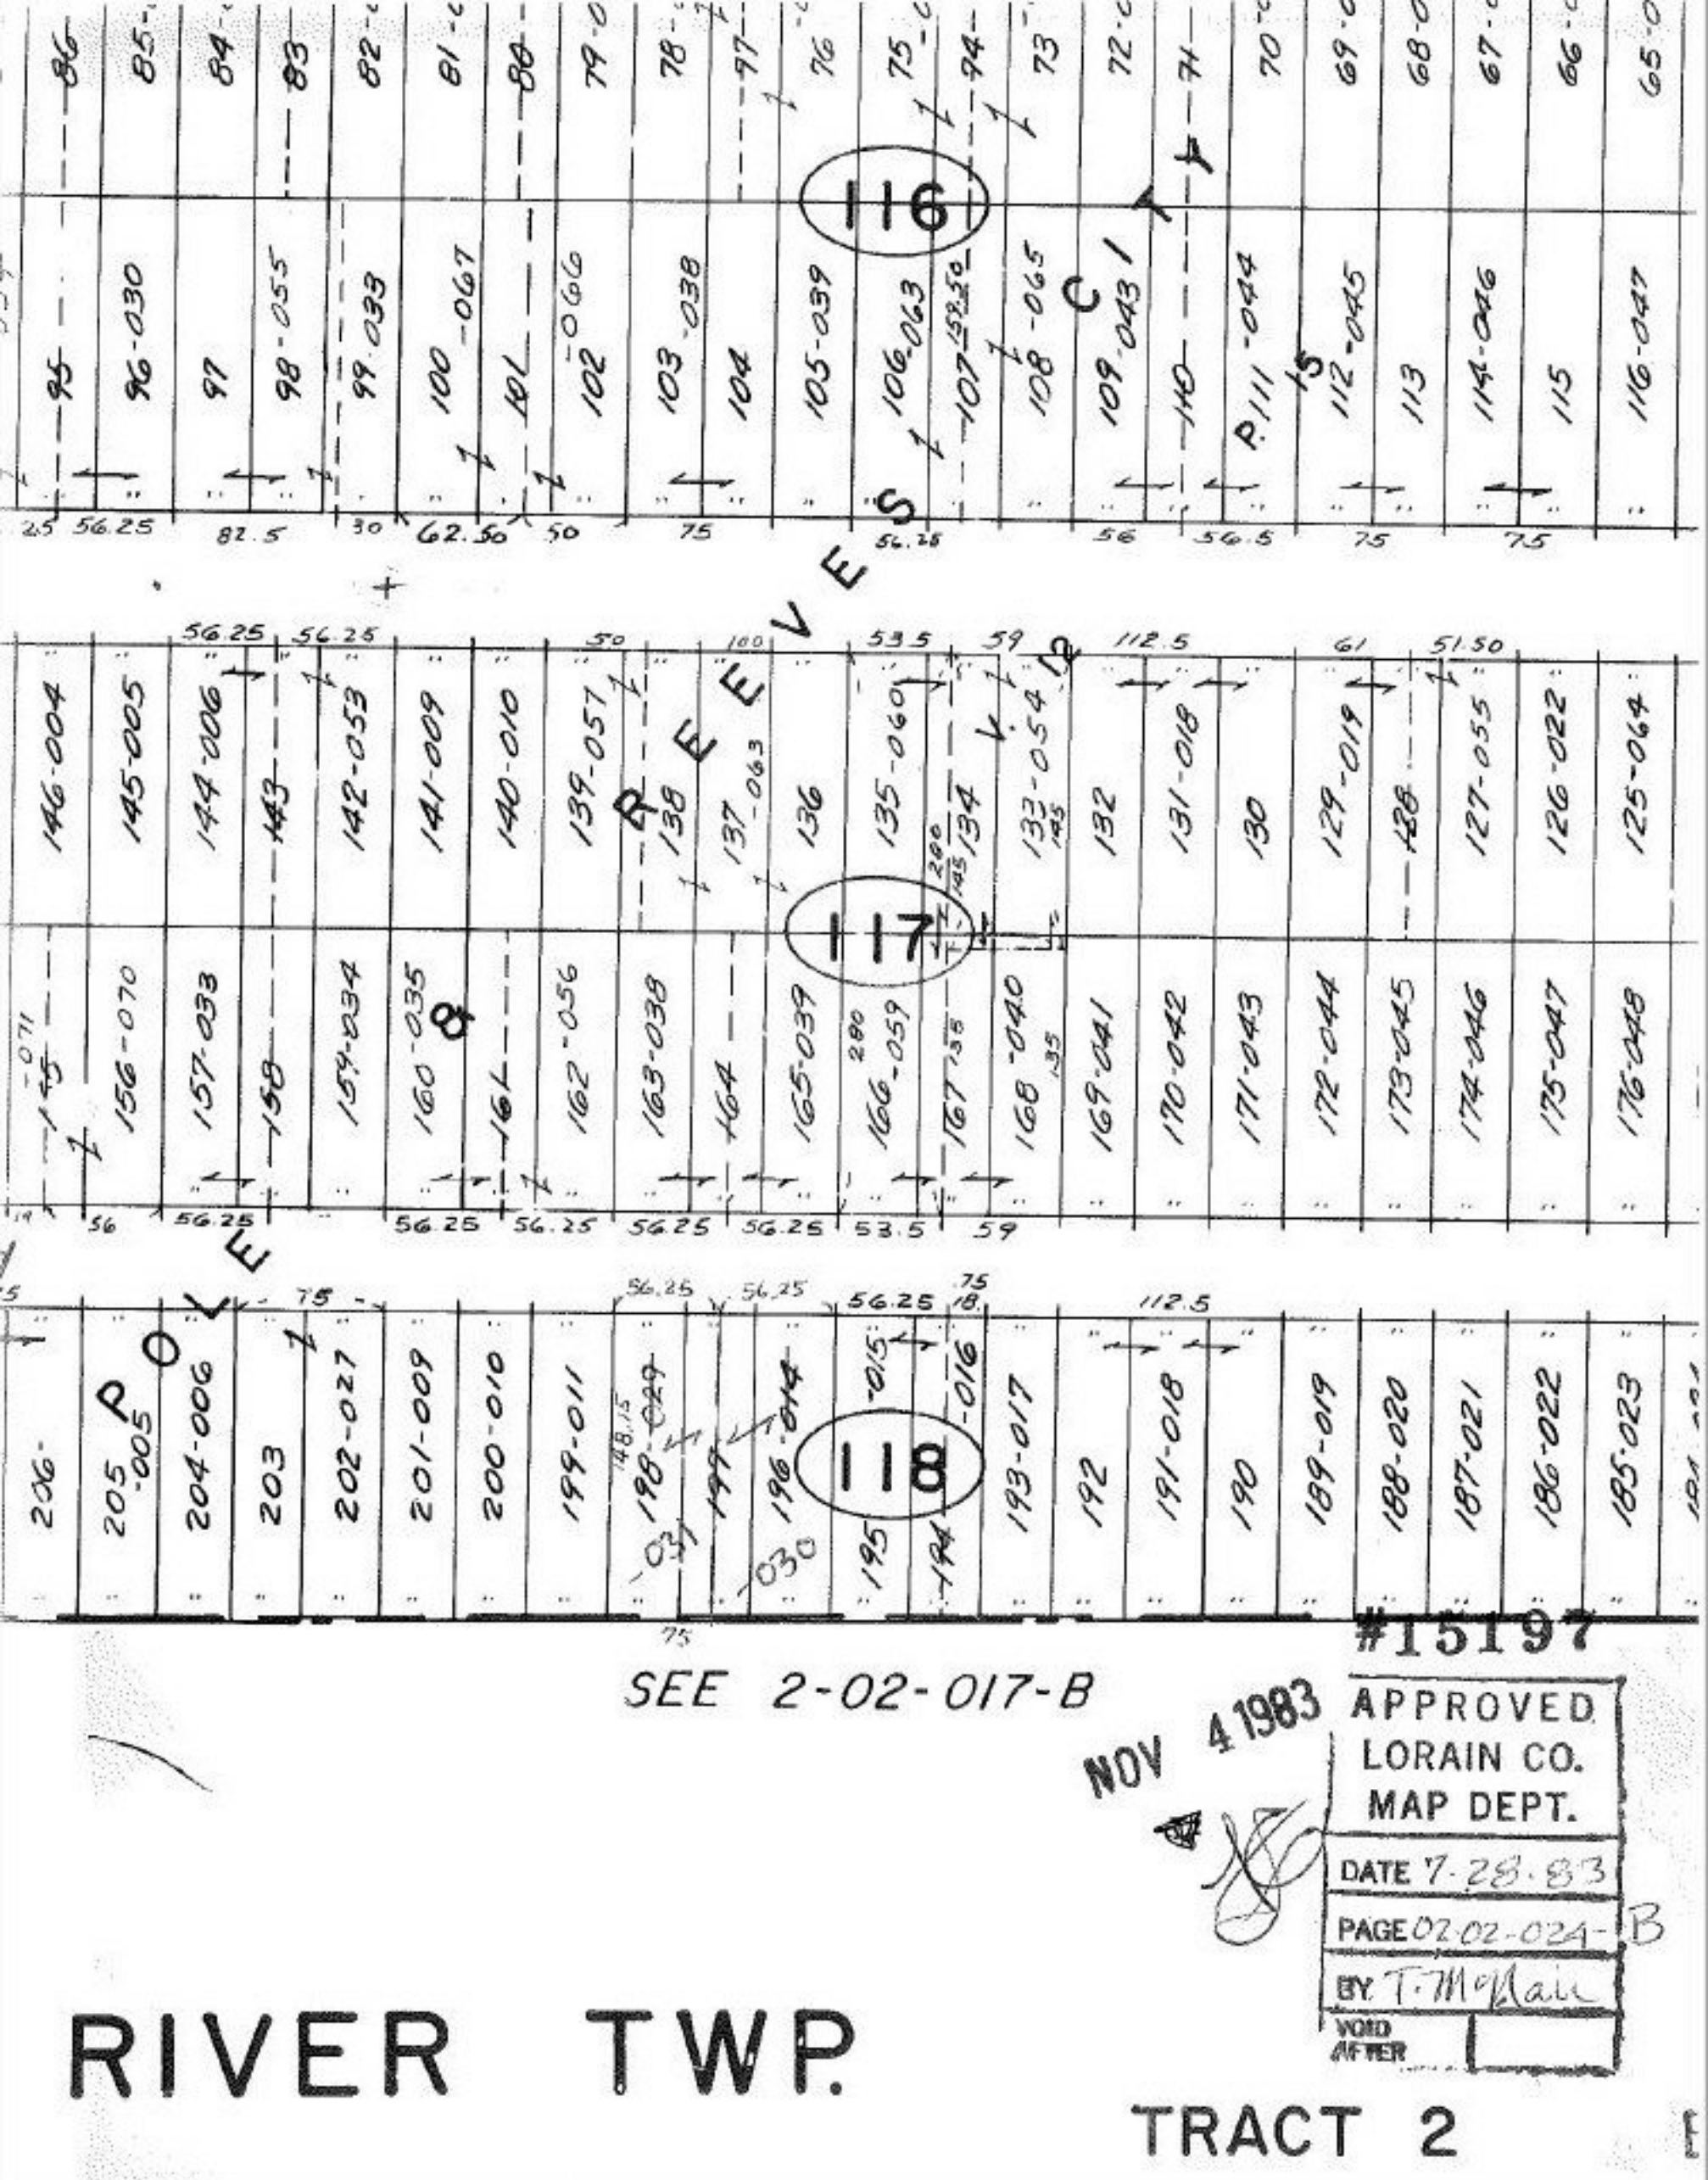

#15197

NOV 4 1983

APPROVED
LORAIN CO.
MAP DEPT.
DATE 7-28-83
PAGE 02-02-024-B
BY T. McClain
VOID AFTER

RIVER TWP.

TRACT 2