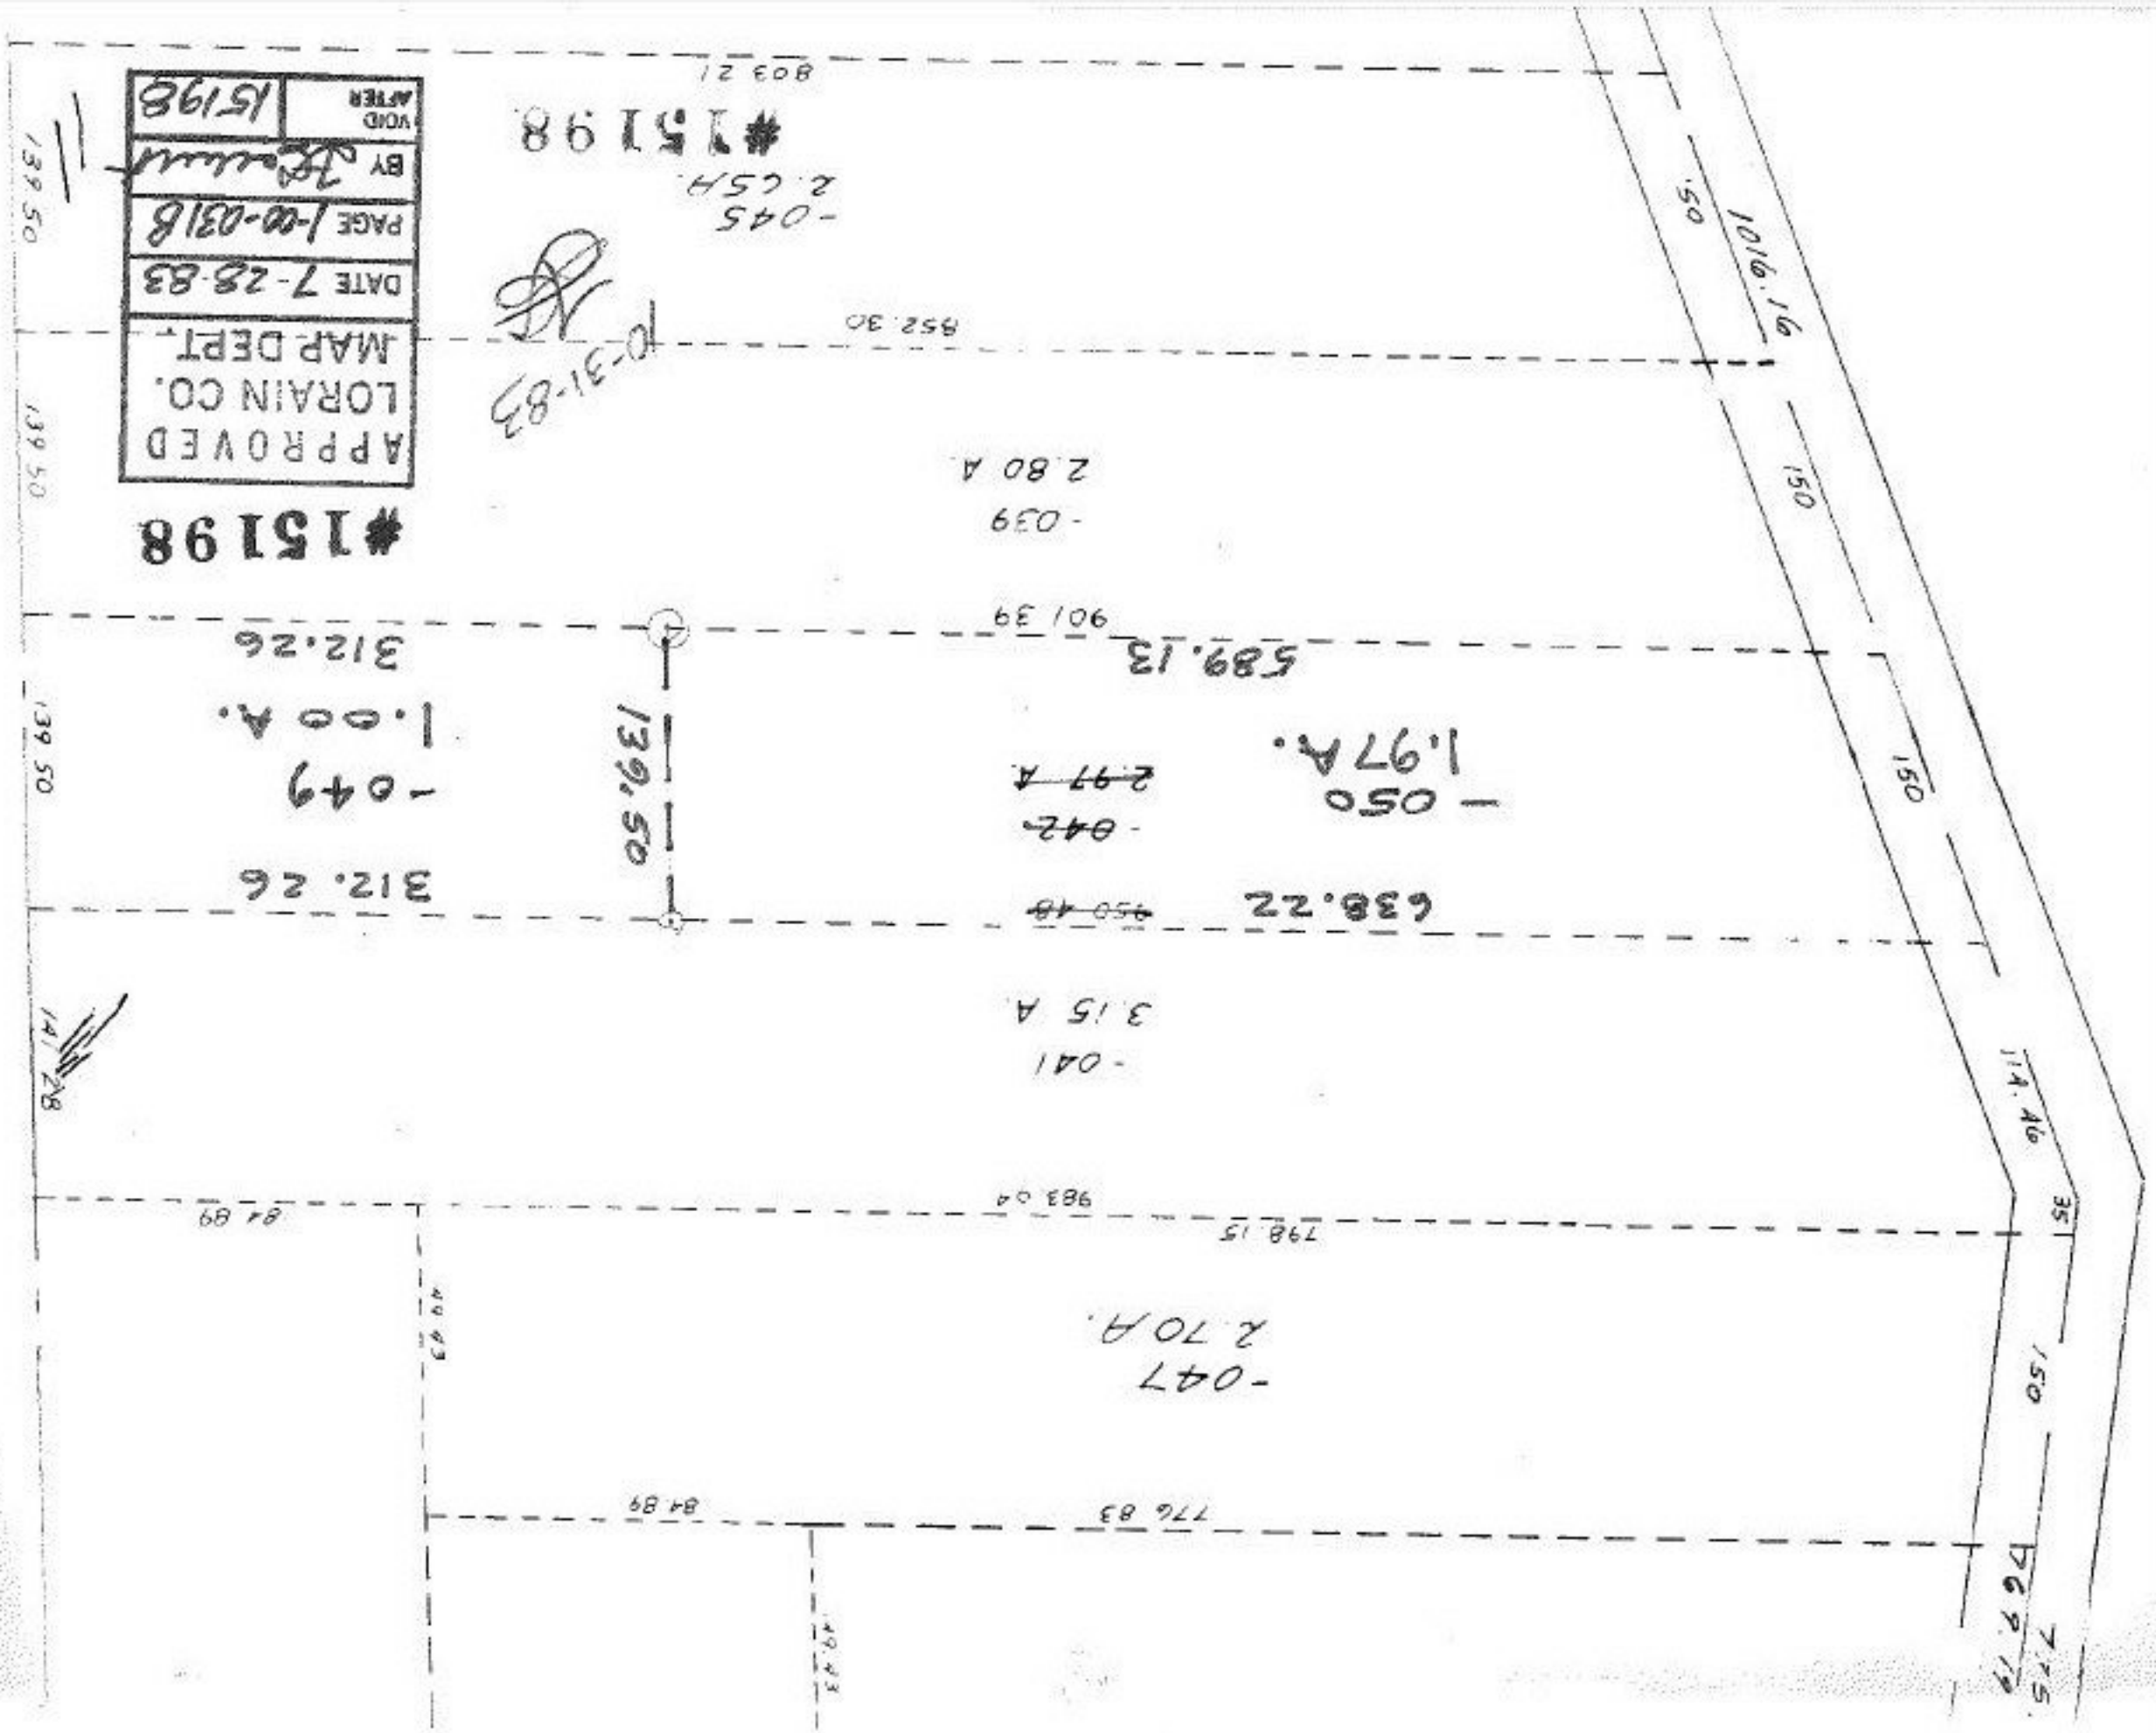

#15198
APPROVED
LORAIN CO.
MAP DEPT.
DATE 7-28-83
PAGE 1-00-031B
BY
VOID AFTER 15198
#15198
-045
2.65A
10-31-83
852.30
2.80 A
-039
901.39
589.13
312.26
1.00 A.
-049
139.50
1.97A.
-050
2.97 A
-042
312.26
638.22
950.48
3.15 A
-041
983.04
798.15
84.89
-047
2.70 A.
776.83
84.89
1016.16
114.46
76.9.19
139.50
139.50
139.50
141.28
150
150
150
150
35