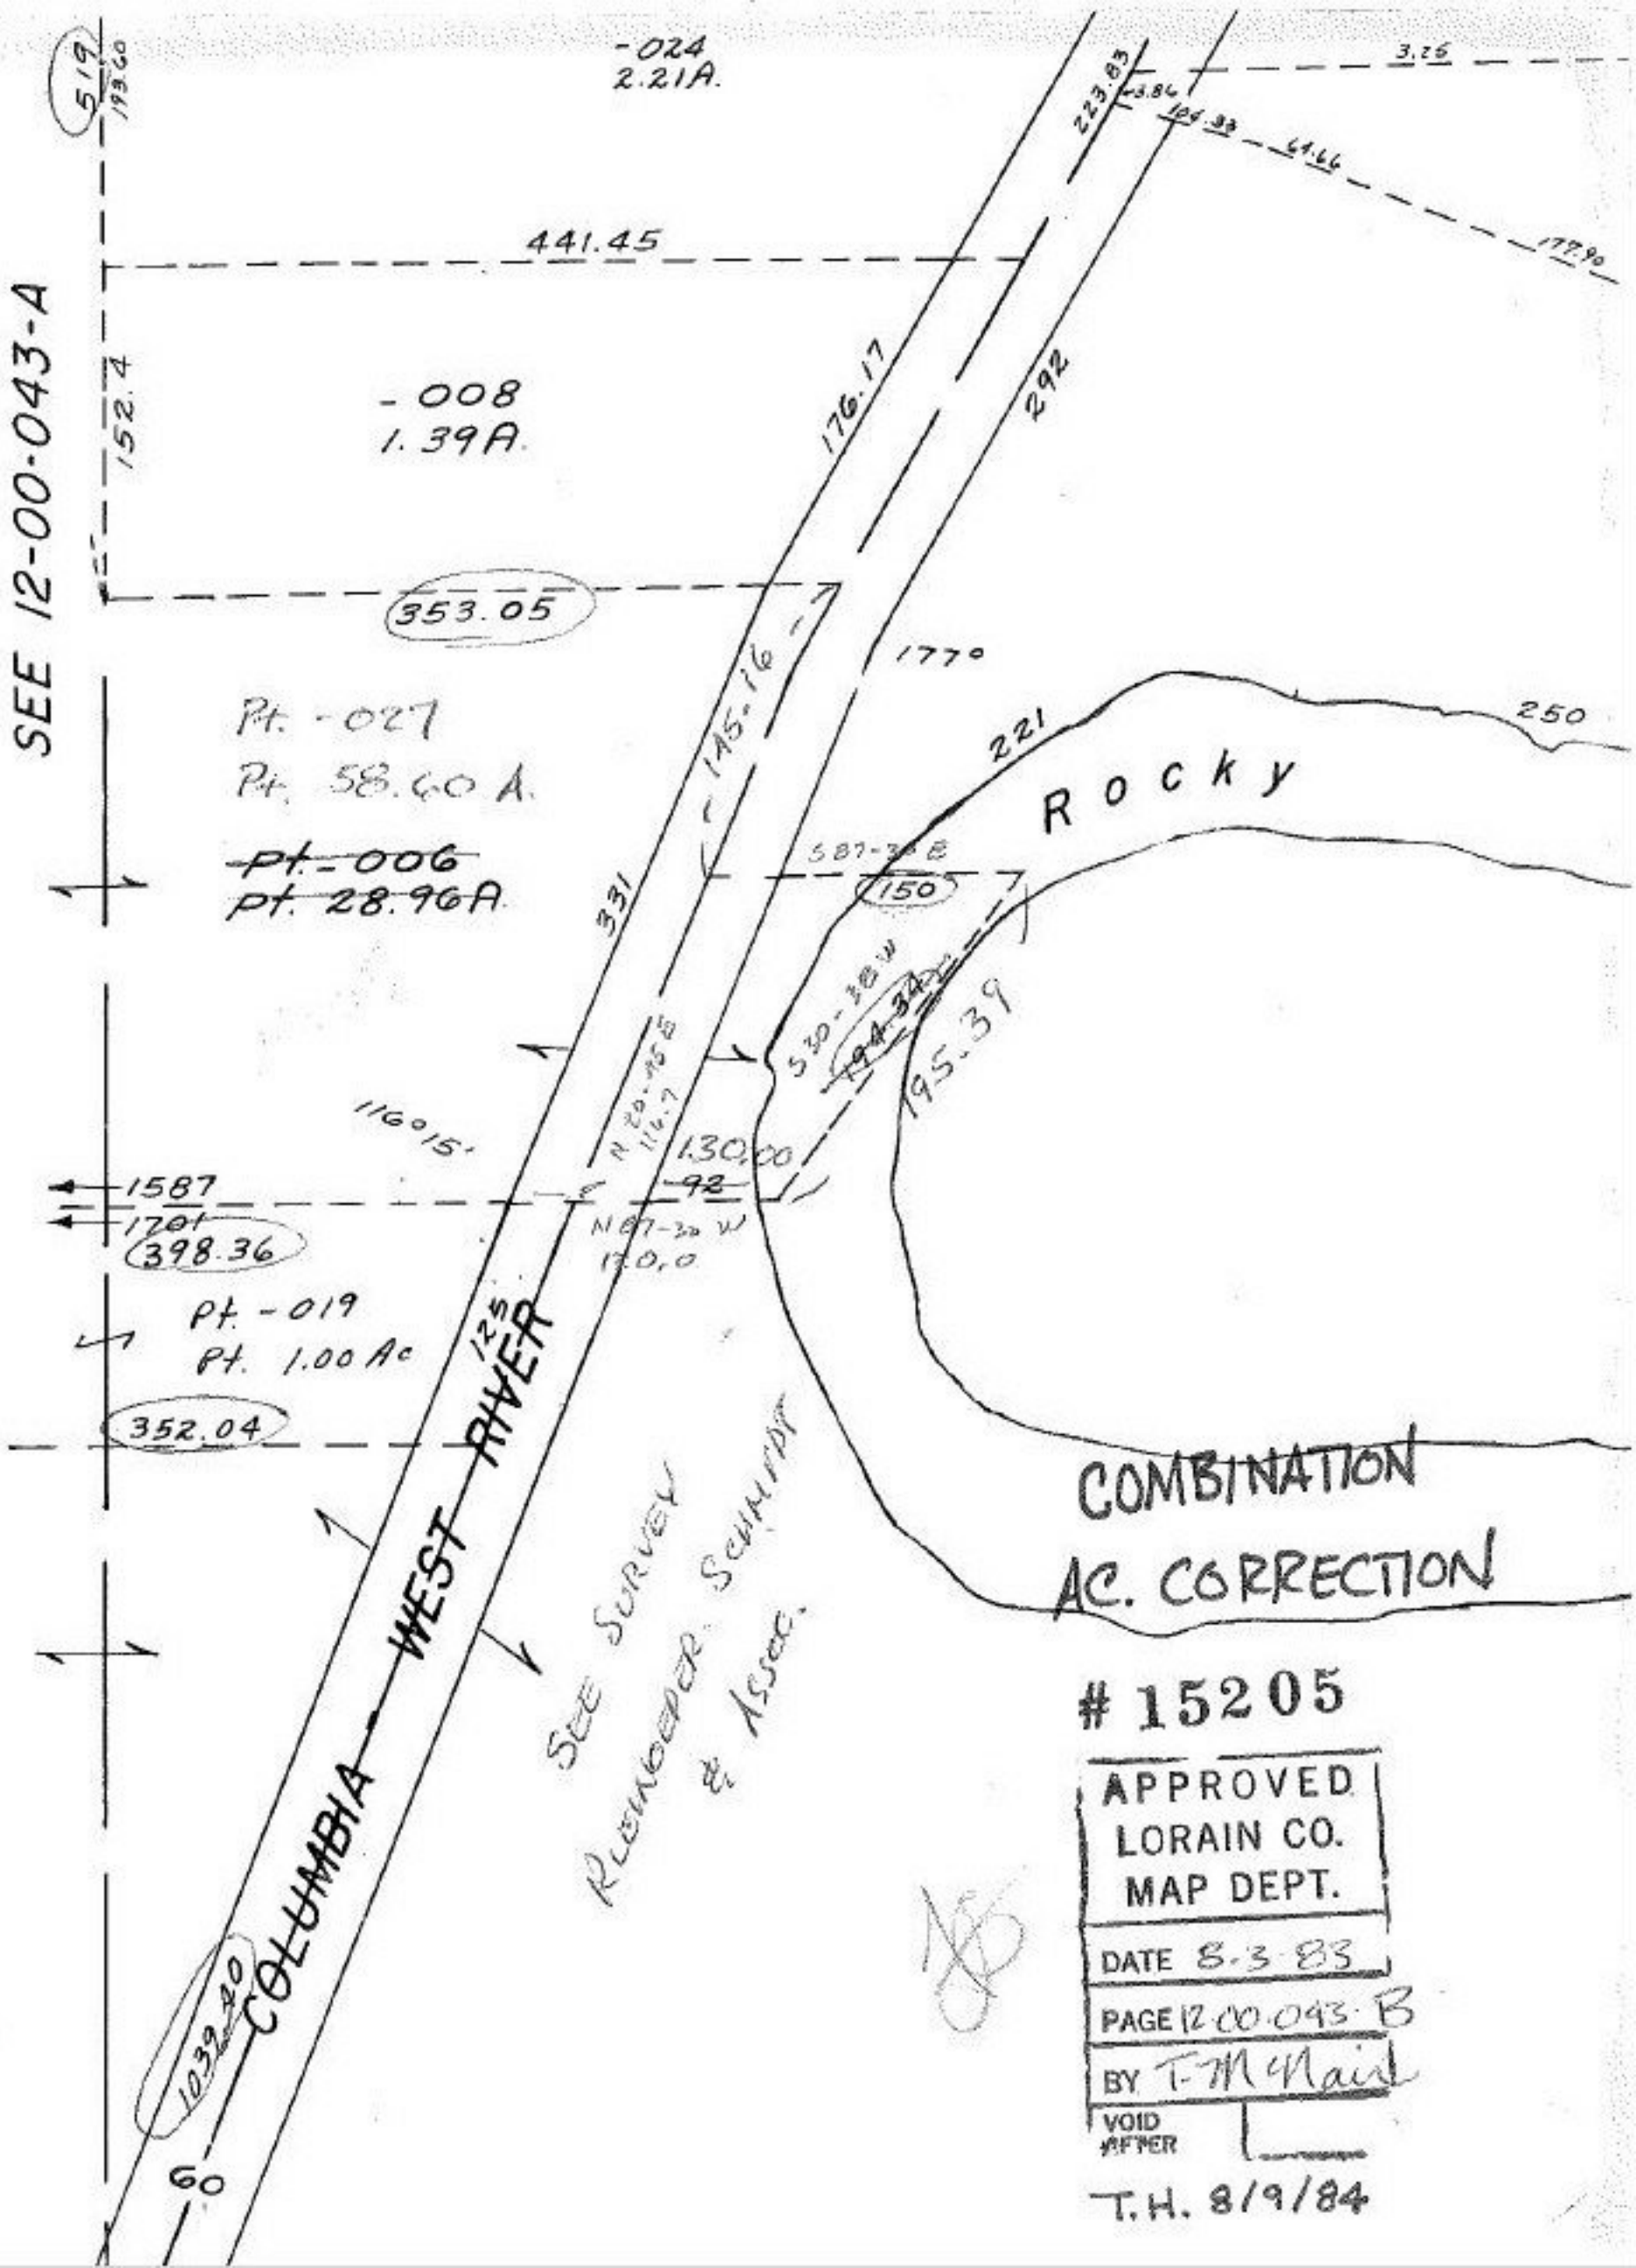

15205

APPROVED
LORAIN CO.
MAP DEPT.

DATE 8-3-83

PAGE 12-00-043-B

BY T. McNair

VOID AFTER

T.H. 8/9/84