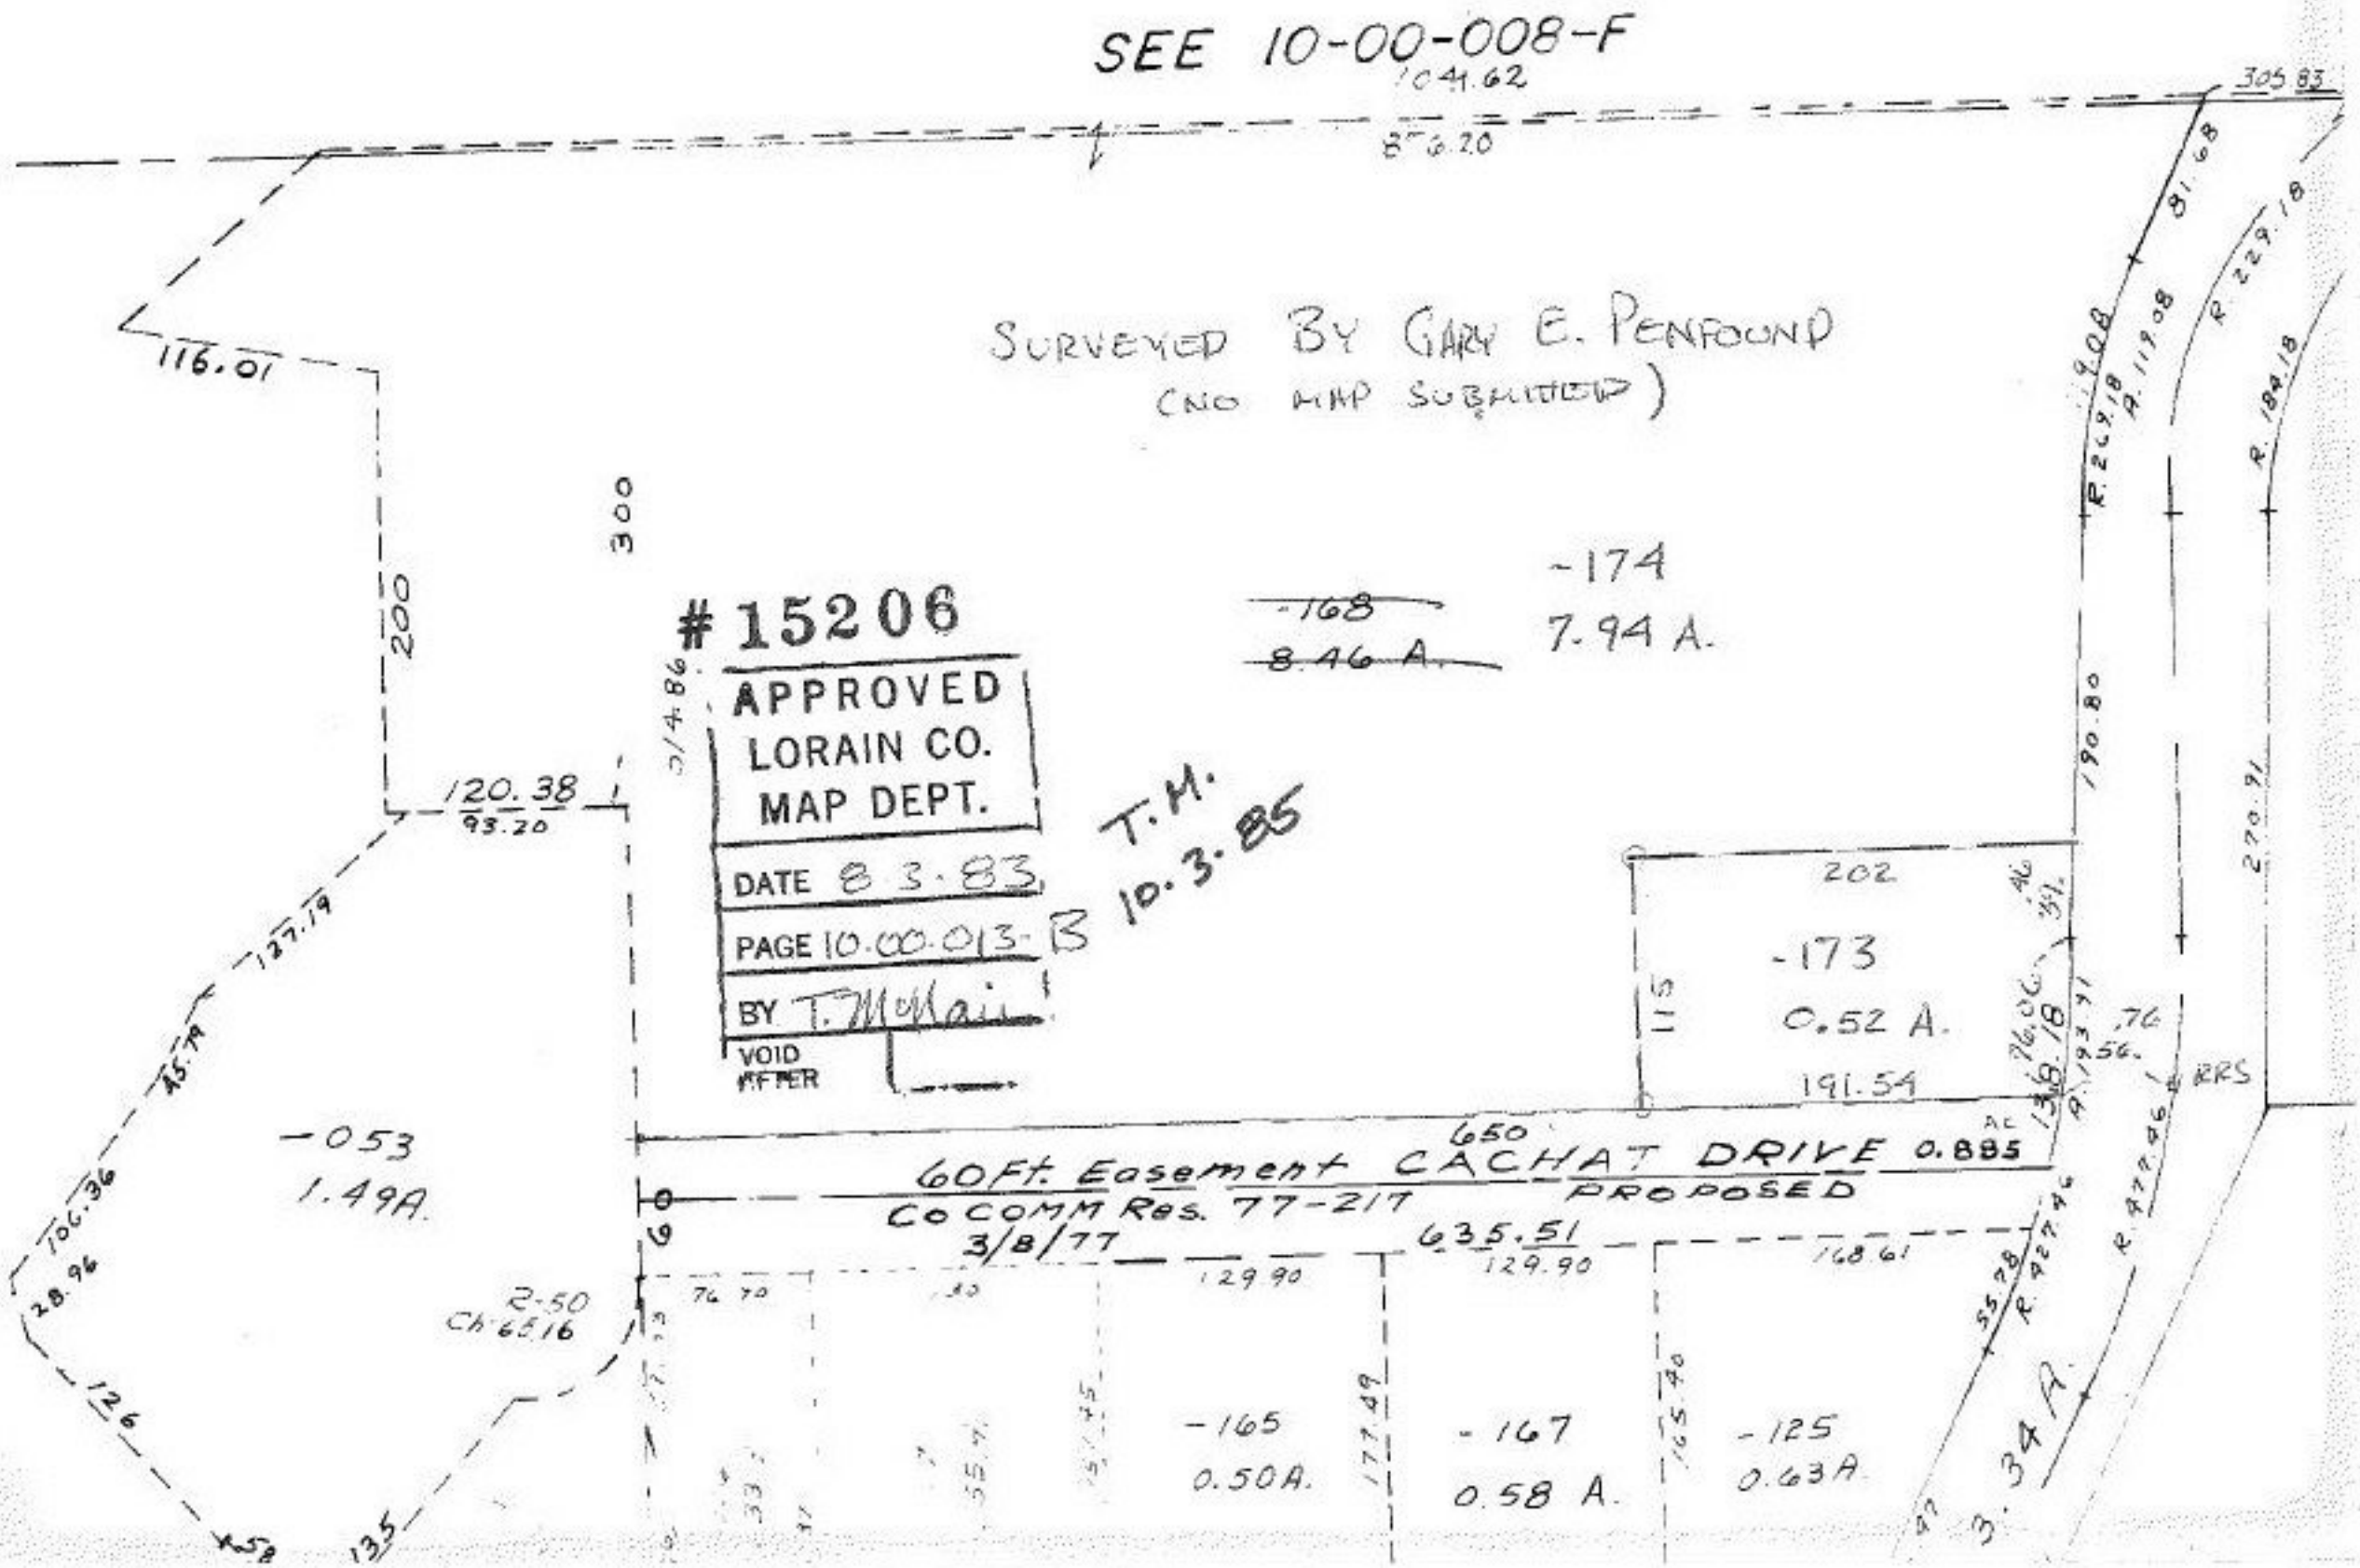
SEE 10-00-008-F
1041.62
856.20
305.83
SURVEYED BY GARY E. PENFOUND
(NO MAP SUBMITTED)
116.01
300
200
#15206
APPROVED
LORAIN CO.
MAP DEPT.
DATE 8.3.83
PAGE 10.00.013-B
BY T. McNair
VOID
AFTER
T.M.
10.3.85
-168
8.46 A.
-174
7.94 A.
120.38
93.20
127.19
45.79
106.36
28.96
126
135
-053
1.49A.
R-50
Ch 65.16
202
-173
0.52 A.
191.54
115
650
60Ft. Easement CACHAT DRIVE 0.885
PROPOSED
CoCOMM Res. 77-217
3/8/77
635.51
129.90
129.90
168.61
-165
0.50A.
-167
0.58 A.
-125
0.63A.
177.49
165.40
3.34 A.
190.80
270.91
81.68
R. 229.18
R. 184.18
R. 269.18
A. 119.08
R. 427.46
R. 477.46
RRS