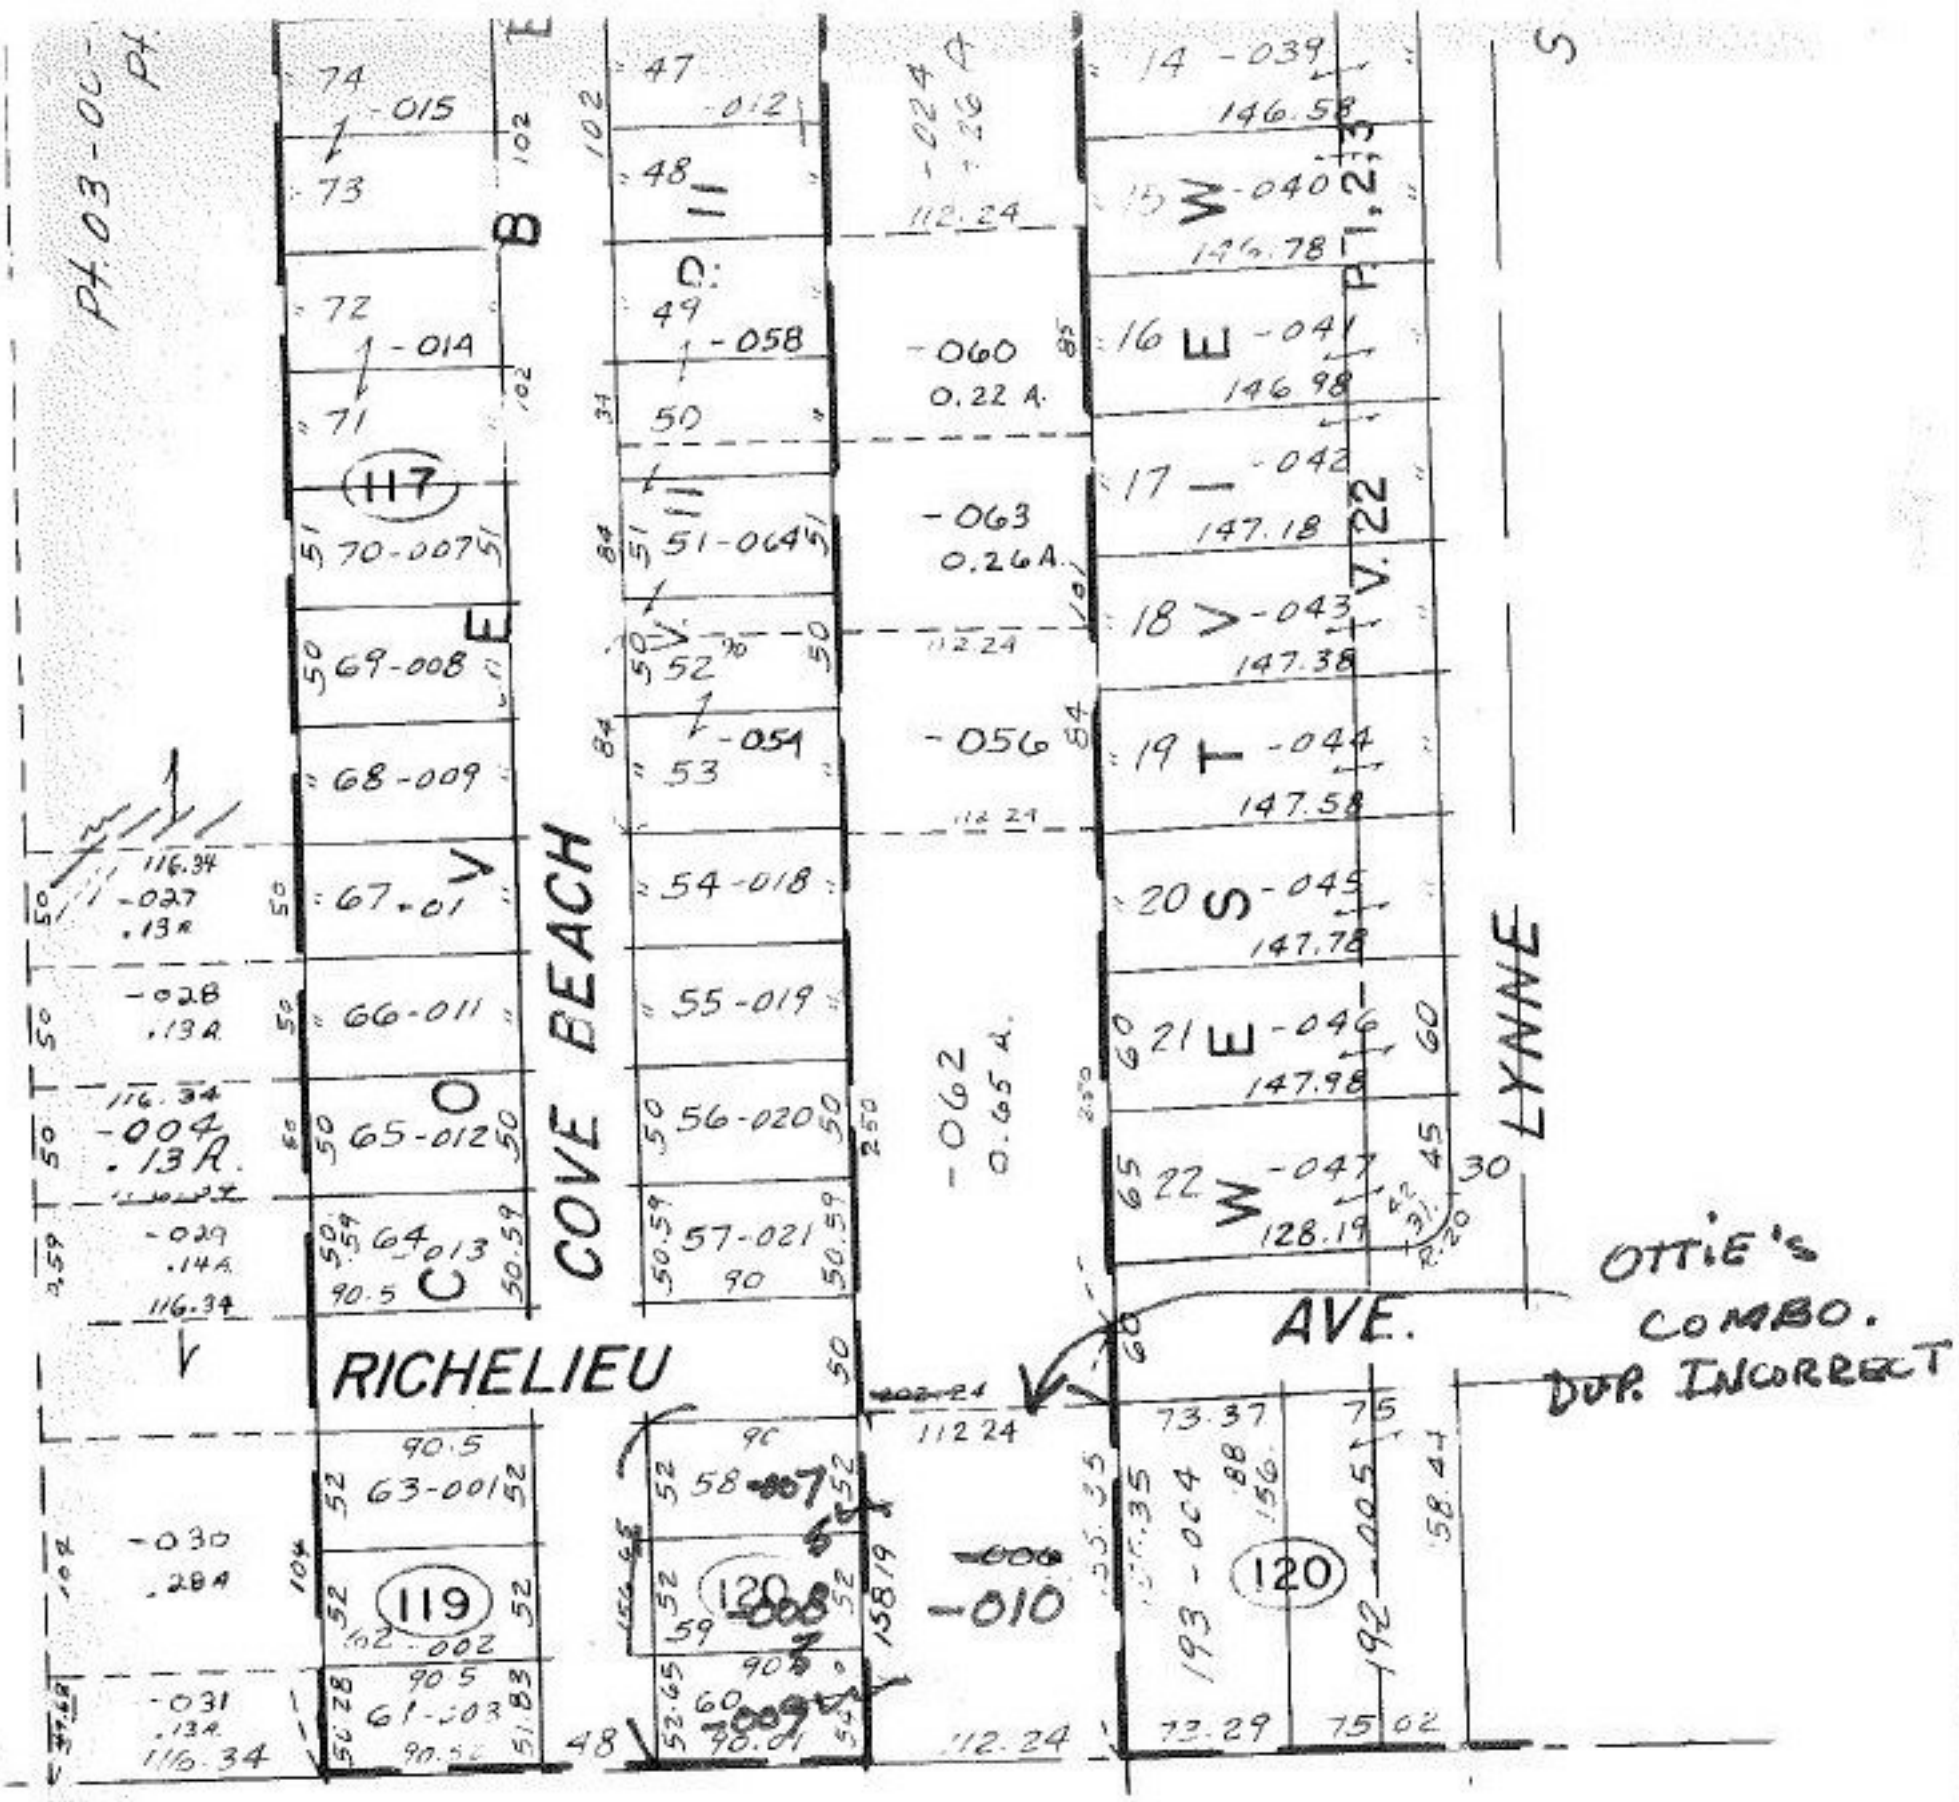


3-00-010-A

#15209

NOV 4 1983

APPROVED
LORAIN CO.
MAP DEPT.
DATE 8-8-83
PAGE 3-00-033B
BY
VOID AFTER 15209

#15209

S PT LOT 33