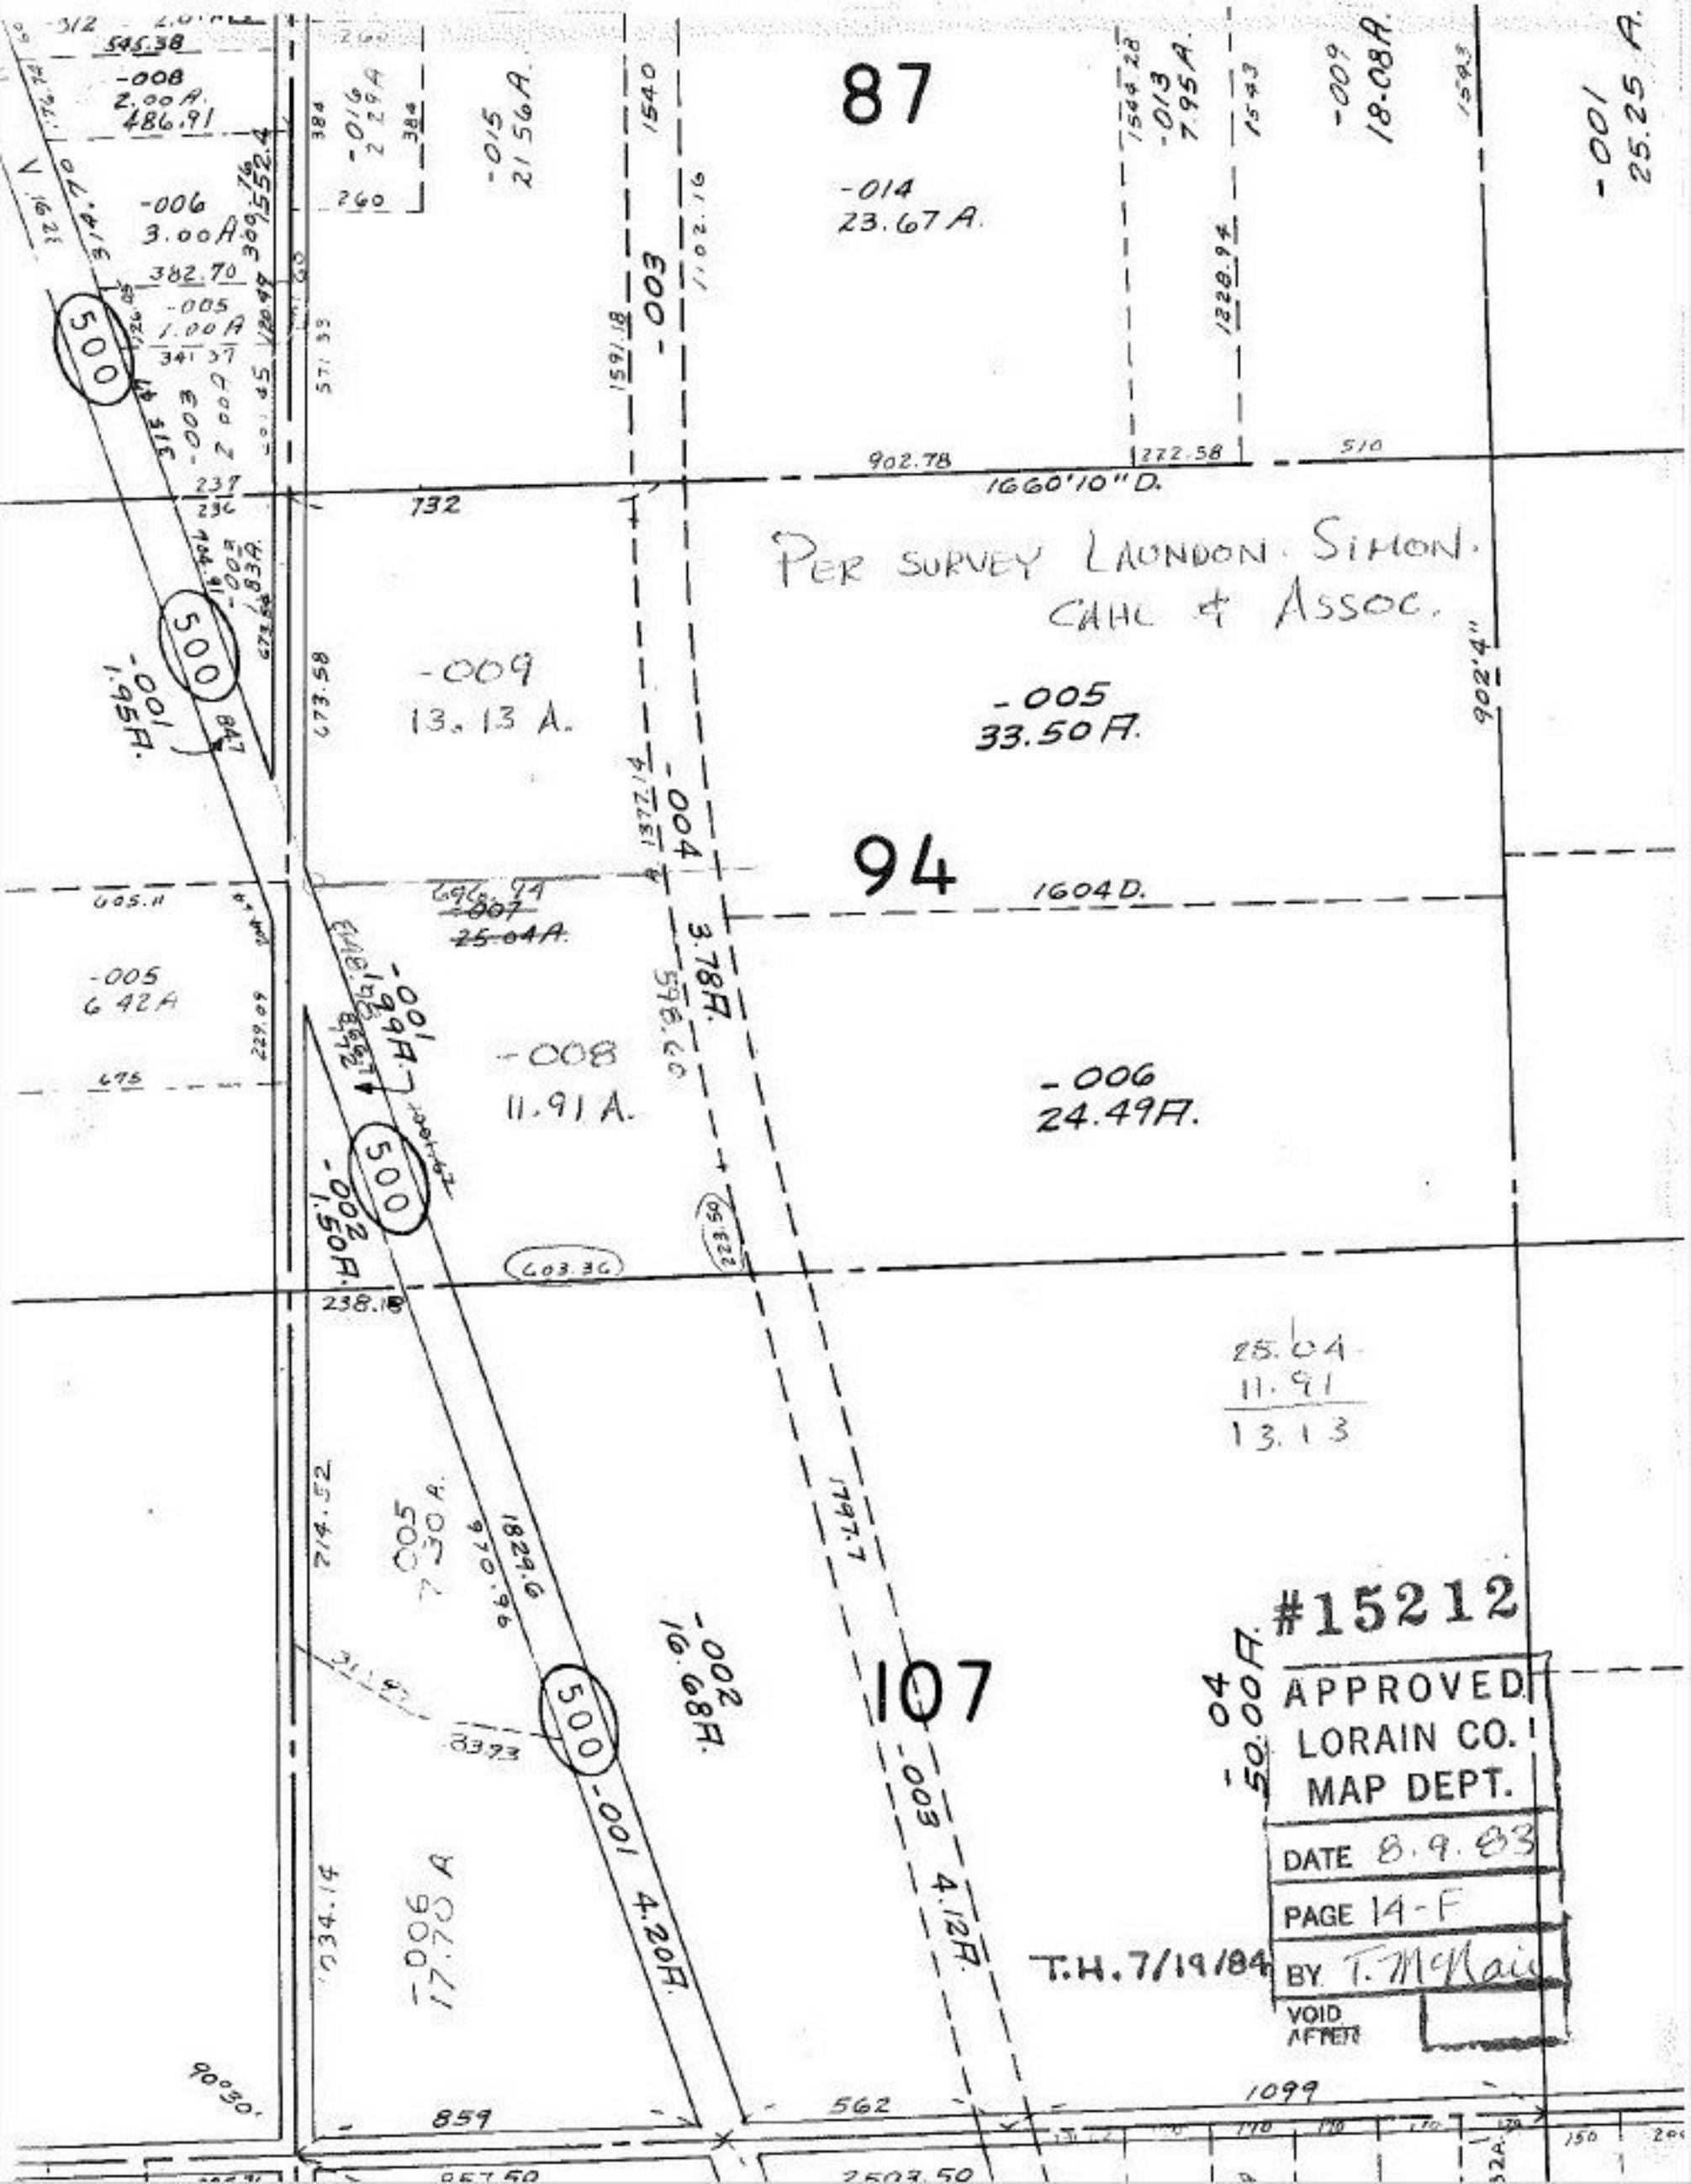
87
-014
23.67 A.
-013
7.95 A.
-009
18.08 A.
-001
25.25 A.
-008
2.00 A.
486.91
-006
3.00 A
382.70
-005
1.00 A
-015
21.56 A.
-003
902.78
1660'10" D.
PER SURVEY LAUNDON. SIMON.
CAHL & ASSOC.
-009
13.13 A.
-005
33.50 A.
-001
1.95 A.
94
1604 D.
-004
3.78 A.
-005
6.42 A
-008
11.91 A.
-006
24.49 A.
-001
1.99 A.
-002
1.50 A.
25.04
11.91
13.13
-005
7.30 A.
-002
16.68 A.
107
-003
4.12 A.
-001
4.20 A.
-006
17.70 A
-004
50.00 A.
#15212
APPROVED
LORAIN CO.
MAP DEPT.
DATE 8.9.83
PAGE 14-F
BY T. McNair
VOID
AFTER
T.H. 7/19/84
859
562
1099
2503.50