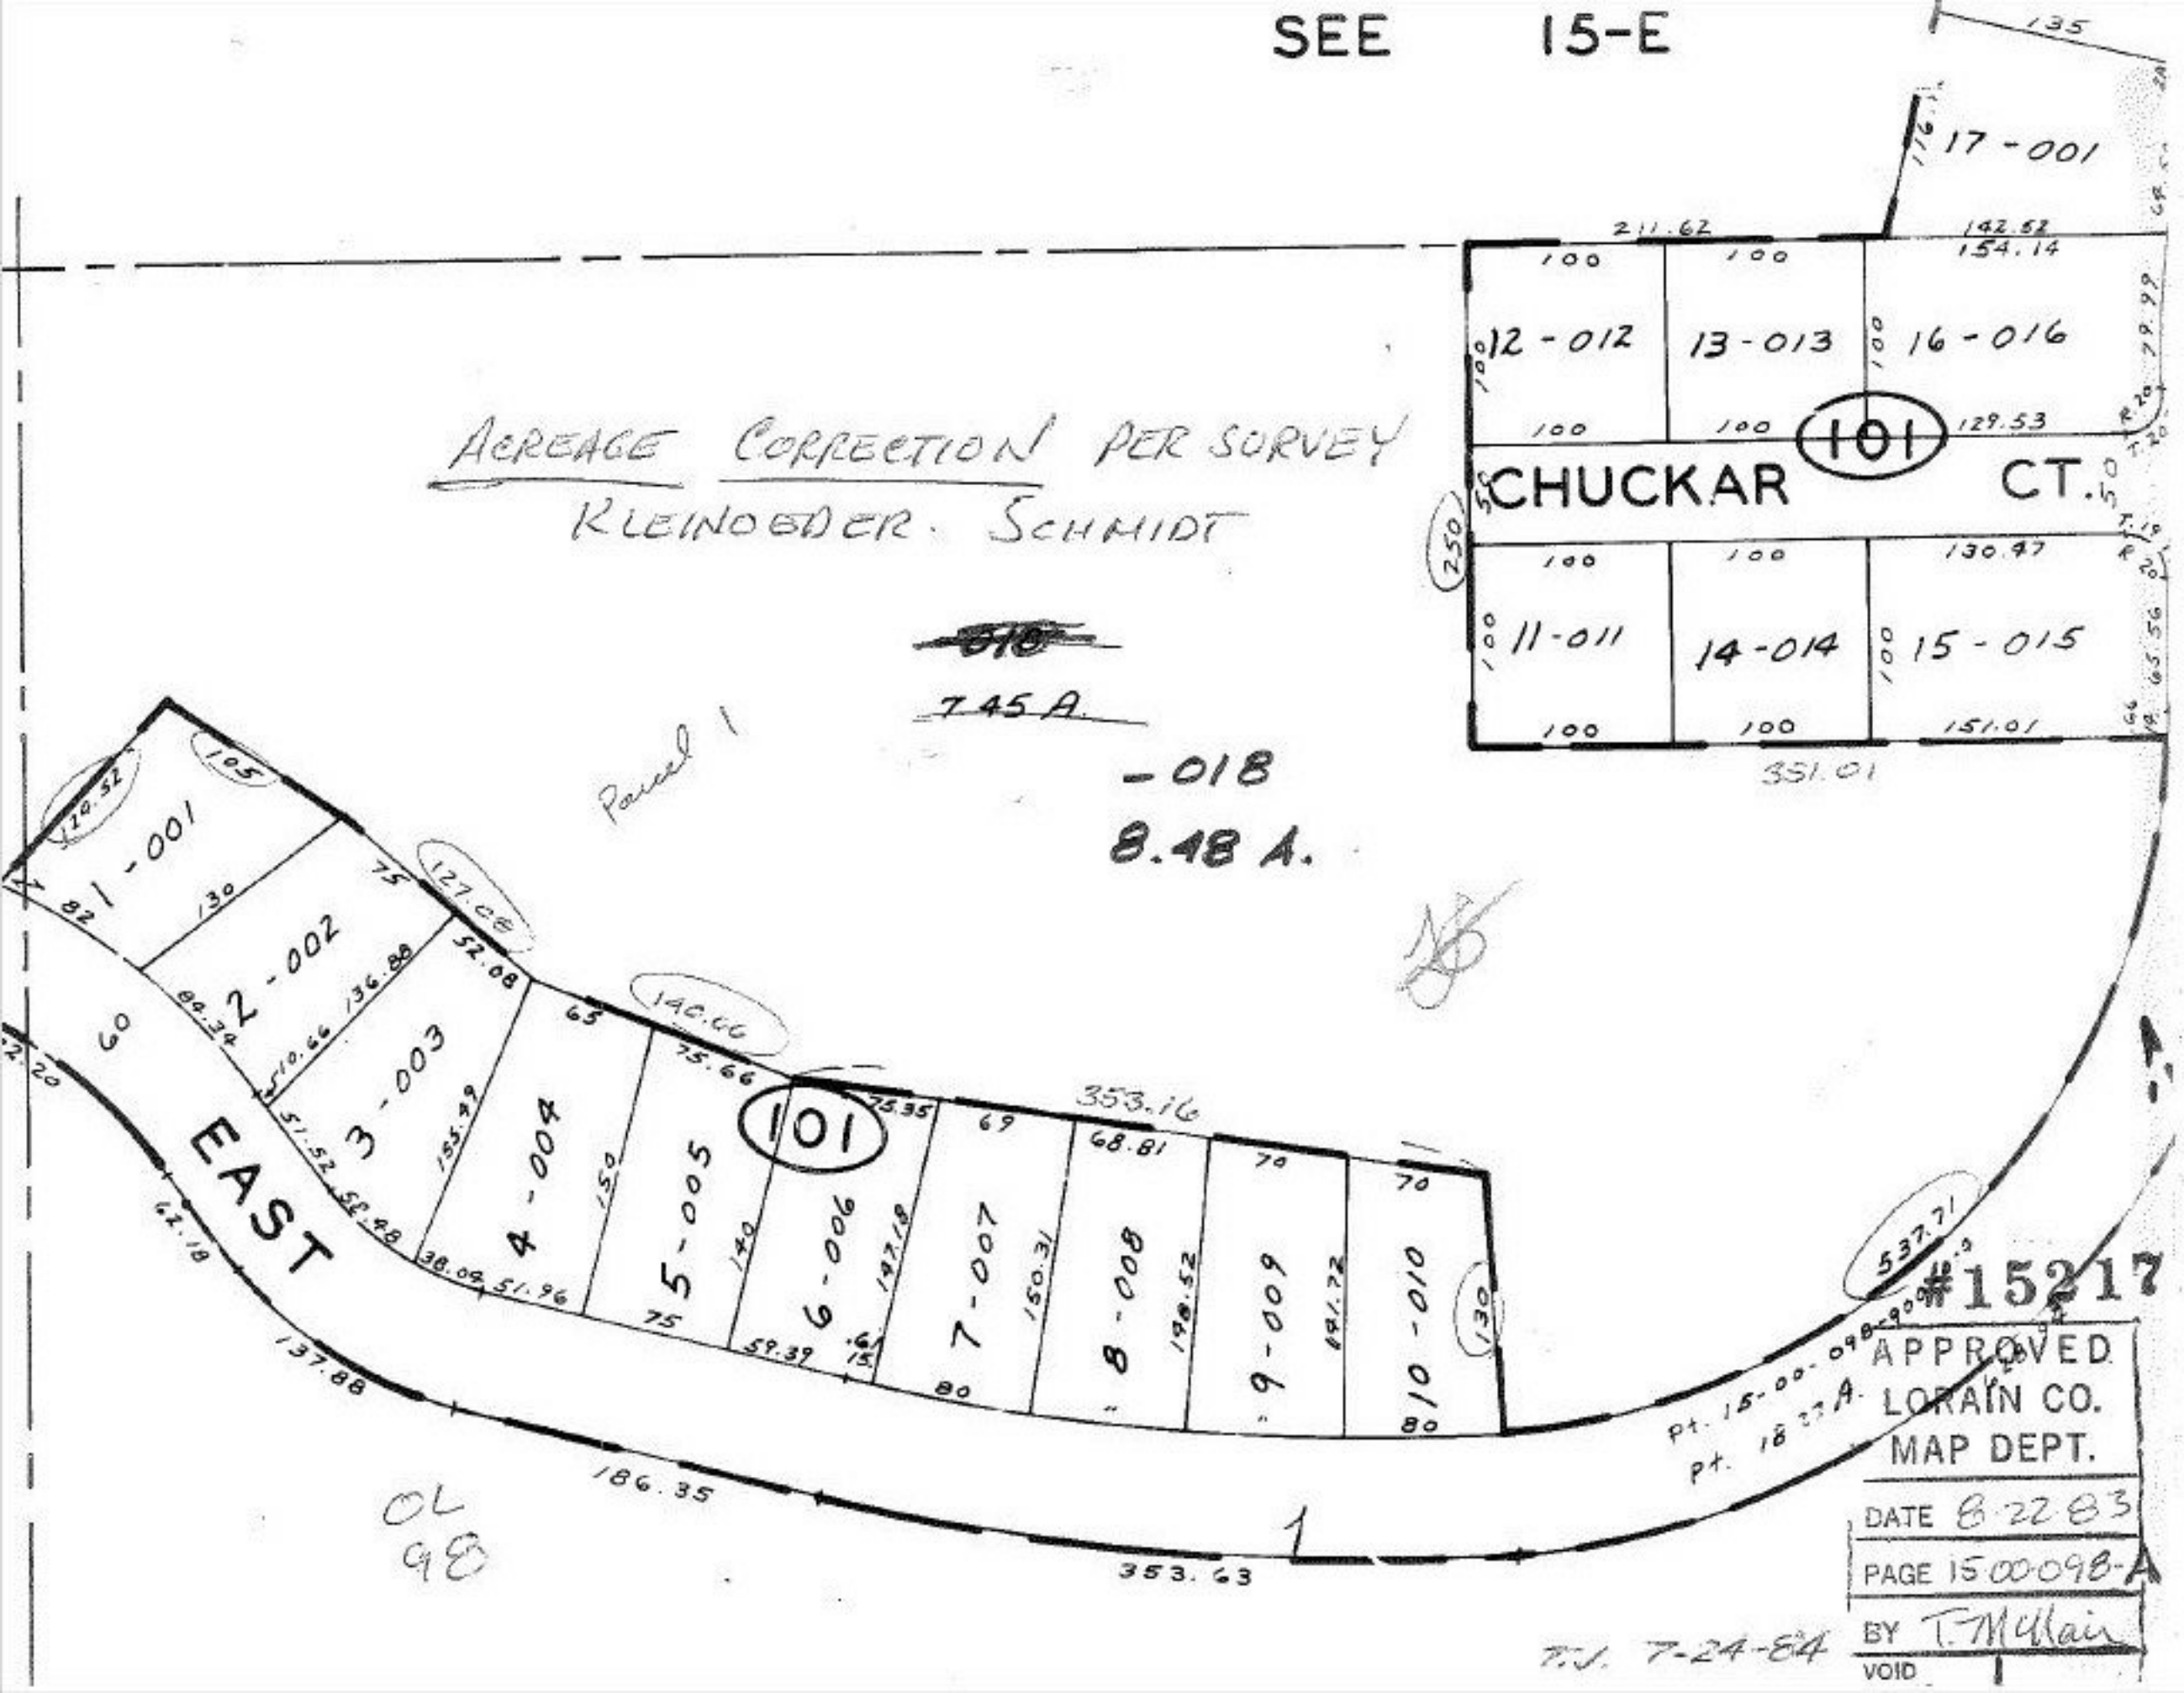
SEE 15-E
ACREAGE CORRECTION PER SURVEY
KLEINOEDER. SCHMIDT
~~010~~
7.45 A.
-018
8.48 A.
Parcel 1
17-001
12-012
13-013
16-016
101
CHUCKAR CT.
11-011
14-014
15-015
351.01
211.62
142.52
154.14
129.53
130.47
151.01
EAST
1-001
2-002
3-003
4-004
5-005
6-006
7-007
8-008
9-009
10-010
101
353.16
537.71
186.35
353.63
137.88
Pt. 15-00-098-900
Pt. 18.27 A.
OL 98
#15217
APPROVED
LORAIN CO.
MAP DEPT.
DATE 8-22-83
PAGE 15-00-098-A
BY T. McClain
VOID
T.J. 7-24-84