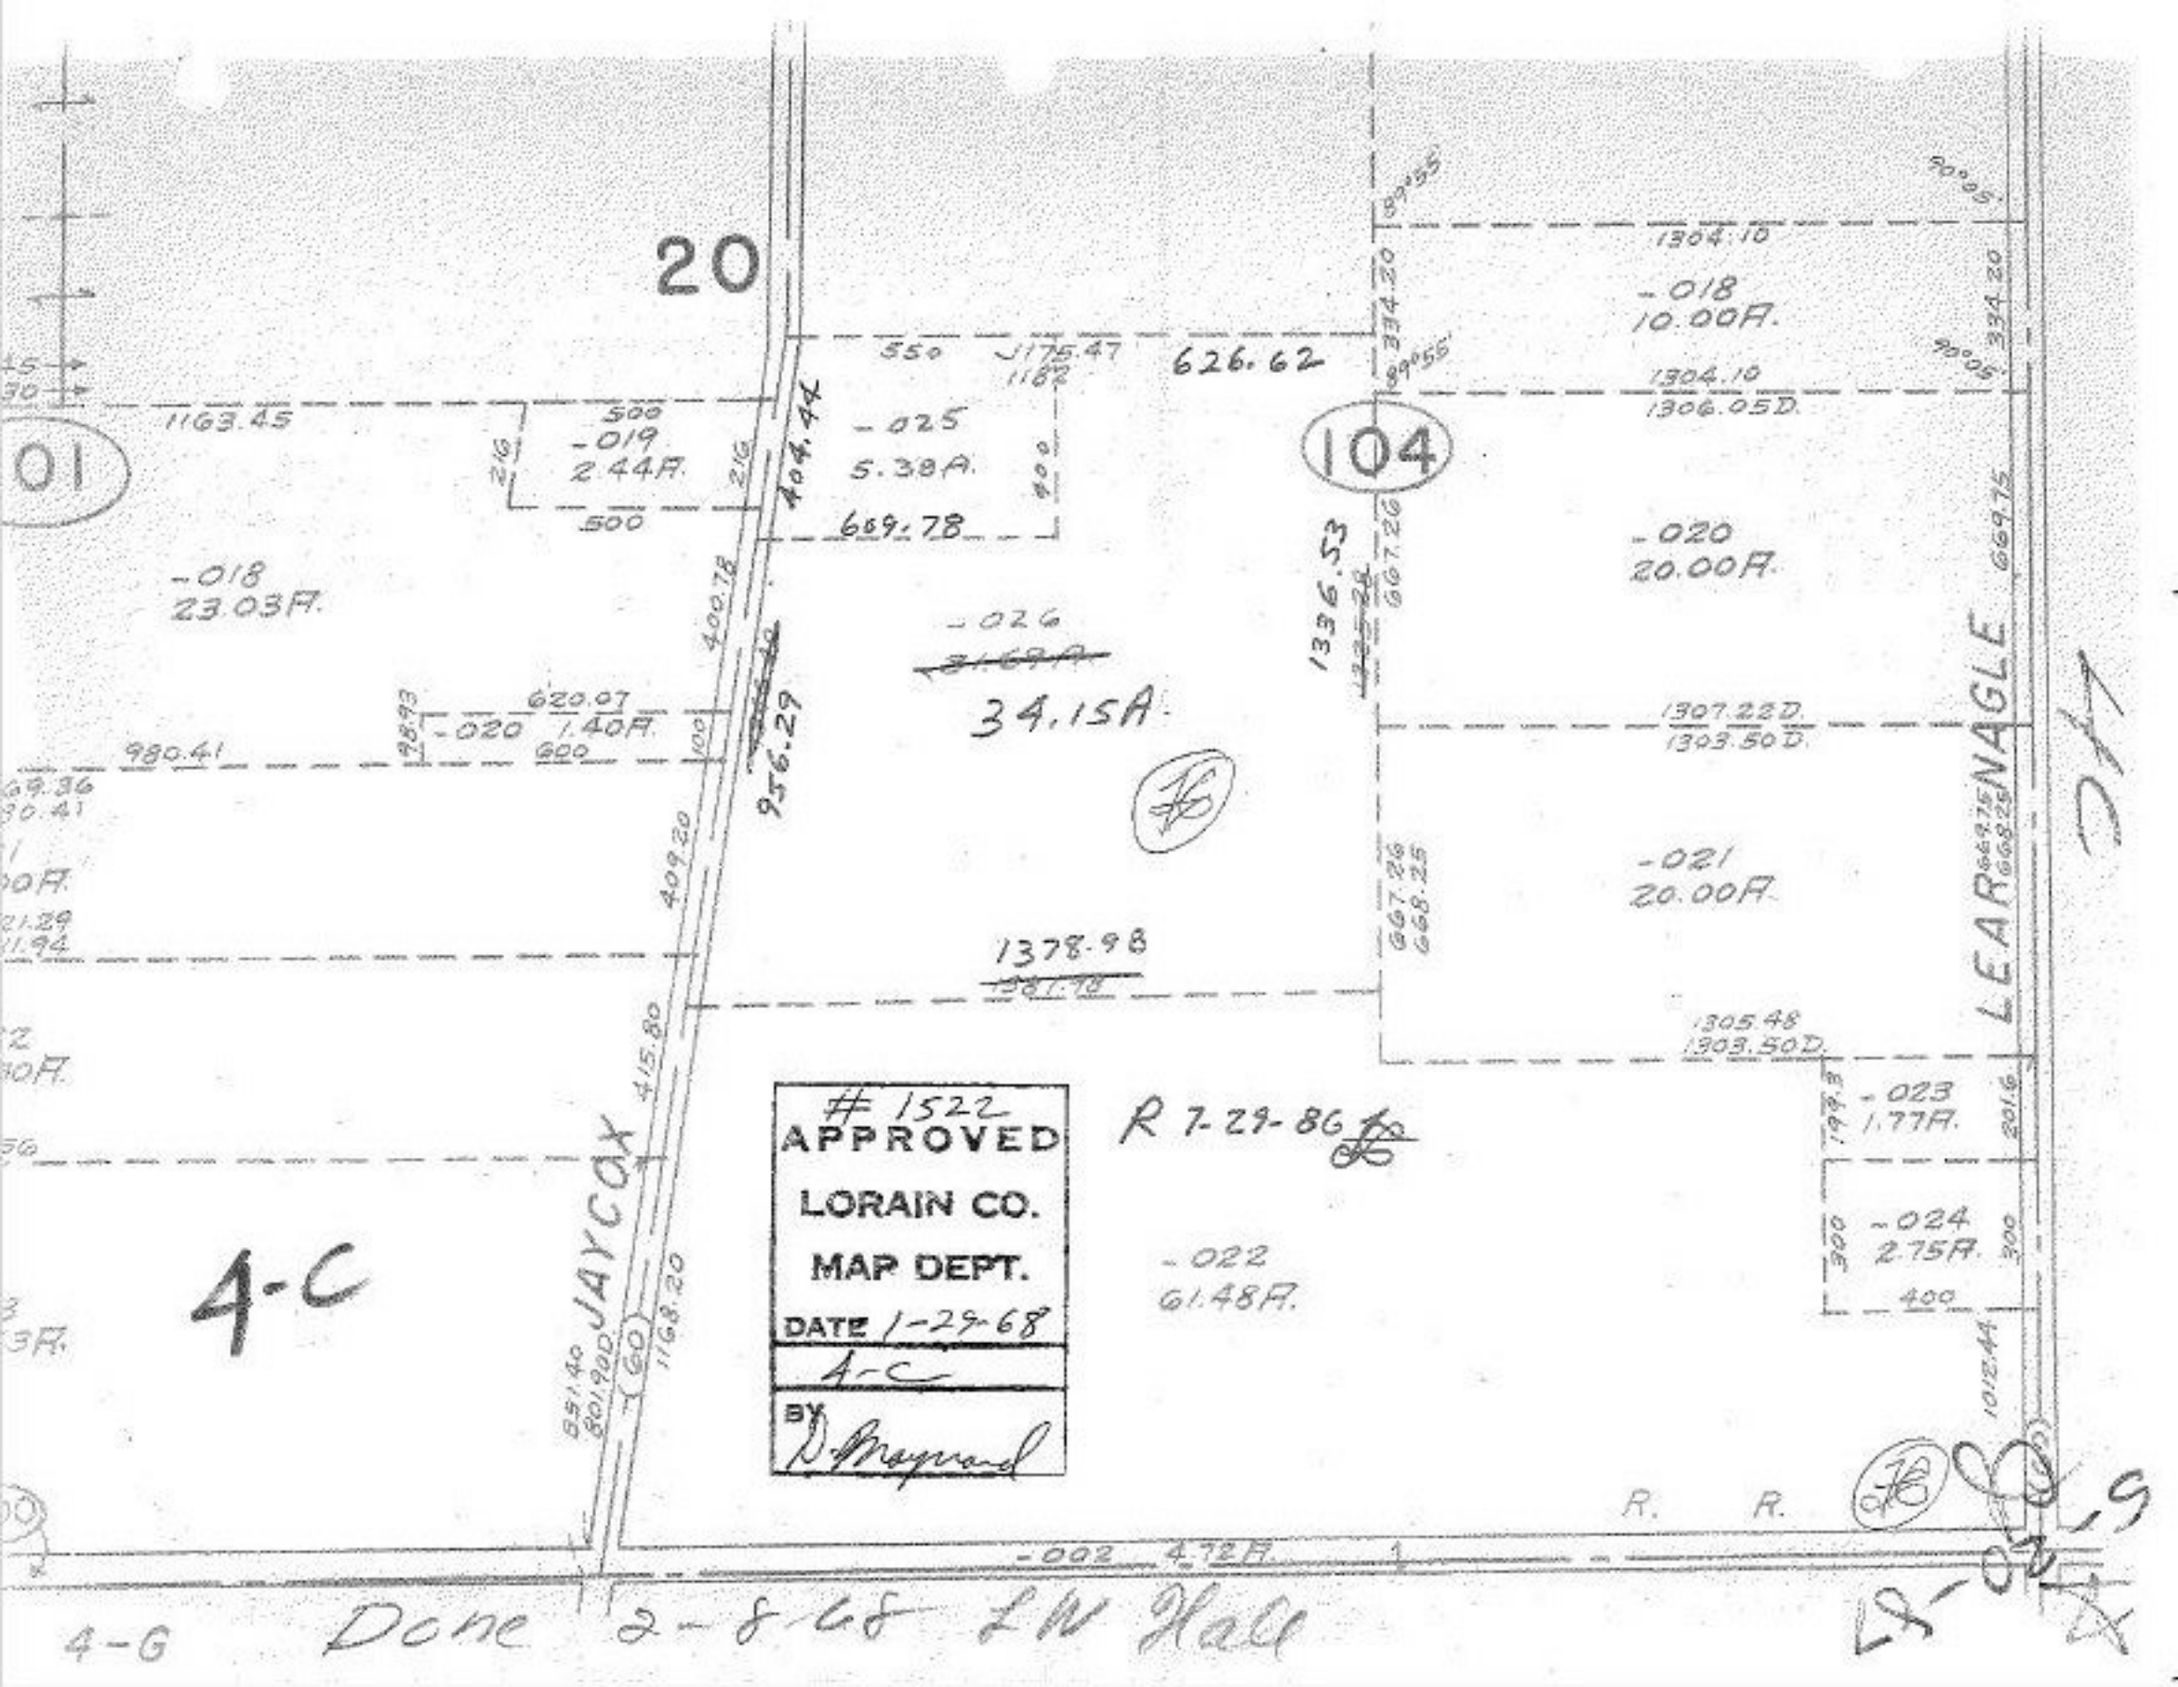
20
101
104
1163.45
500
-019
2.44A.
500
216
216
404.44
550
175.47
1182
626.62
-025
5.38A.
400
669.78
-018
23.03A.
400.78
-026
34.15A.
1336.53
667.26
-020
20.00A.
620.07
-020
1.40A.
600
980.41
98.93
100
956.29
409.20
1378.98
1381.98
415.80
JAYCOX
1168.20
851.40
801.90D
(60)
4-C
-018
10.00A.
1304.10
1304.10
1306.05D.
334.20
89°55'
90°05'
-020
20.00A.
1307.22D.
1303.50D.
-021
20.00A.
667.26
668.25
1305.48
1303.50D.
LEAR NAGLE
669.75
668.25
-023
1.77A.
199.3
201.6
-024
2.75A.
300
400
1012.44
R. R.
-002 4.72A.
4-G
Done 2-8-68 LW Hall
1522
APPROVED
LORAIN CO.
MAP DEPT.
DATE 1-29-68
4-C
BY D. Maynard
R 7-29-86
-022
61.48A.
4-C