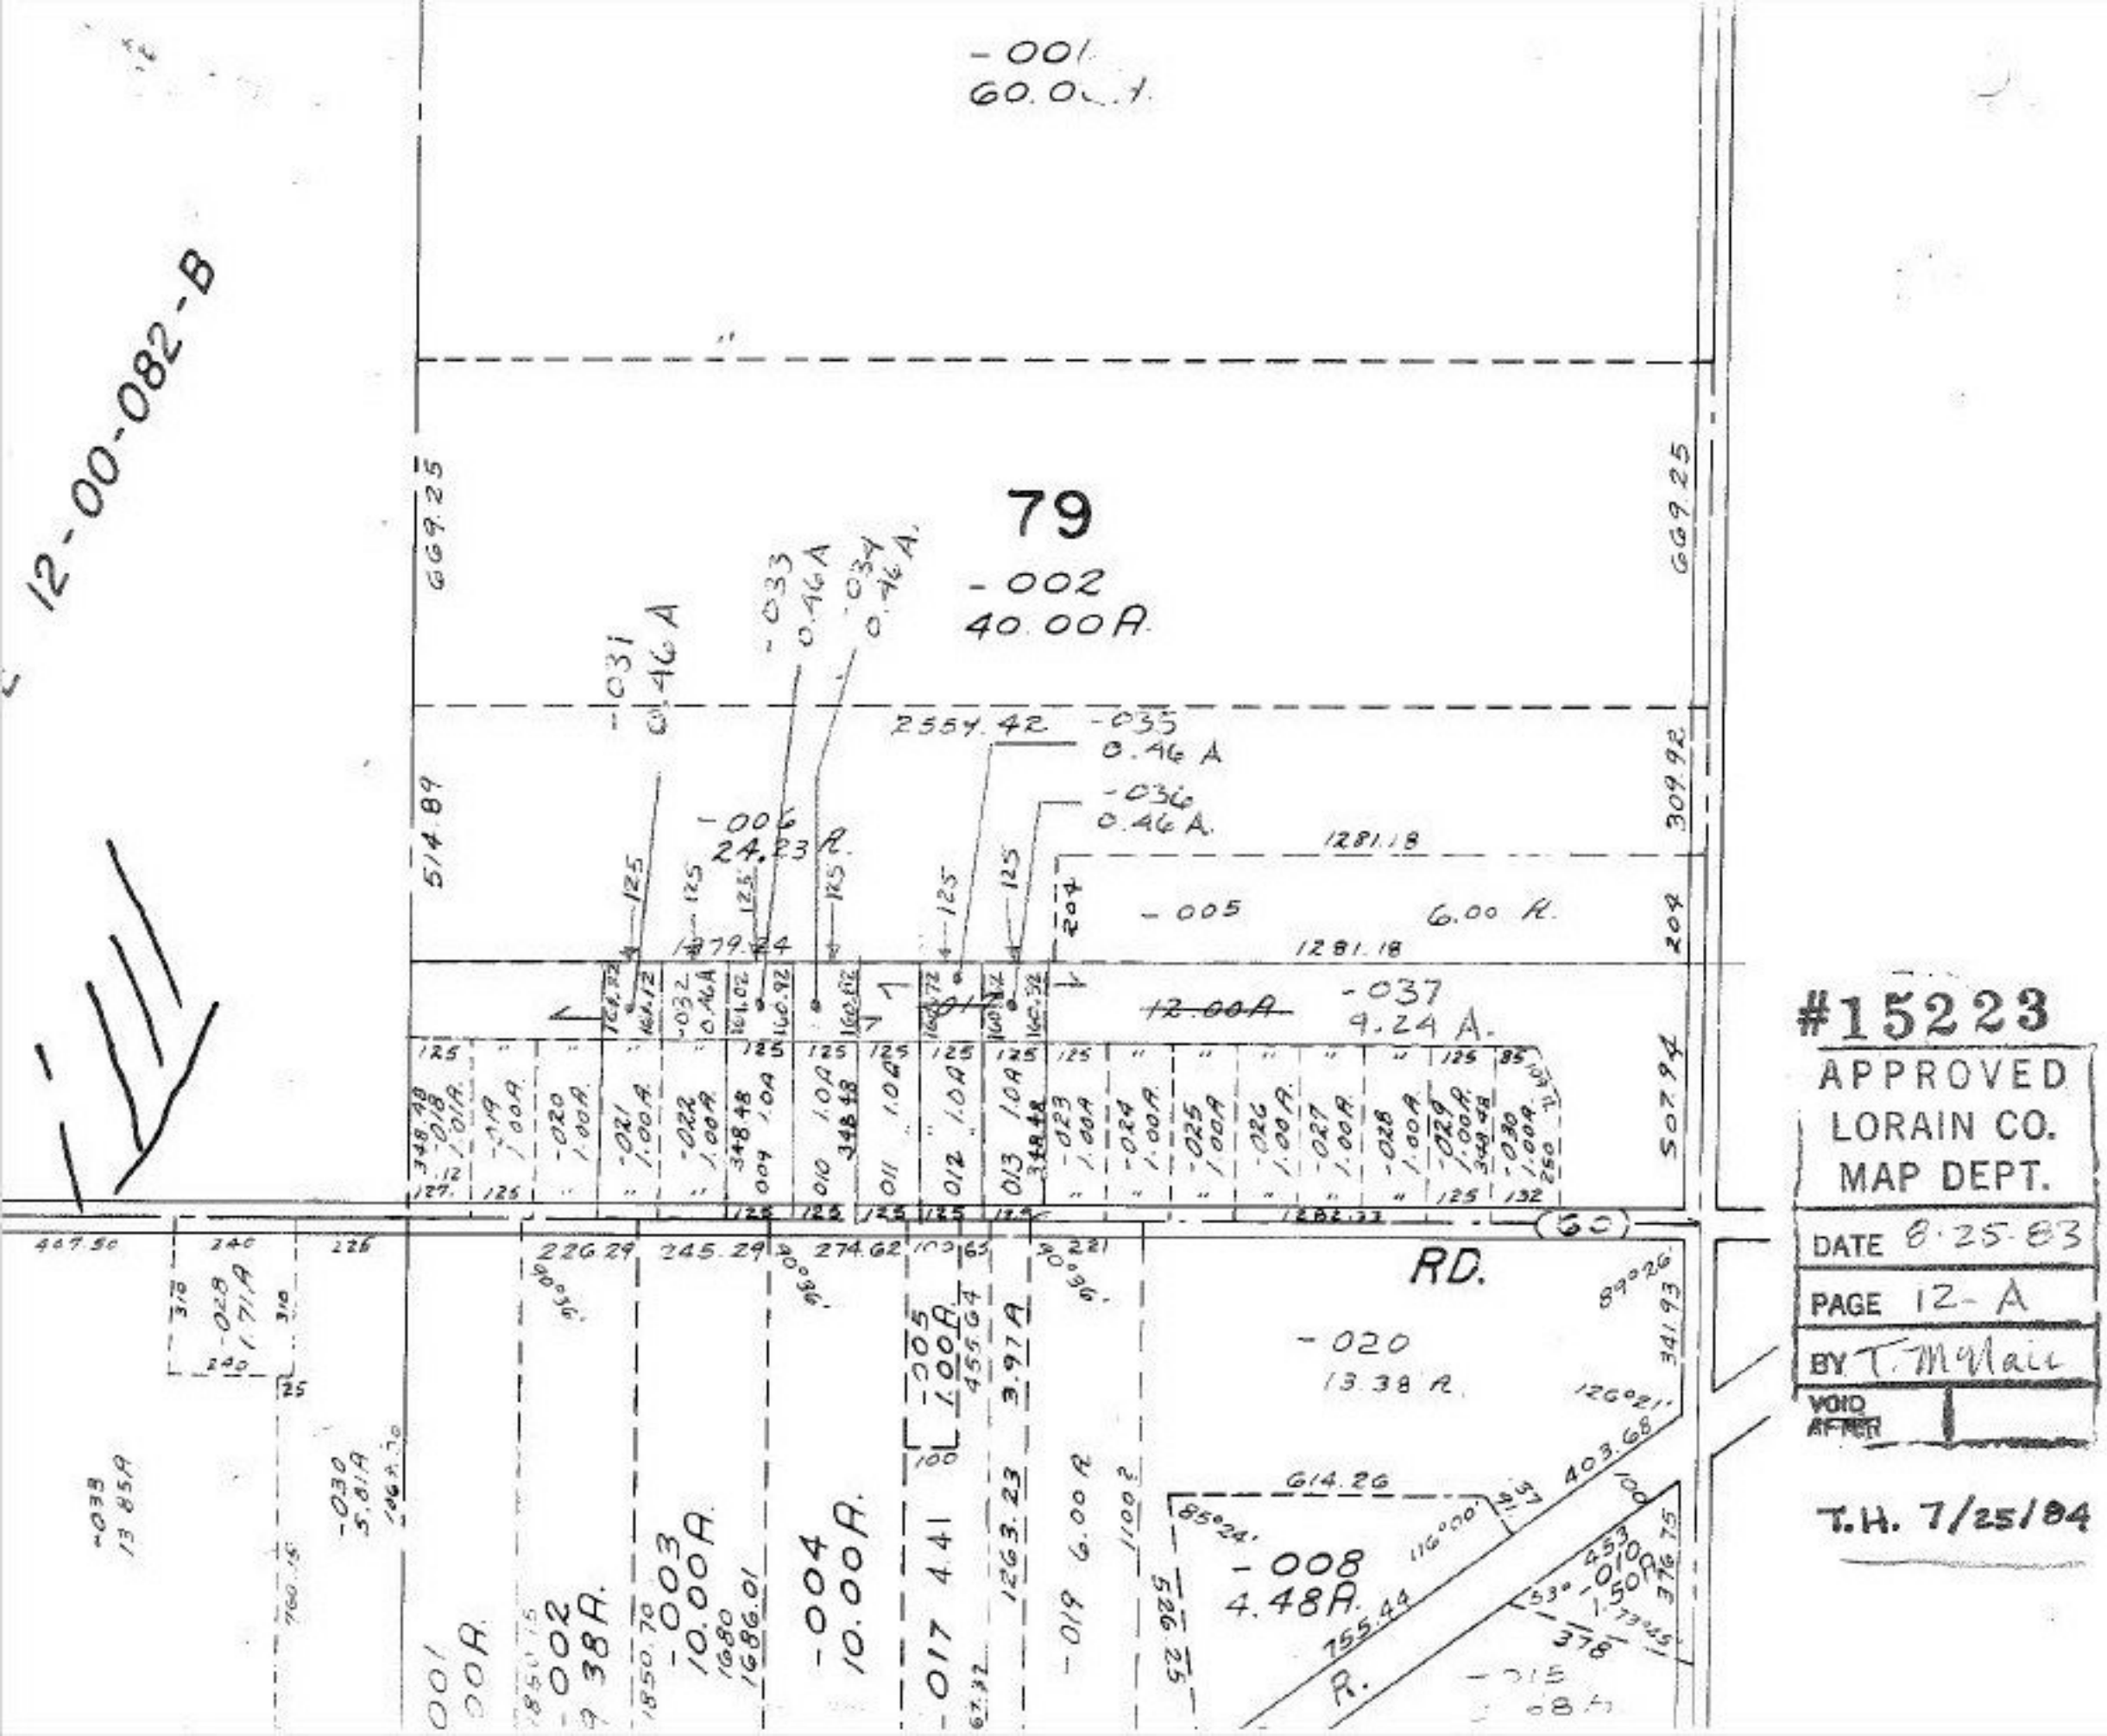

#15223

APPROVED
LORAIN CO.
MAP DEPT.

DATE 8-25-83

PAGE 12-A

BY T. McNair

VOID AFTER

T.H. 7/25/84