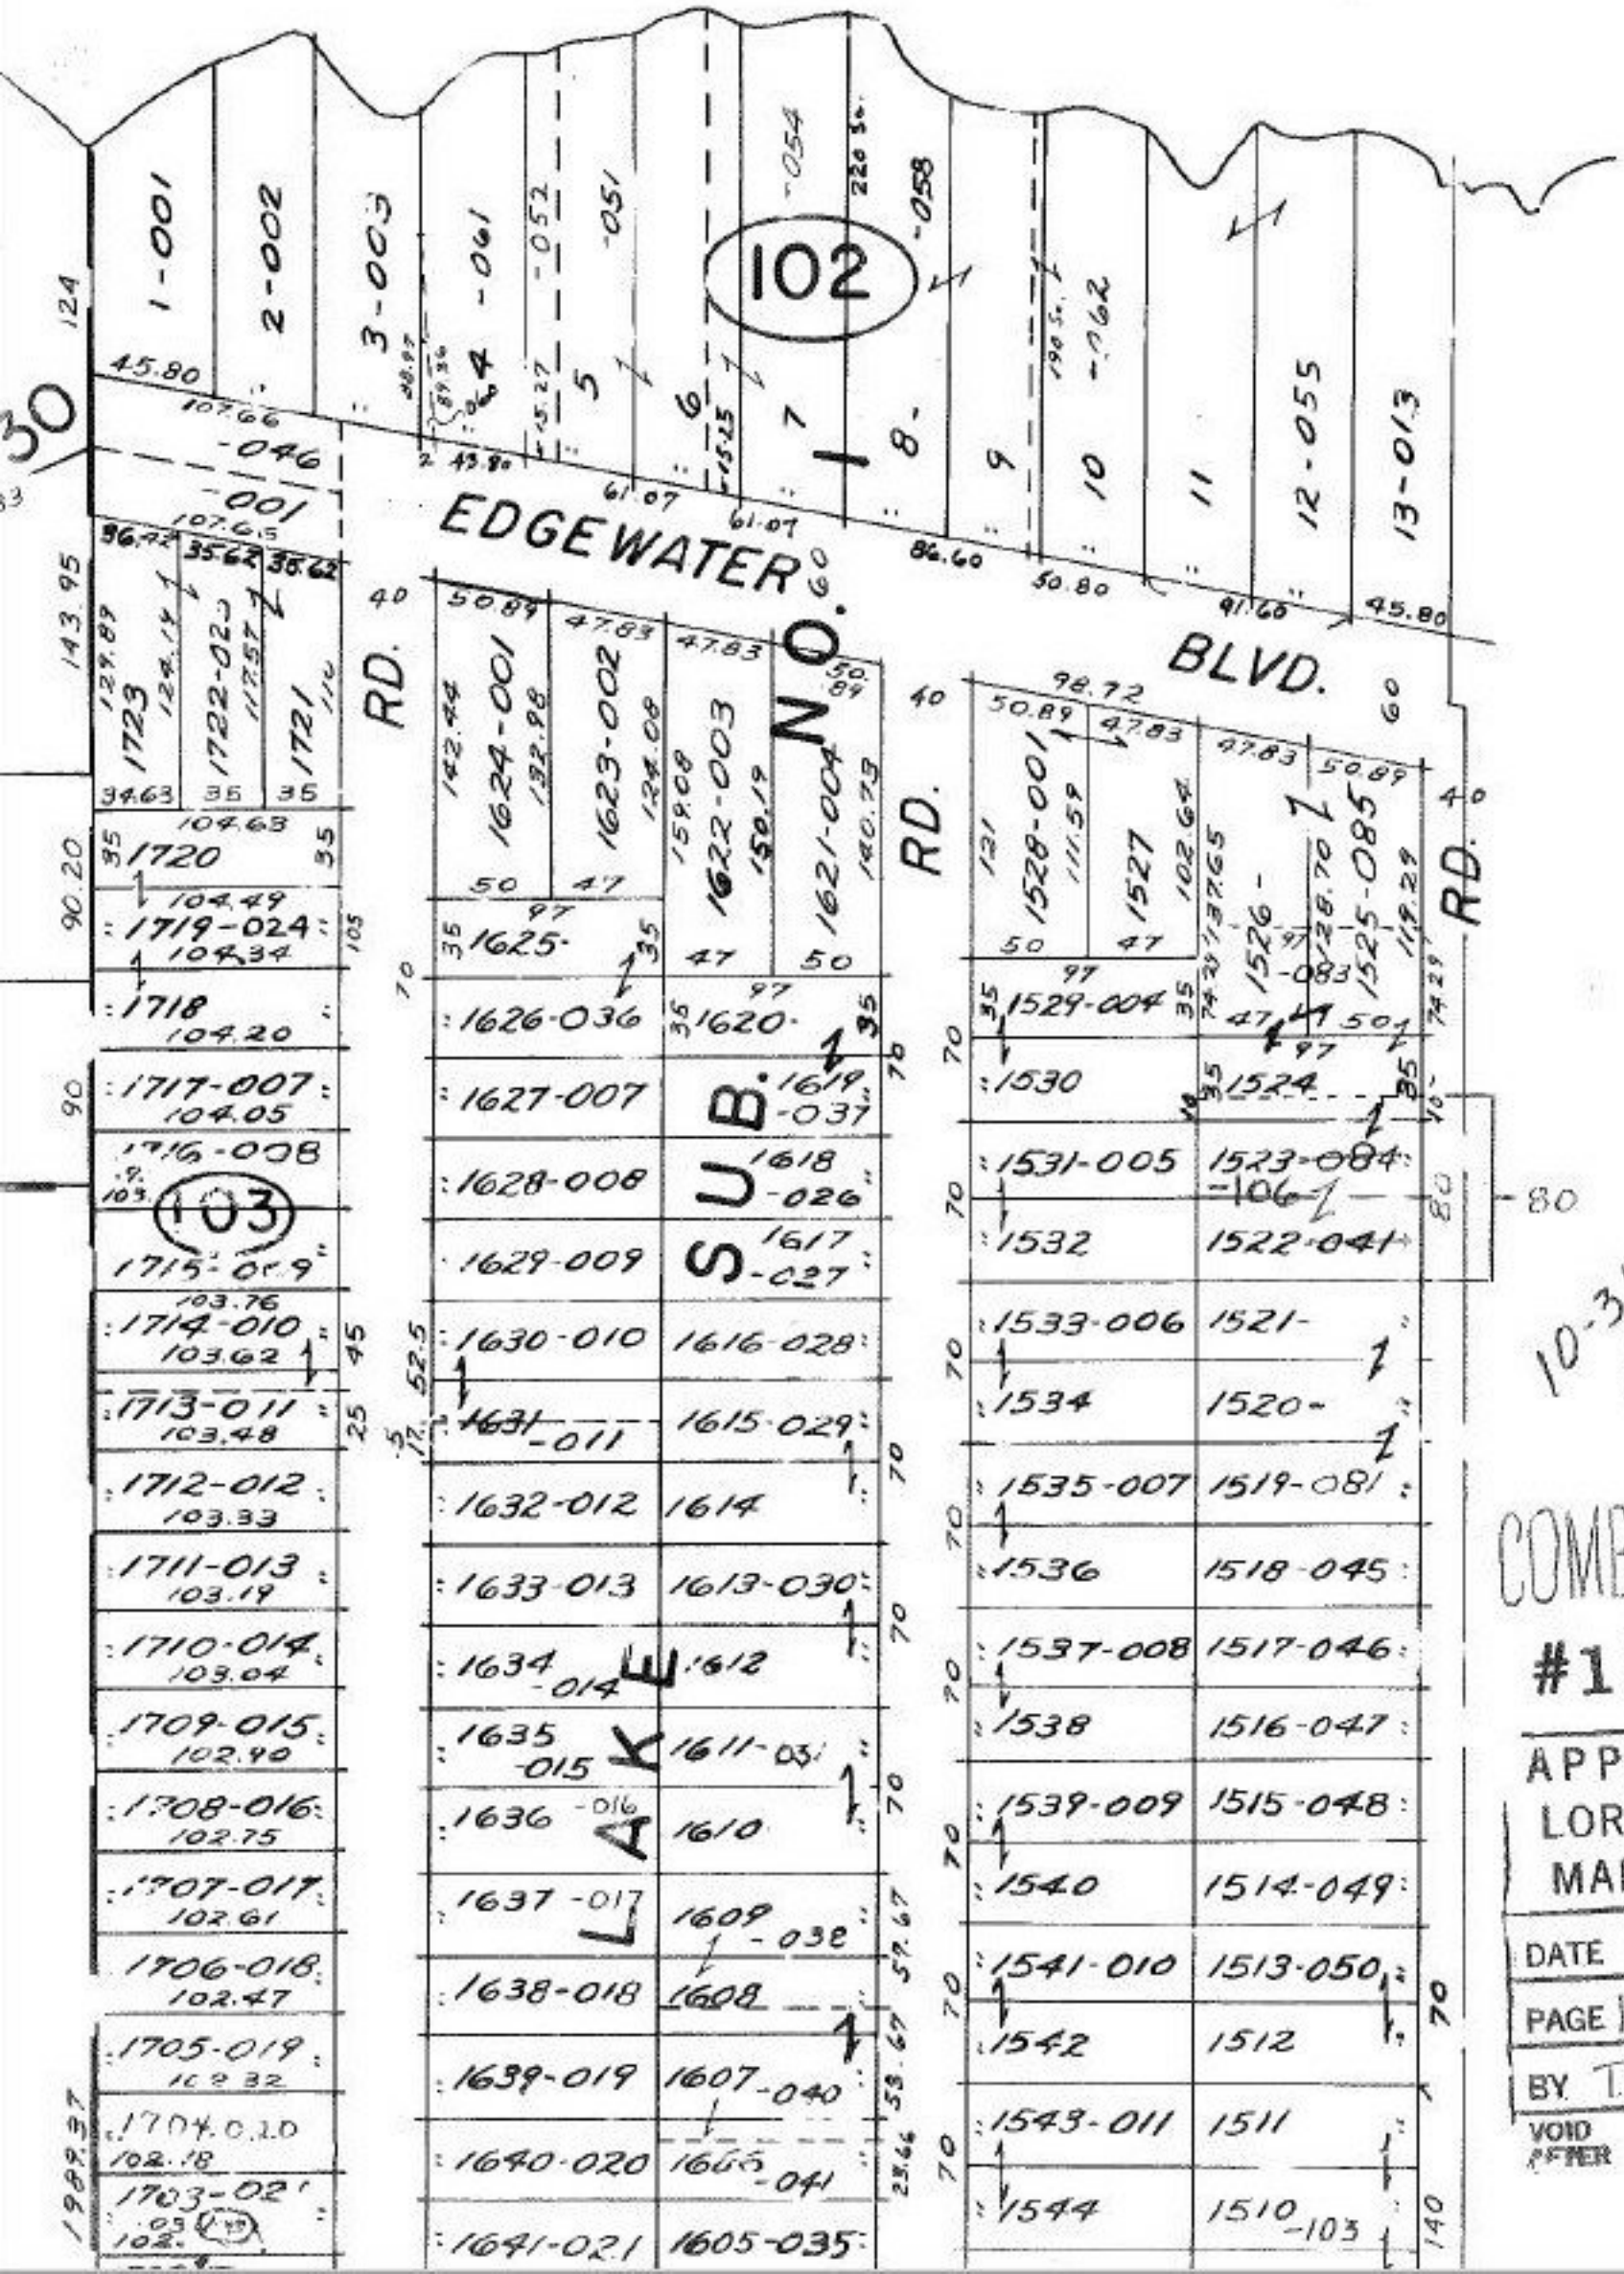

10-31-83

COMBINATION

#15227

APPROVED
LORAIN CO.
MAP DEPT.

DATE 8.26.83

PAGE 1.00.002.A

BY T. McNair

VOID AFTER