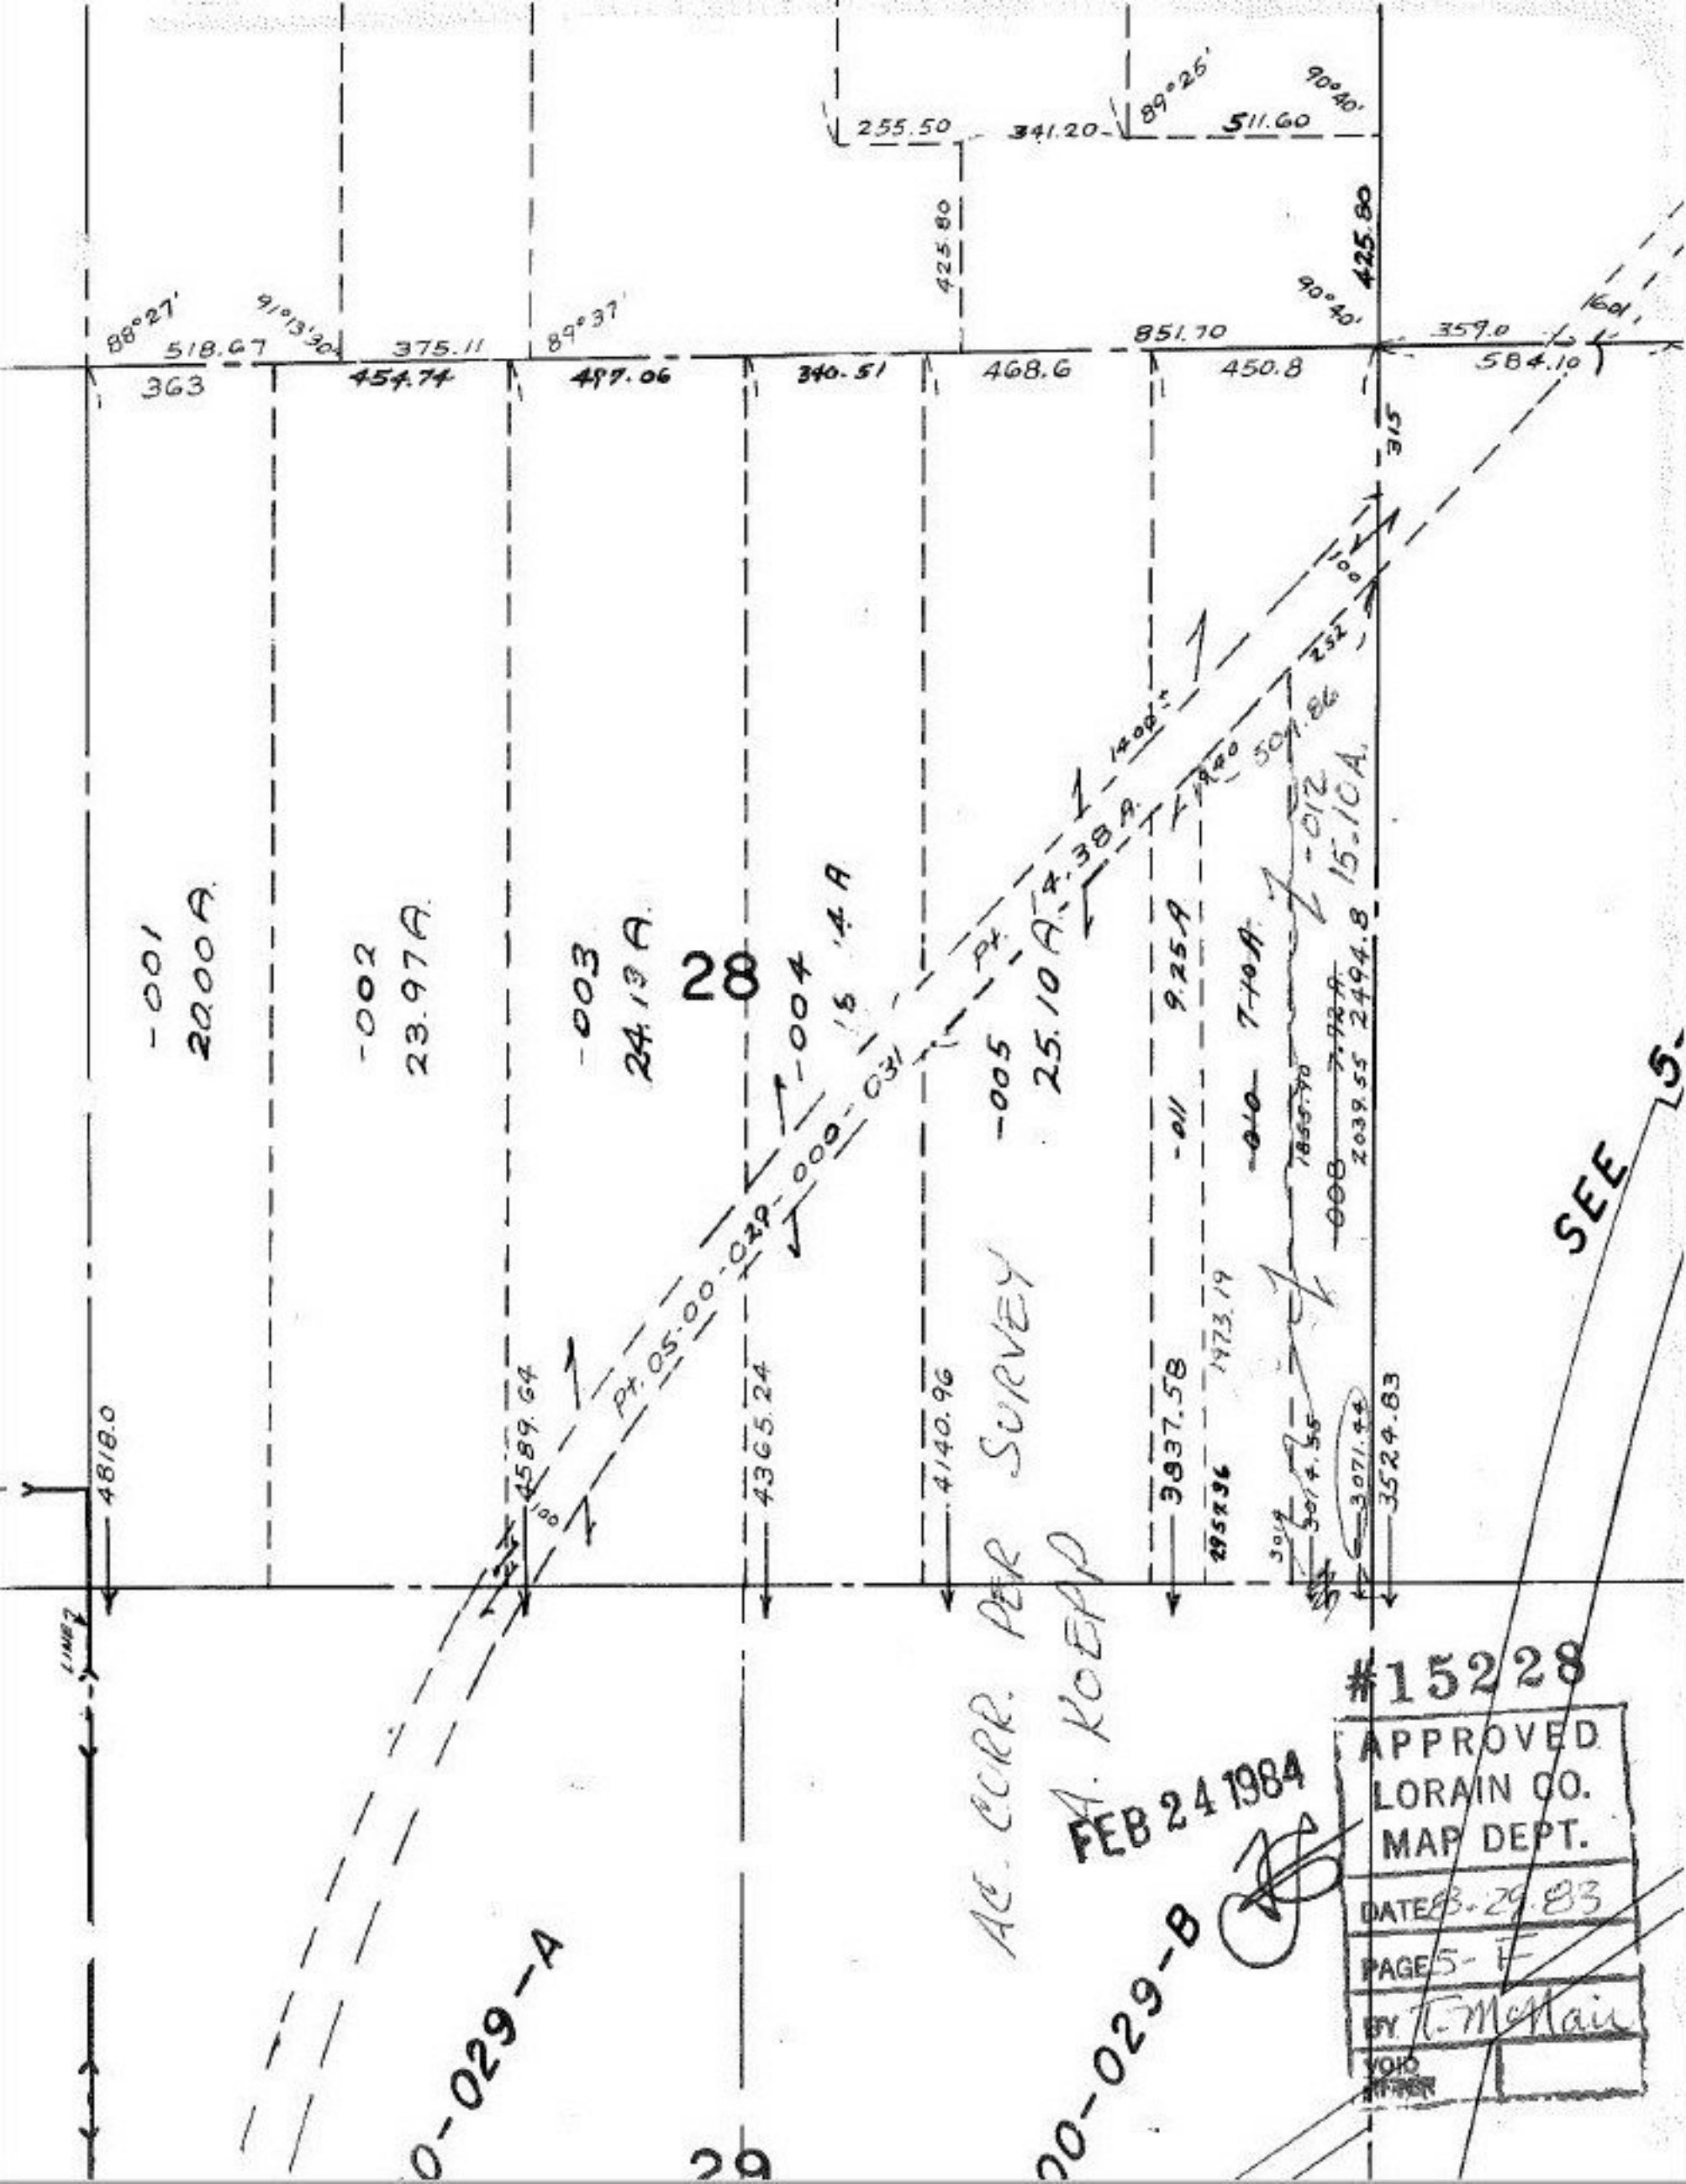
255.50
341.20
89°26'
90°40'
511.60
425.80
425.80
90°40'
88°27'
91°13'30"
89°37'
518.67
375.11
851.70
359.0
1601.
363
454.74
497.06
340.51
468.6
450.8
584.10
315
100'
1402.
232'
-001
20.00 A.
-002
23.97 A.
-003
24.13 A.
28
-004
15.14 A.
-031
Pt.
-005
25.10 A.
4.38 A.
R=1940'
509.86
9.25 A.
7.10 A.
-012
15-1CA.
2494.8
4818.0
4589.64
100'
Pt. 05-00-029-000
4365.24
4140.96
3937.58
1973.19
3524.83
SEE
AC. CORR. PER SURVEY
A. KOEPP
FEB 24 1984
#15228
APPROVED
LORAIN CO.
MAP DEPT.
DATE 3-29-83
PAGE 5-F
BY T. McMain
VOID
-029-A
-029-B
29