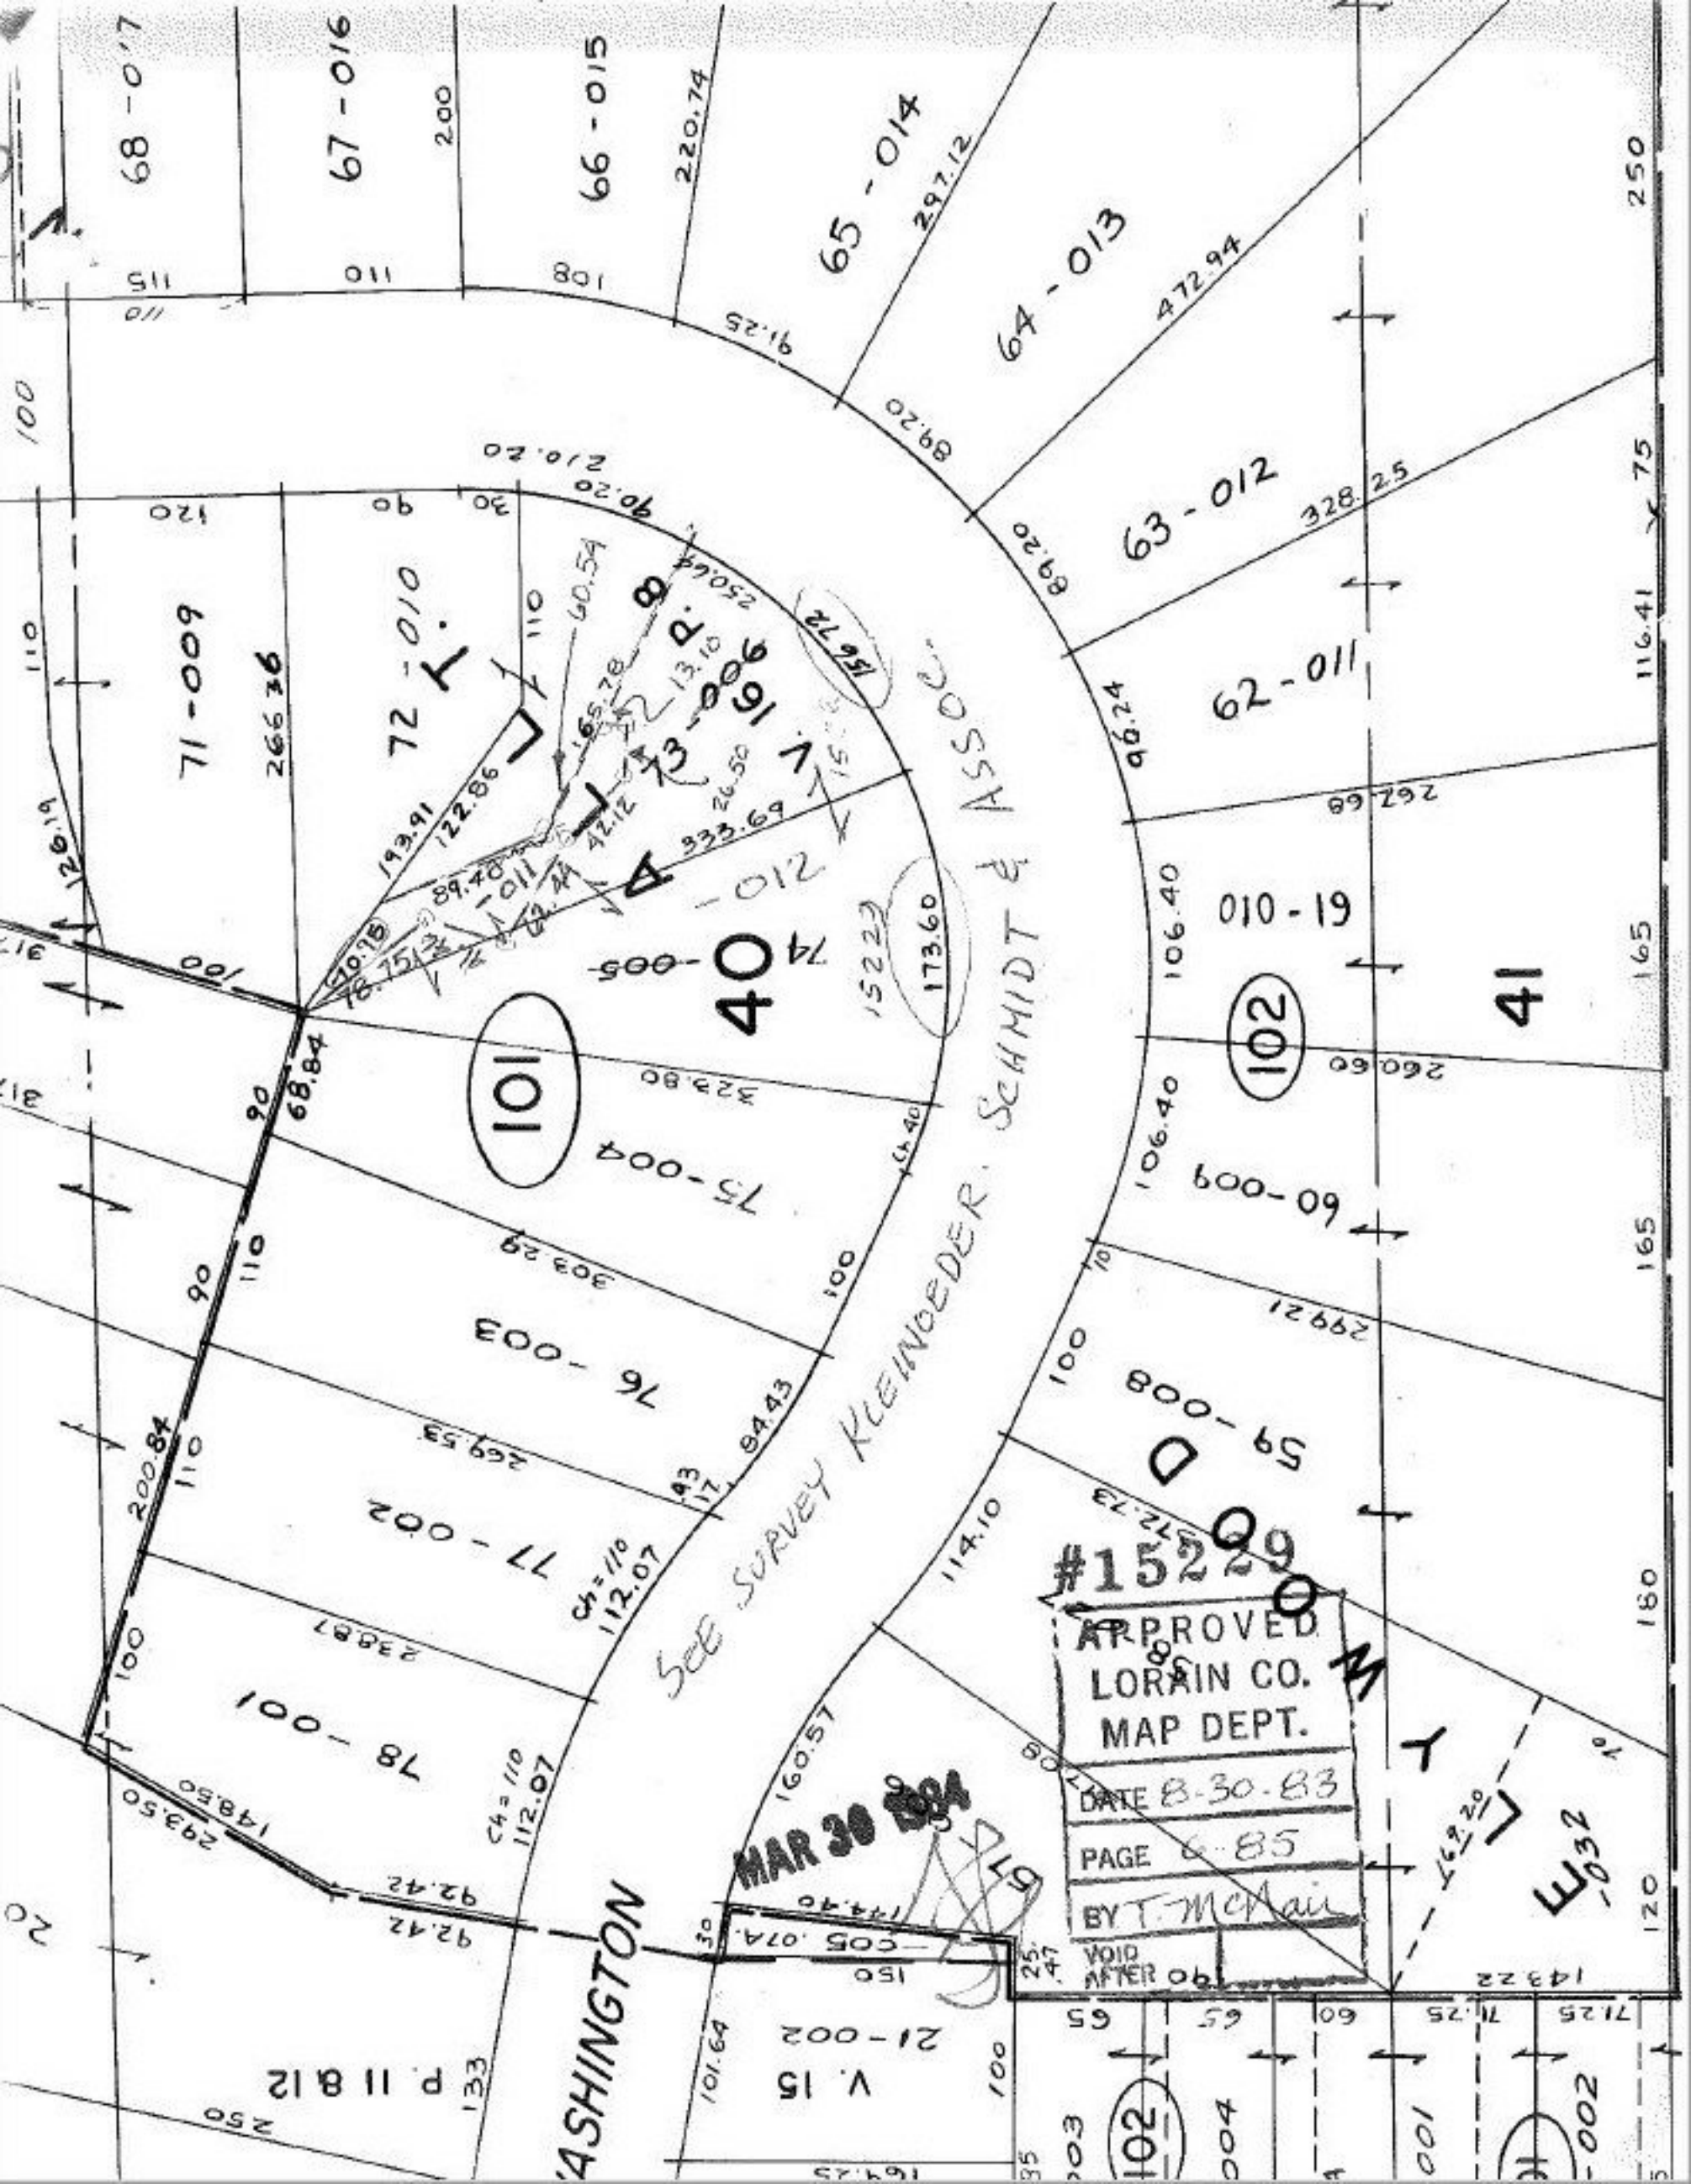
SCHMIDT & ASSOC.
See SURVEY KLEINDEER
#15229
APPROVED
LORAIN CO.
MAP DEPT.
DATE 8-30-83
PAGE 6-85
BY T. McMain
VOID AFTER 06
MAR 30 1984
40
101
102
41
68 - 017
67 - 016
66 - 015
65 - 014
64 - 013
63 - 012
62 - 011
71 - 009
72 - 010
73 - 006
74 - 005
75 - 004
76 - 003
77 - 002
78 - 001
21 - 002
V. 15
P. 11 812
DOWNEY