SEE 7-00-006-B

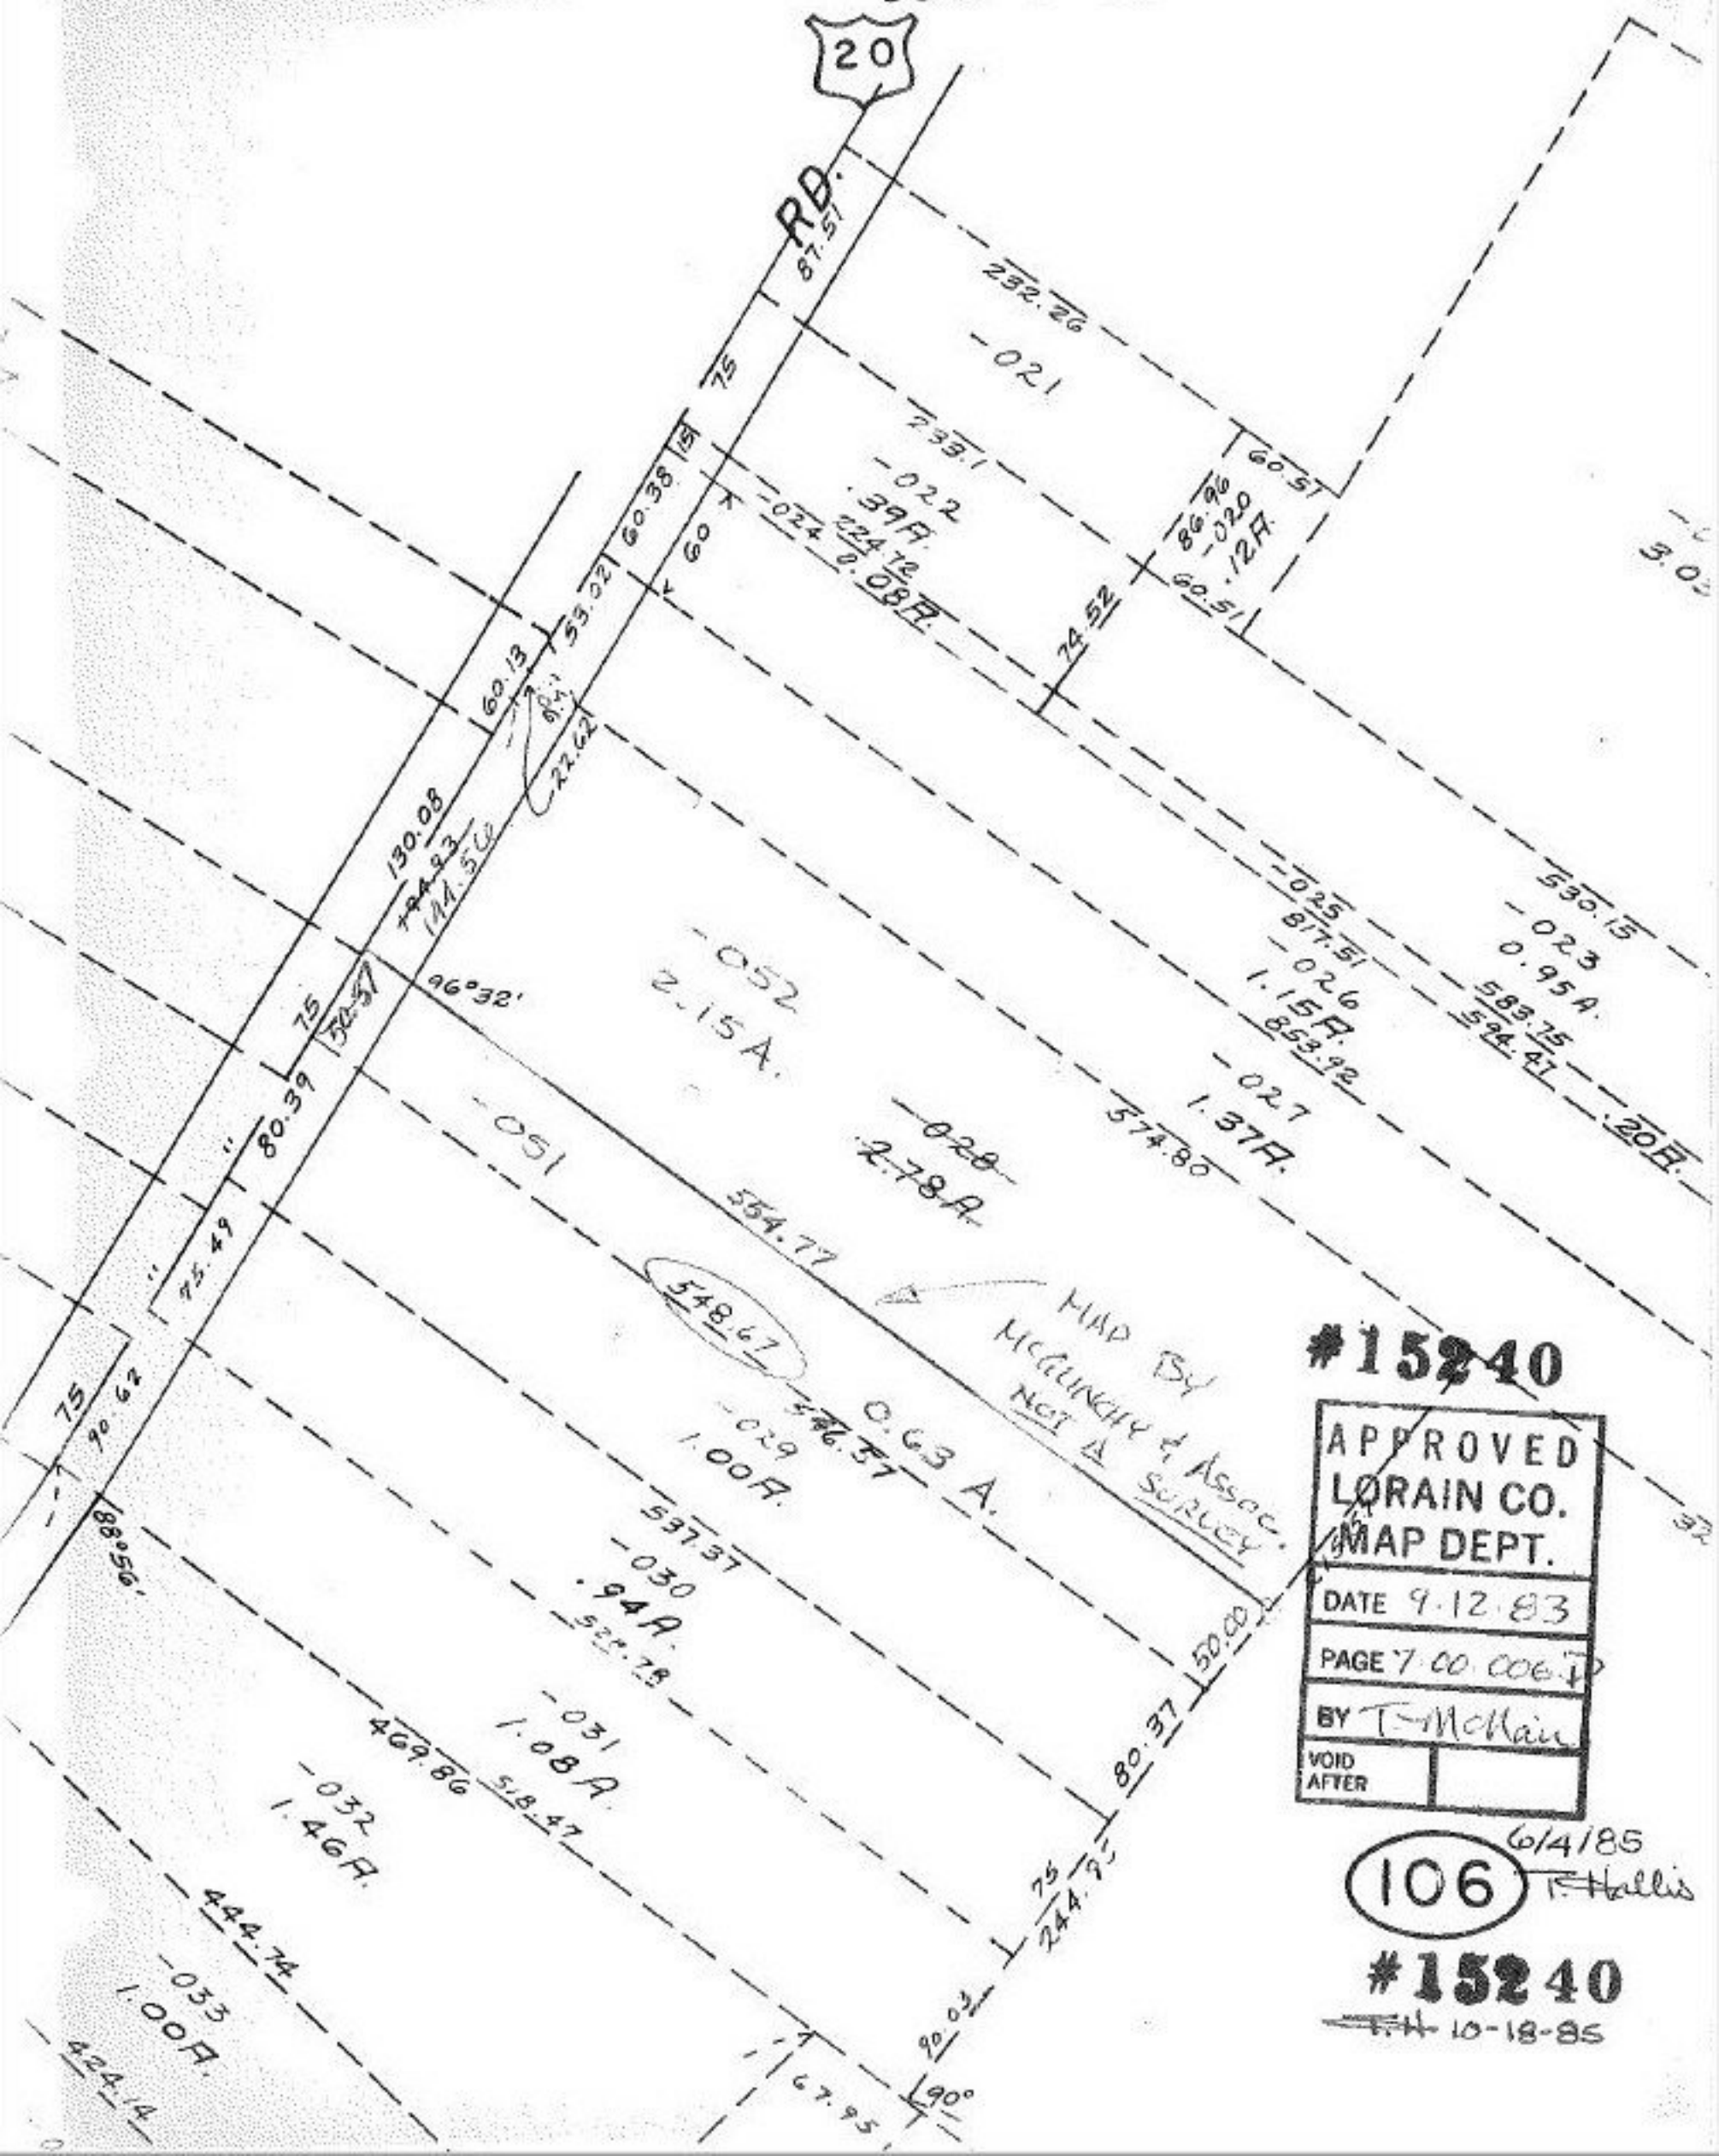

#15240

APPROVED
LORAIN CO.
MAP DEPT.
DATE 9.12.83
PAGE 7.00.006-B
BY T. McMain
VOID AFTER

106

6/4/85
T. Hallis

#15240
T.H. 10-18-85