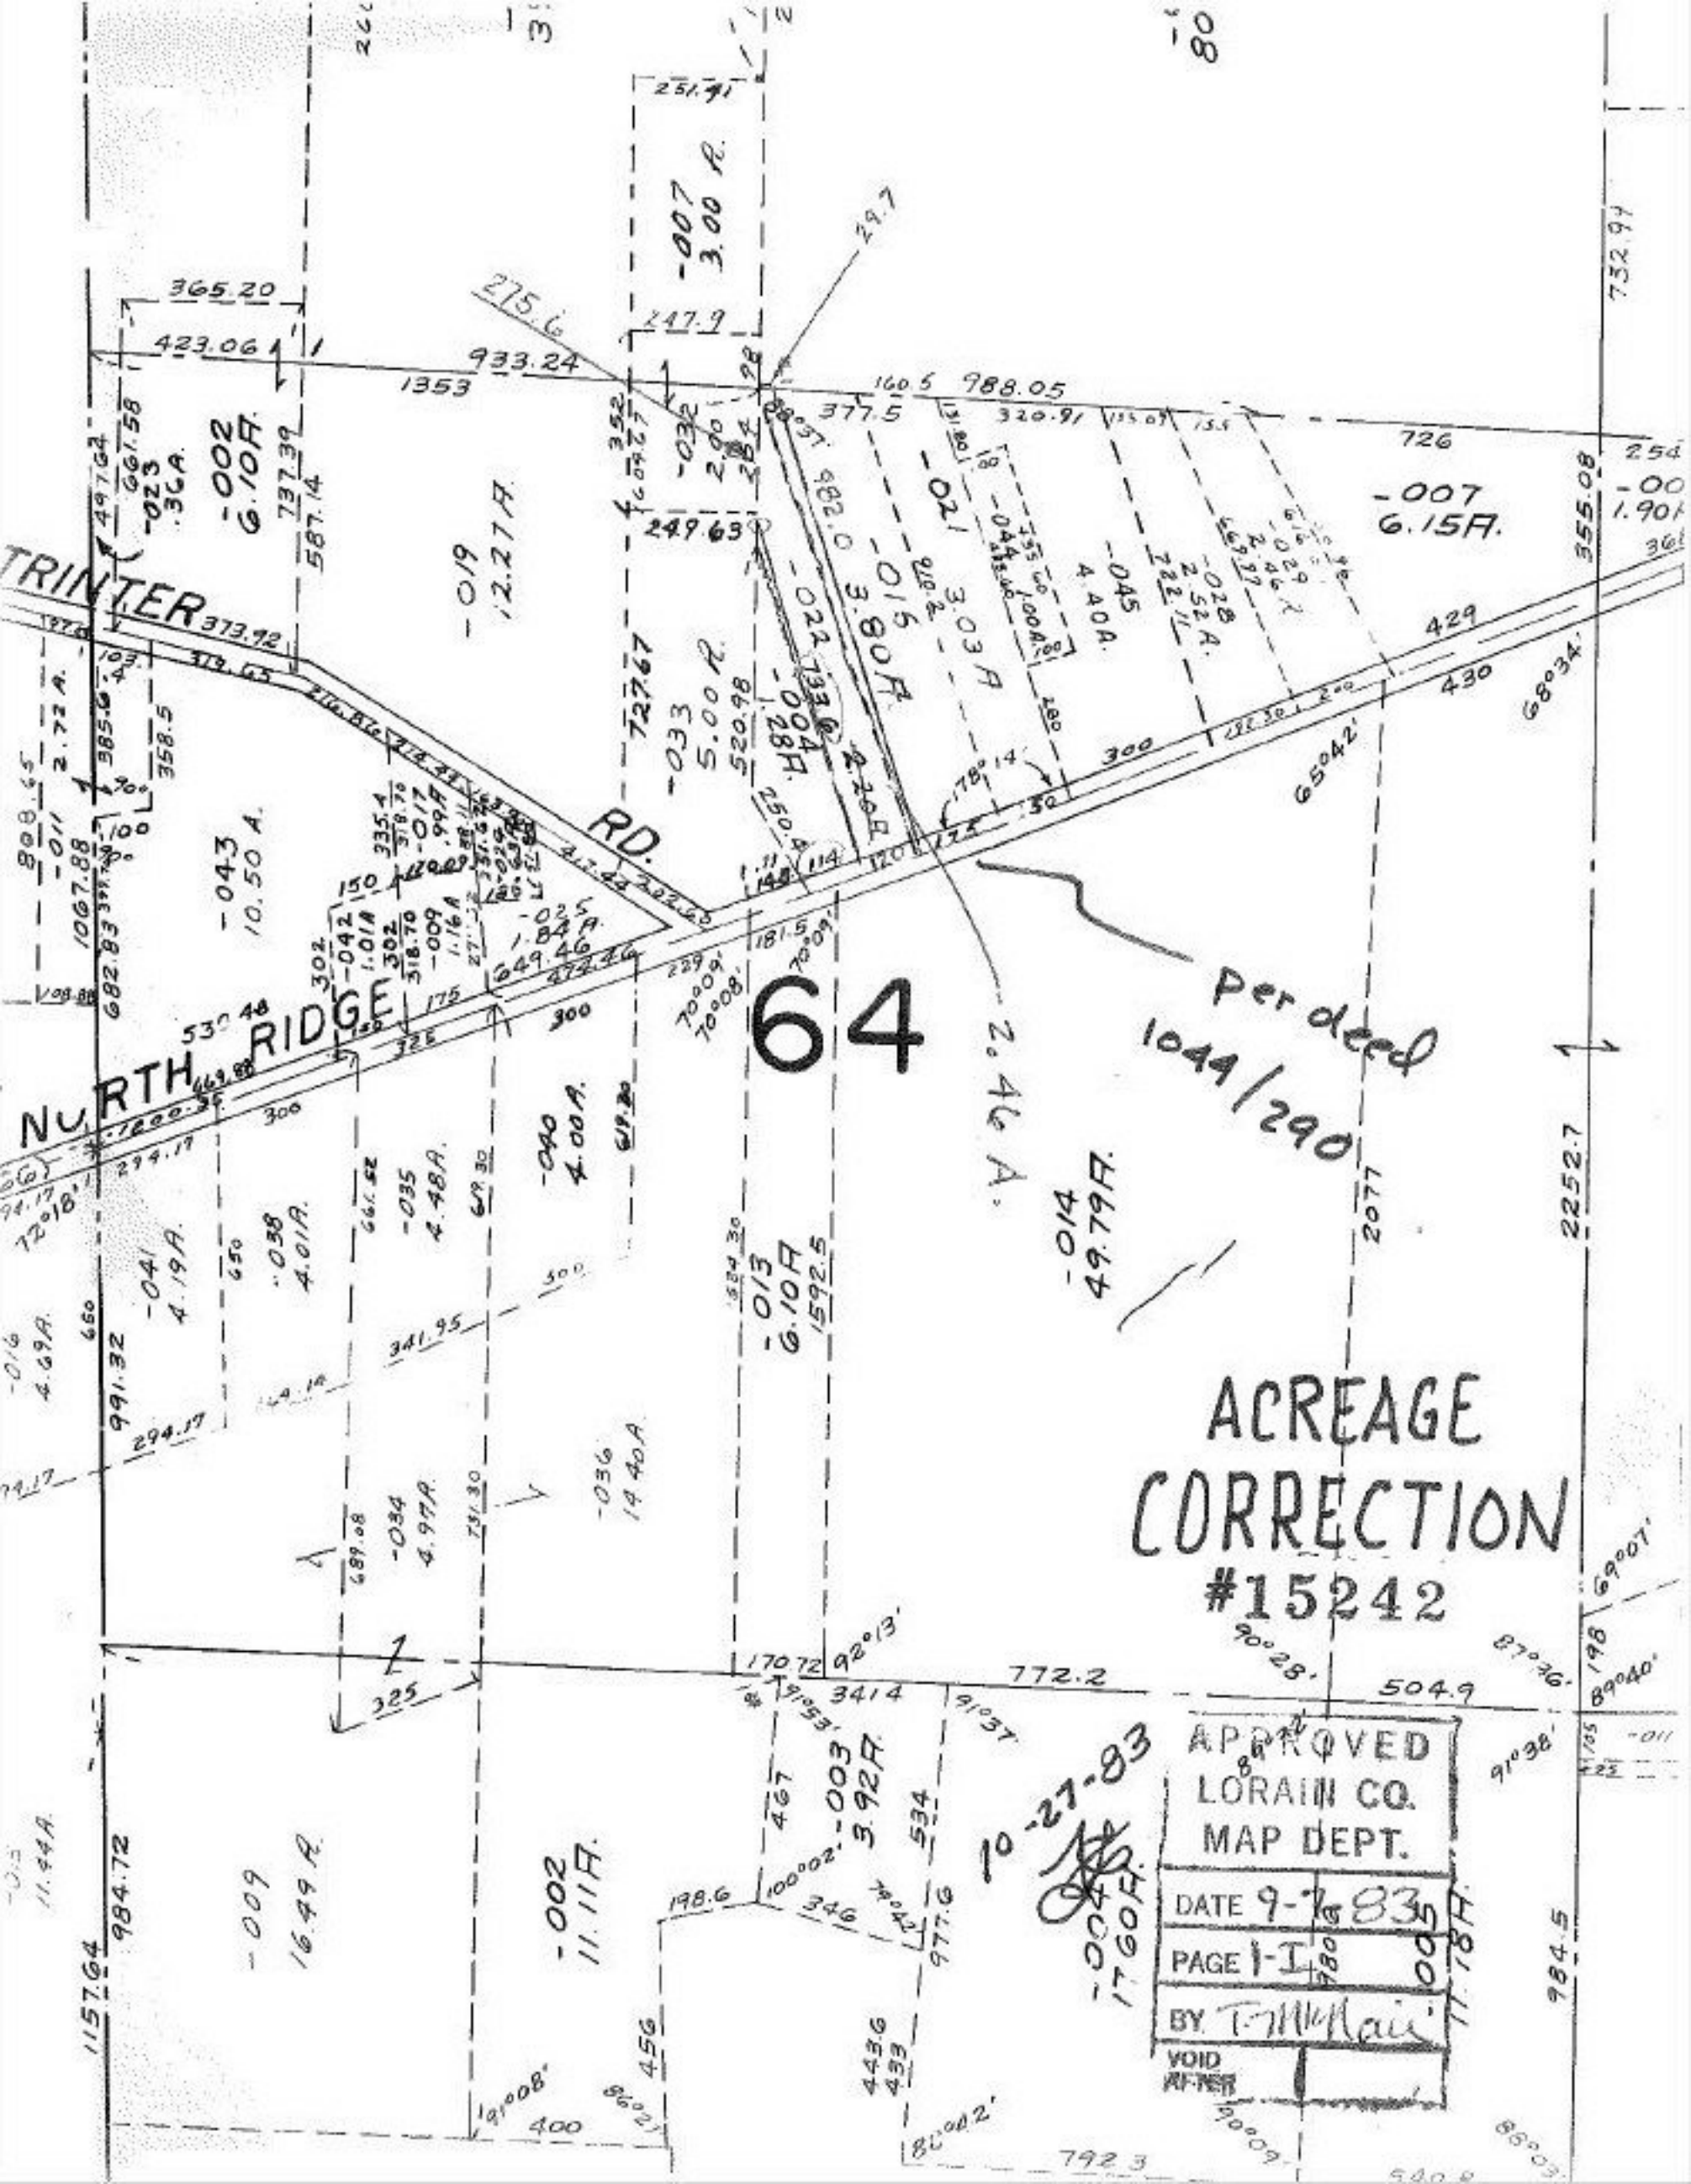

TRINTER
RD.
NORTH RIDGE
64
Per deed
1044/290
ACREAGE
CORRECTION
#15242
APPROVED
LORAIN CO.
MAP DEPT.
DATE 9-7-83
PAGE 1-I
BY T. McNair
VOID
AFTER
10-27-83