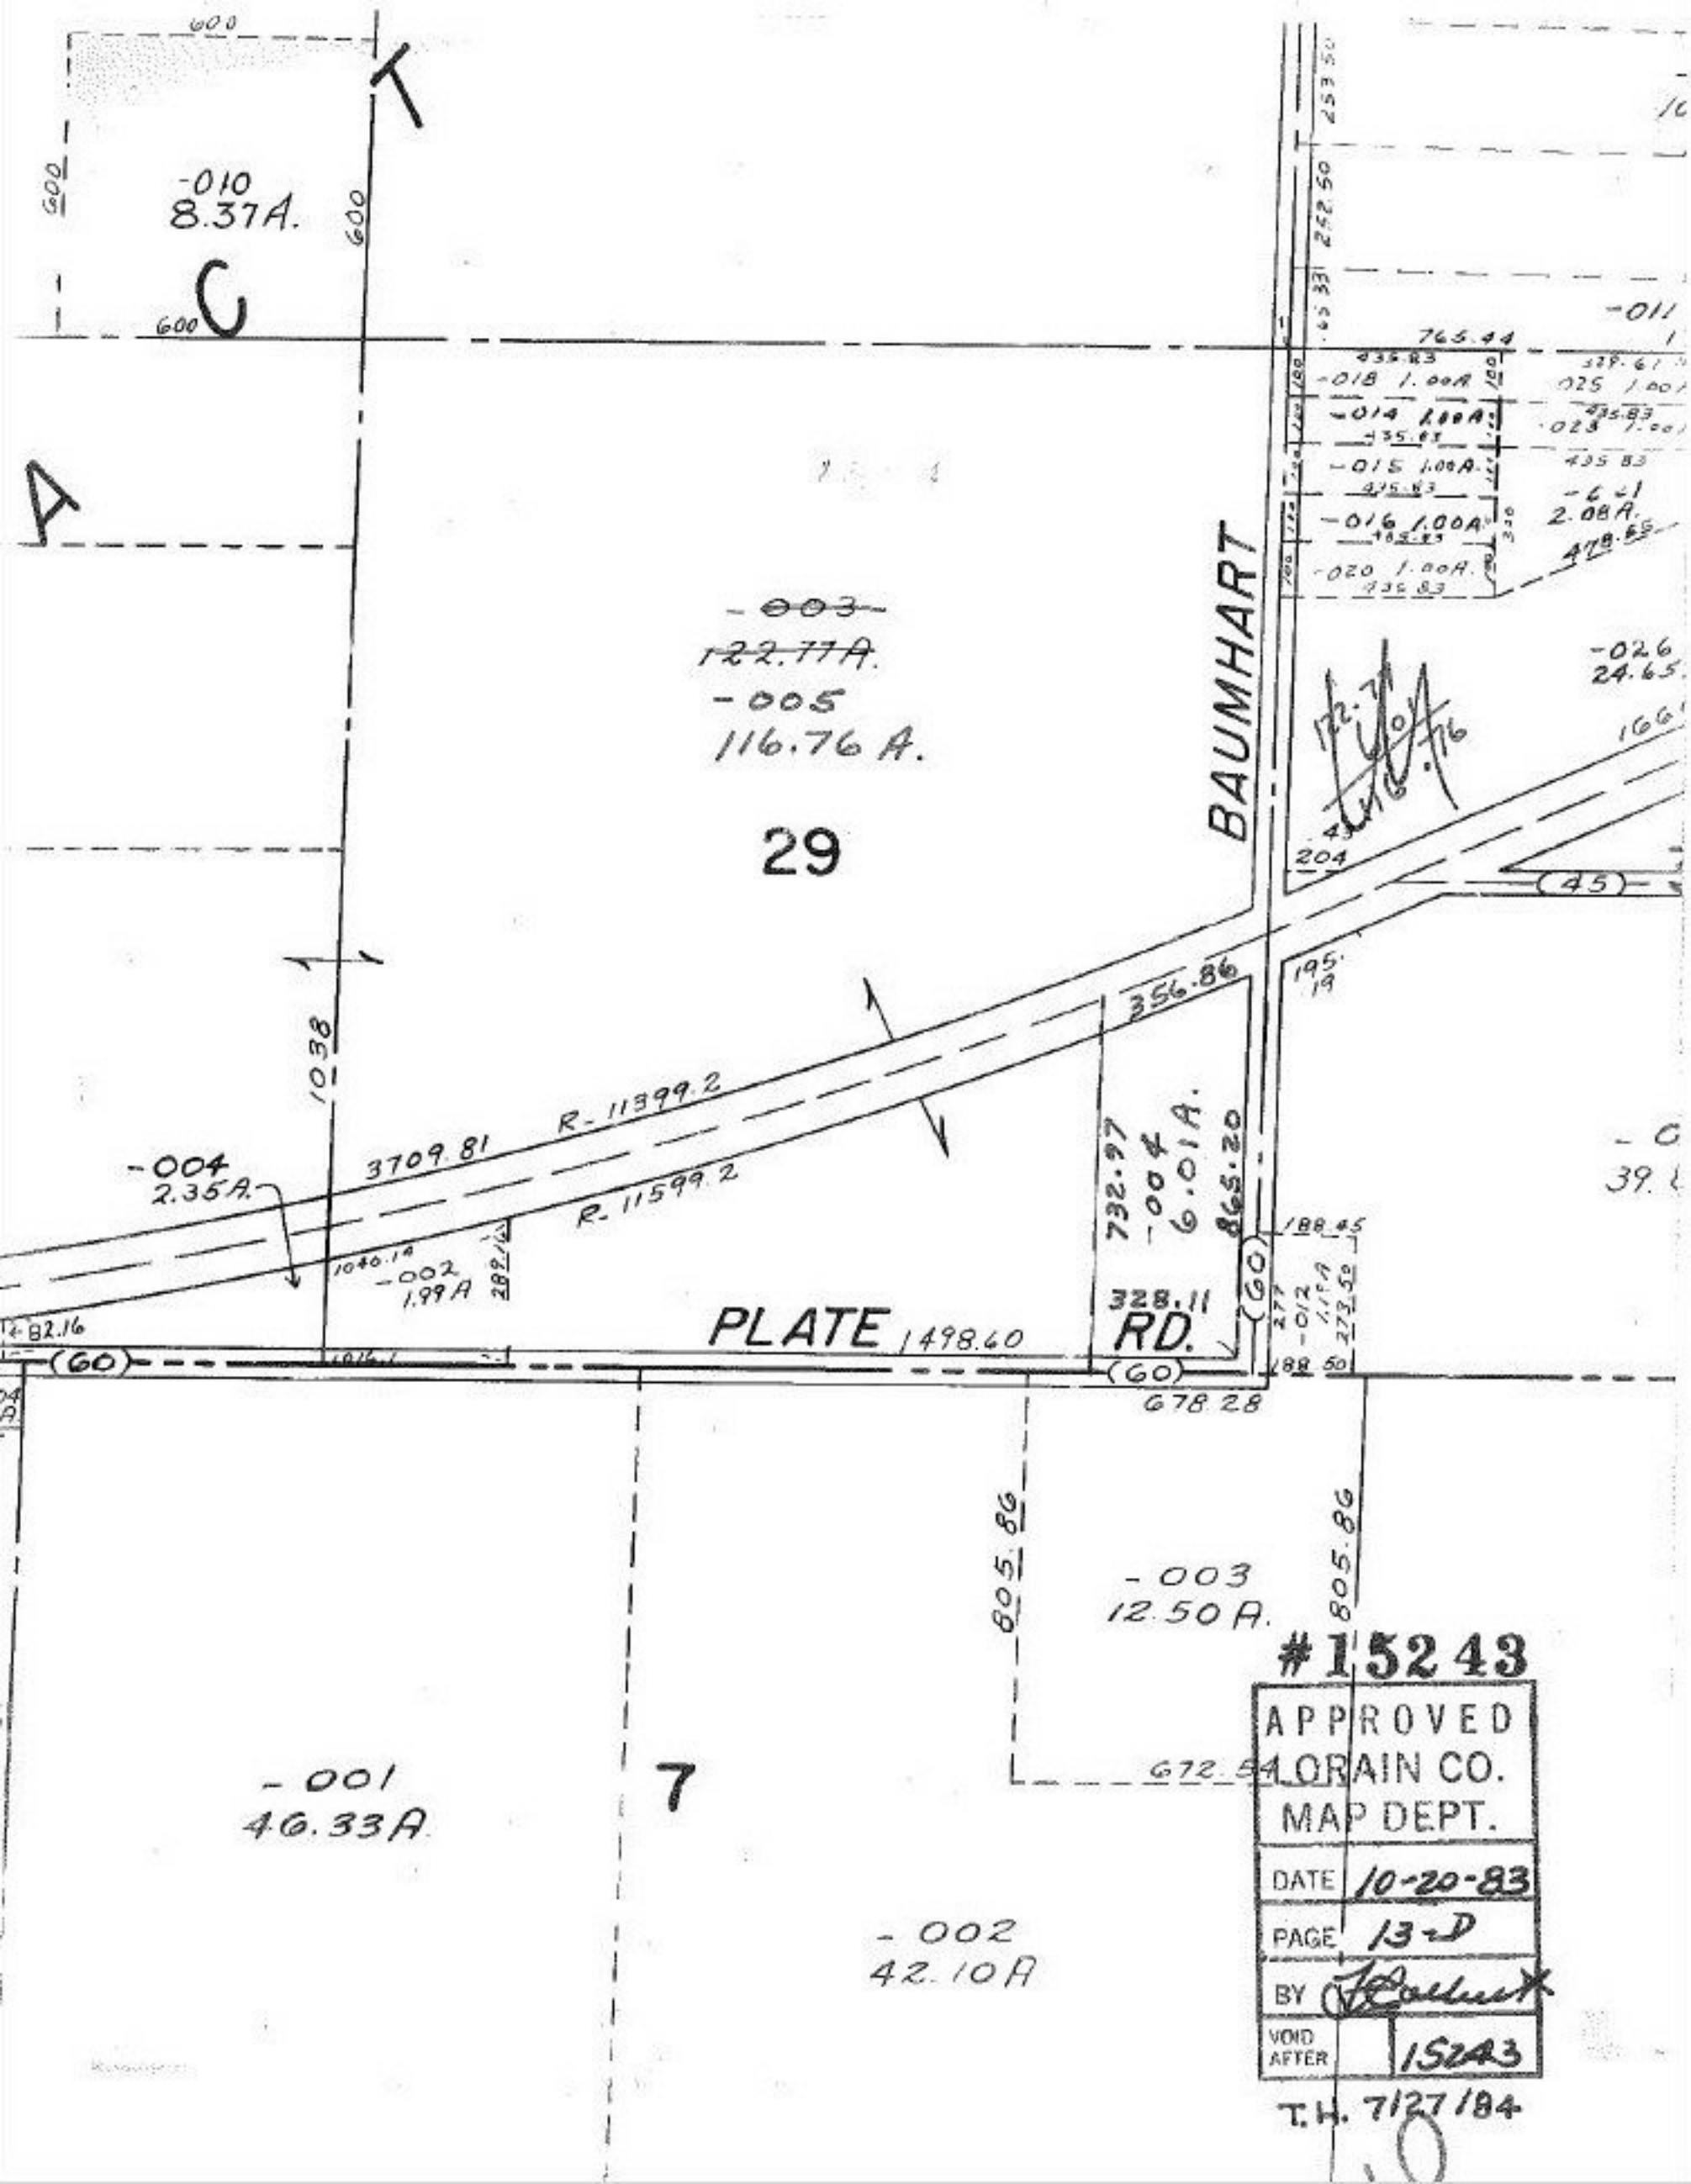

#15243

APPROVED
LORAIN CO.
MAP DEPT.

DATE	10-20-83
PAGE	13-D
BY	[signature]
VOID AFTER	15243

T.H. 7/27/84