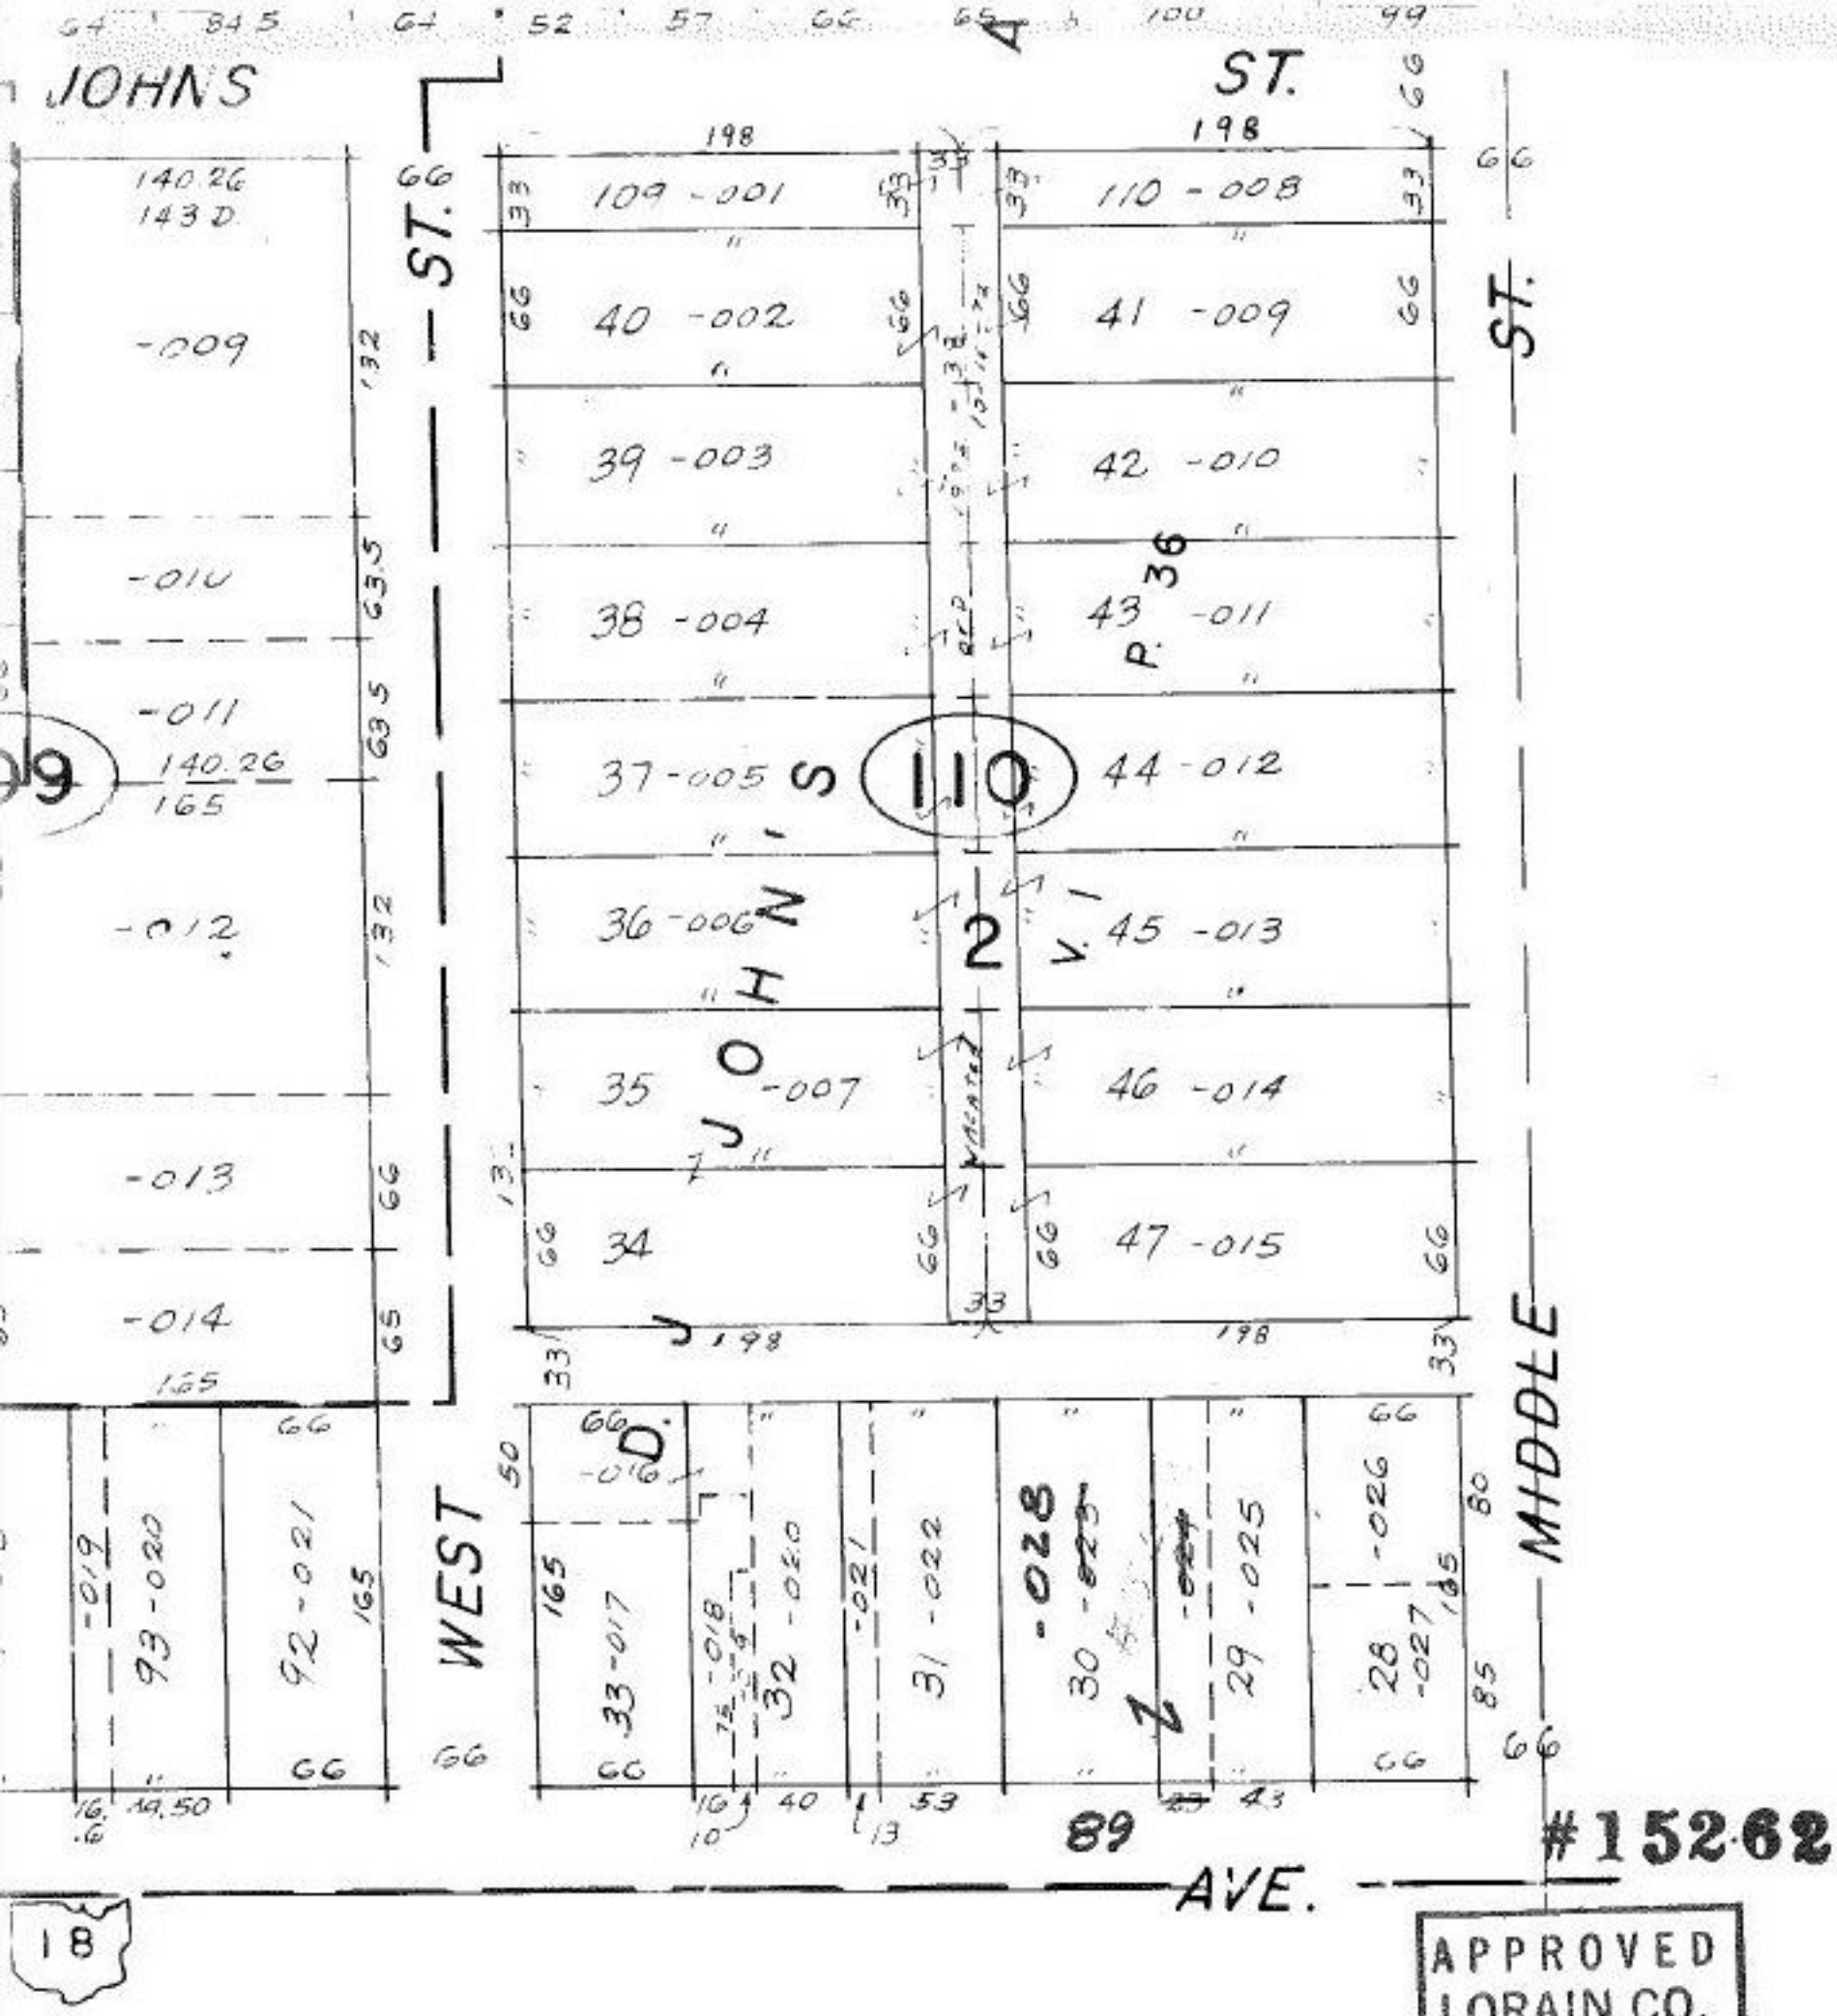

APPROVED
LORAIN CO.
MAP DEPT.
DATE 9-14-83
PAGE 18-00-028 C
BY [signature]
VOID AFTER 15262

T.H. 7/9/84

SW 1/4 LOT 28