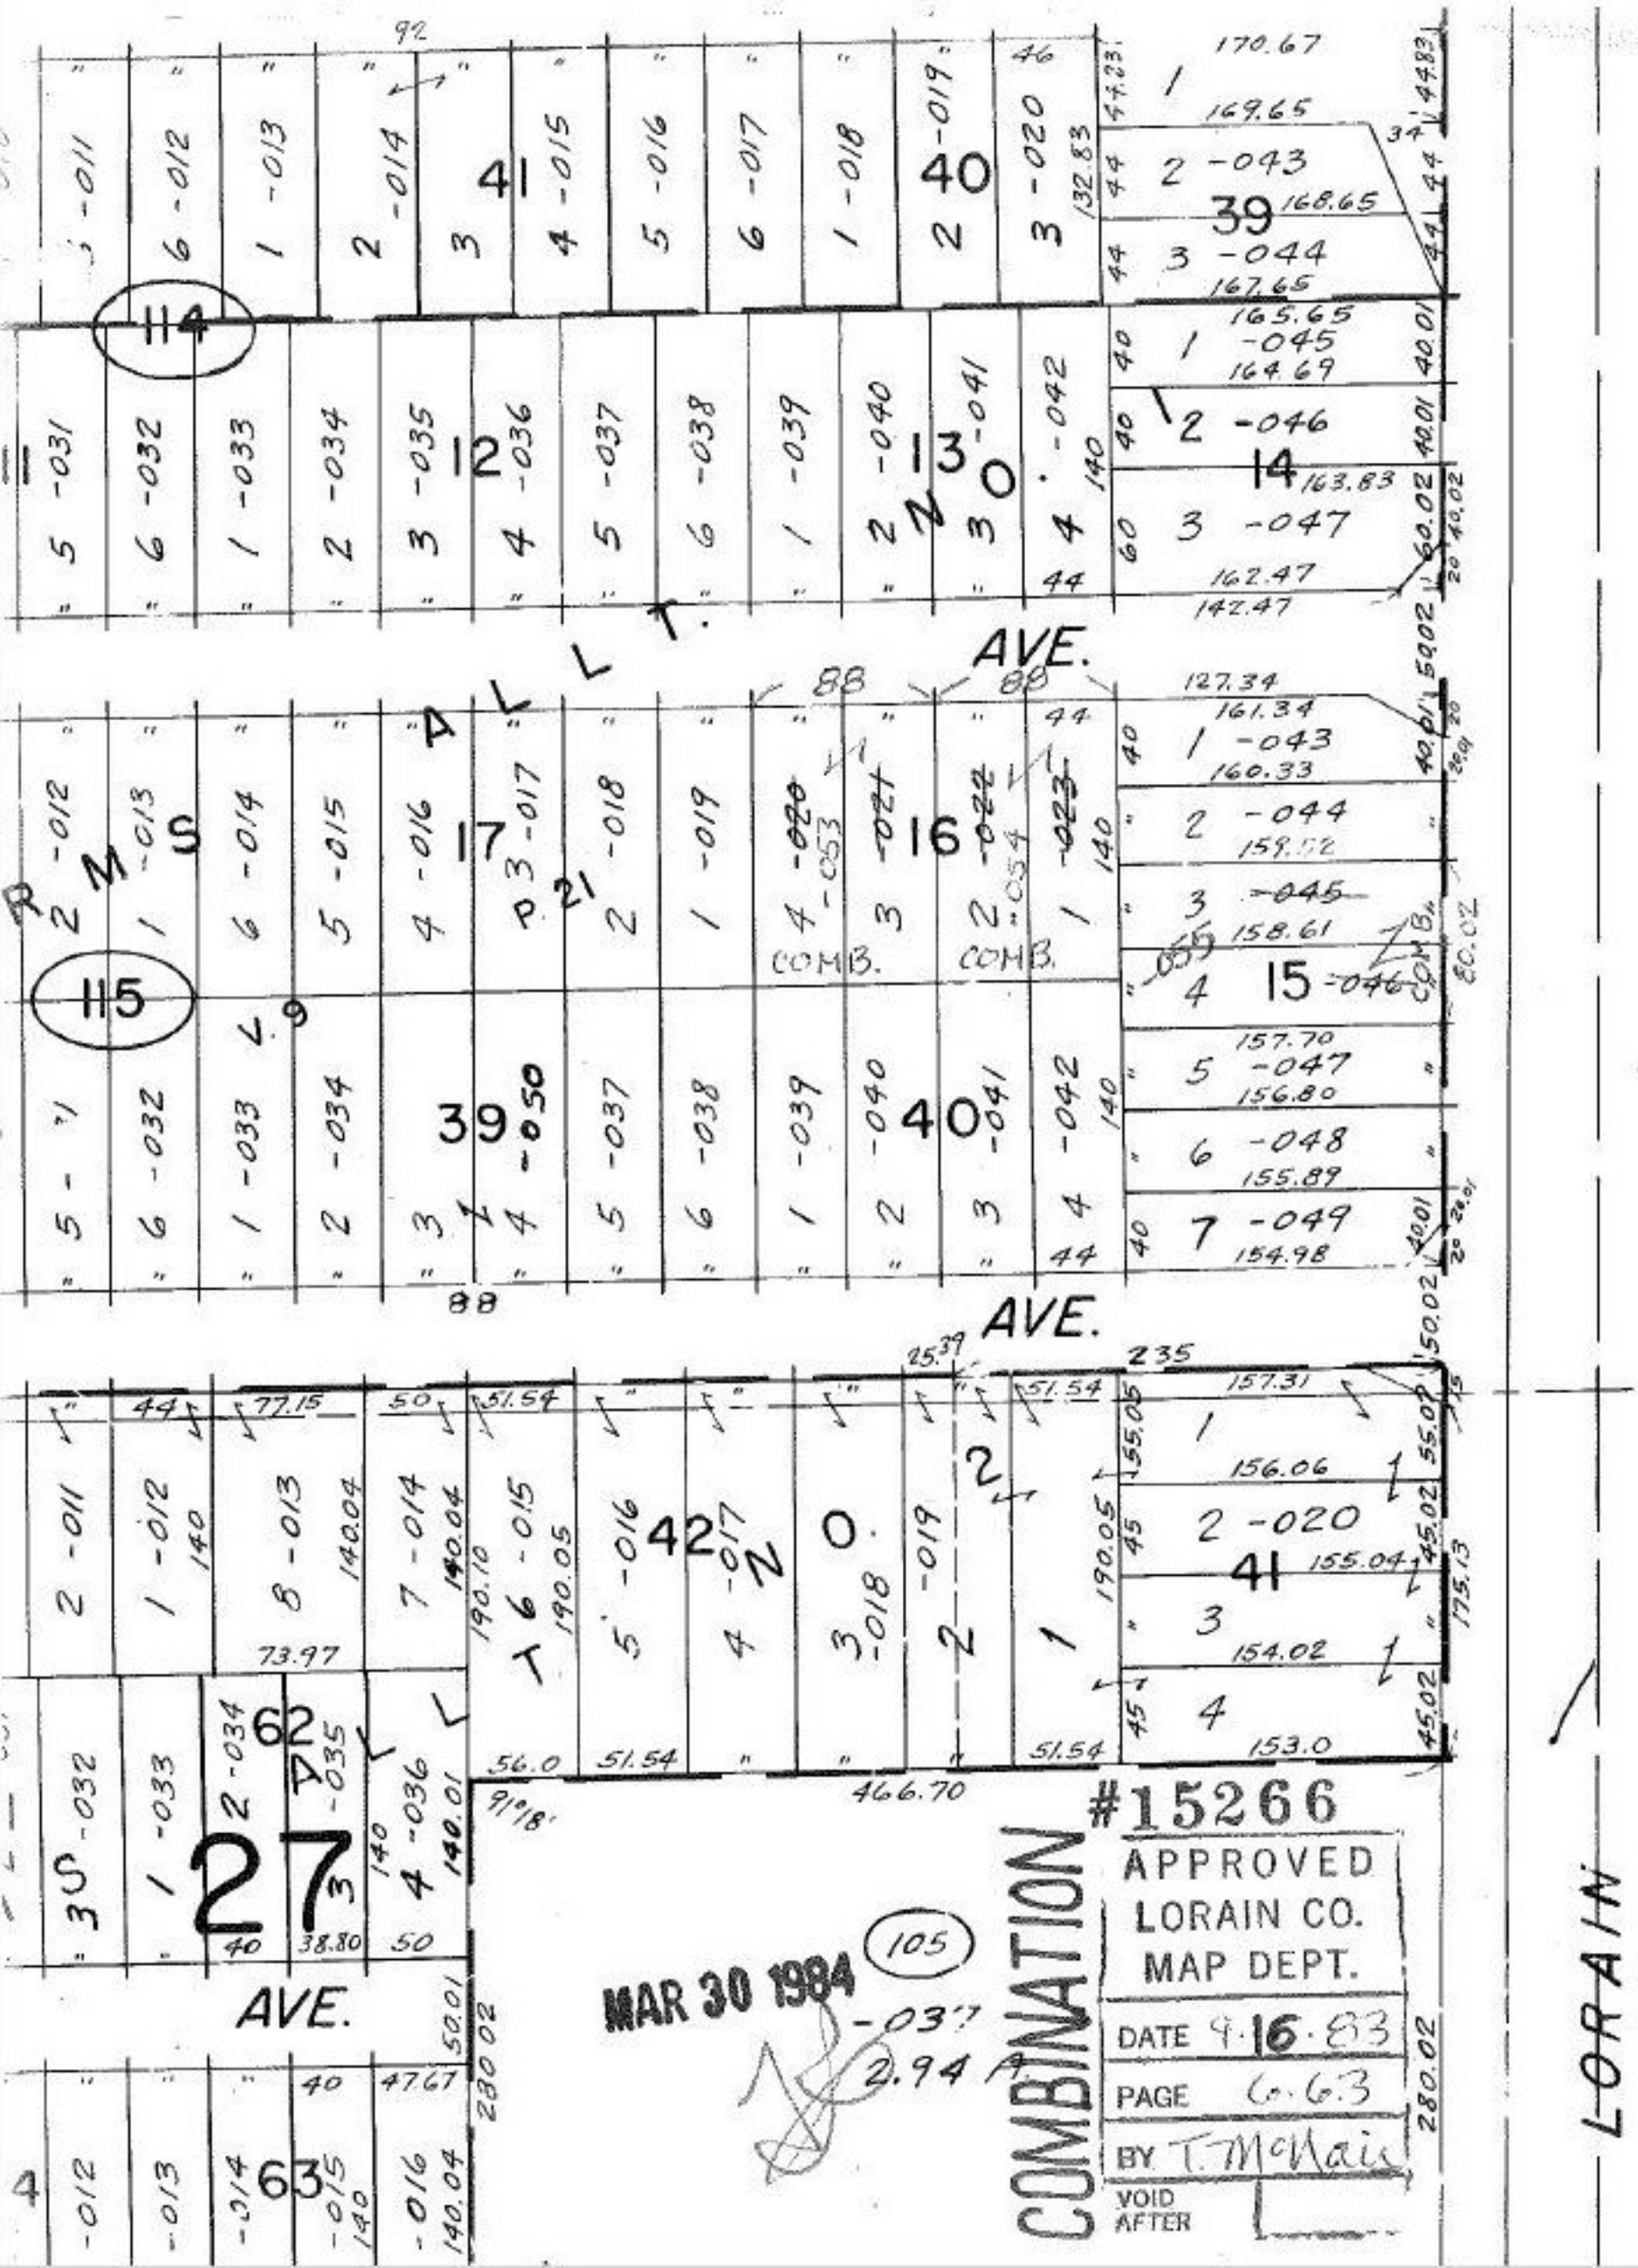
114
115
41
39
40
12
13
14
17
16
15
39
40
42
41
62
27
63
ALT. AVE.
ALT. AVE.
LORAIN
#15266
APPROVED
LORAIN CO.
MAP DEPT.
DATE 9-16-83
PAGE 6-63
BY T. McNair
VOID AFTER
COMBINATION
MAR 30 1984
105
-037
2.94 A