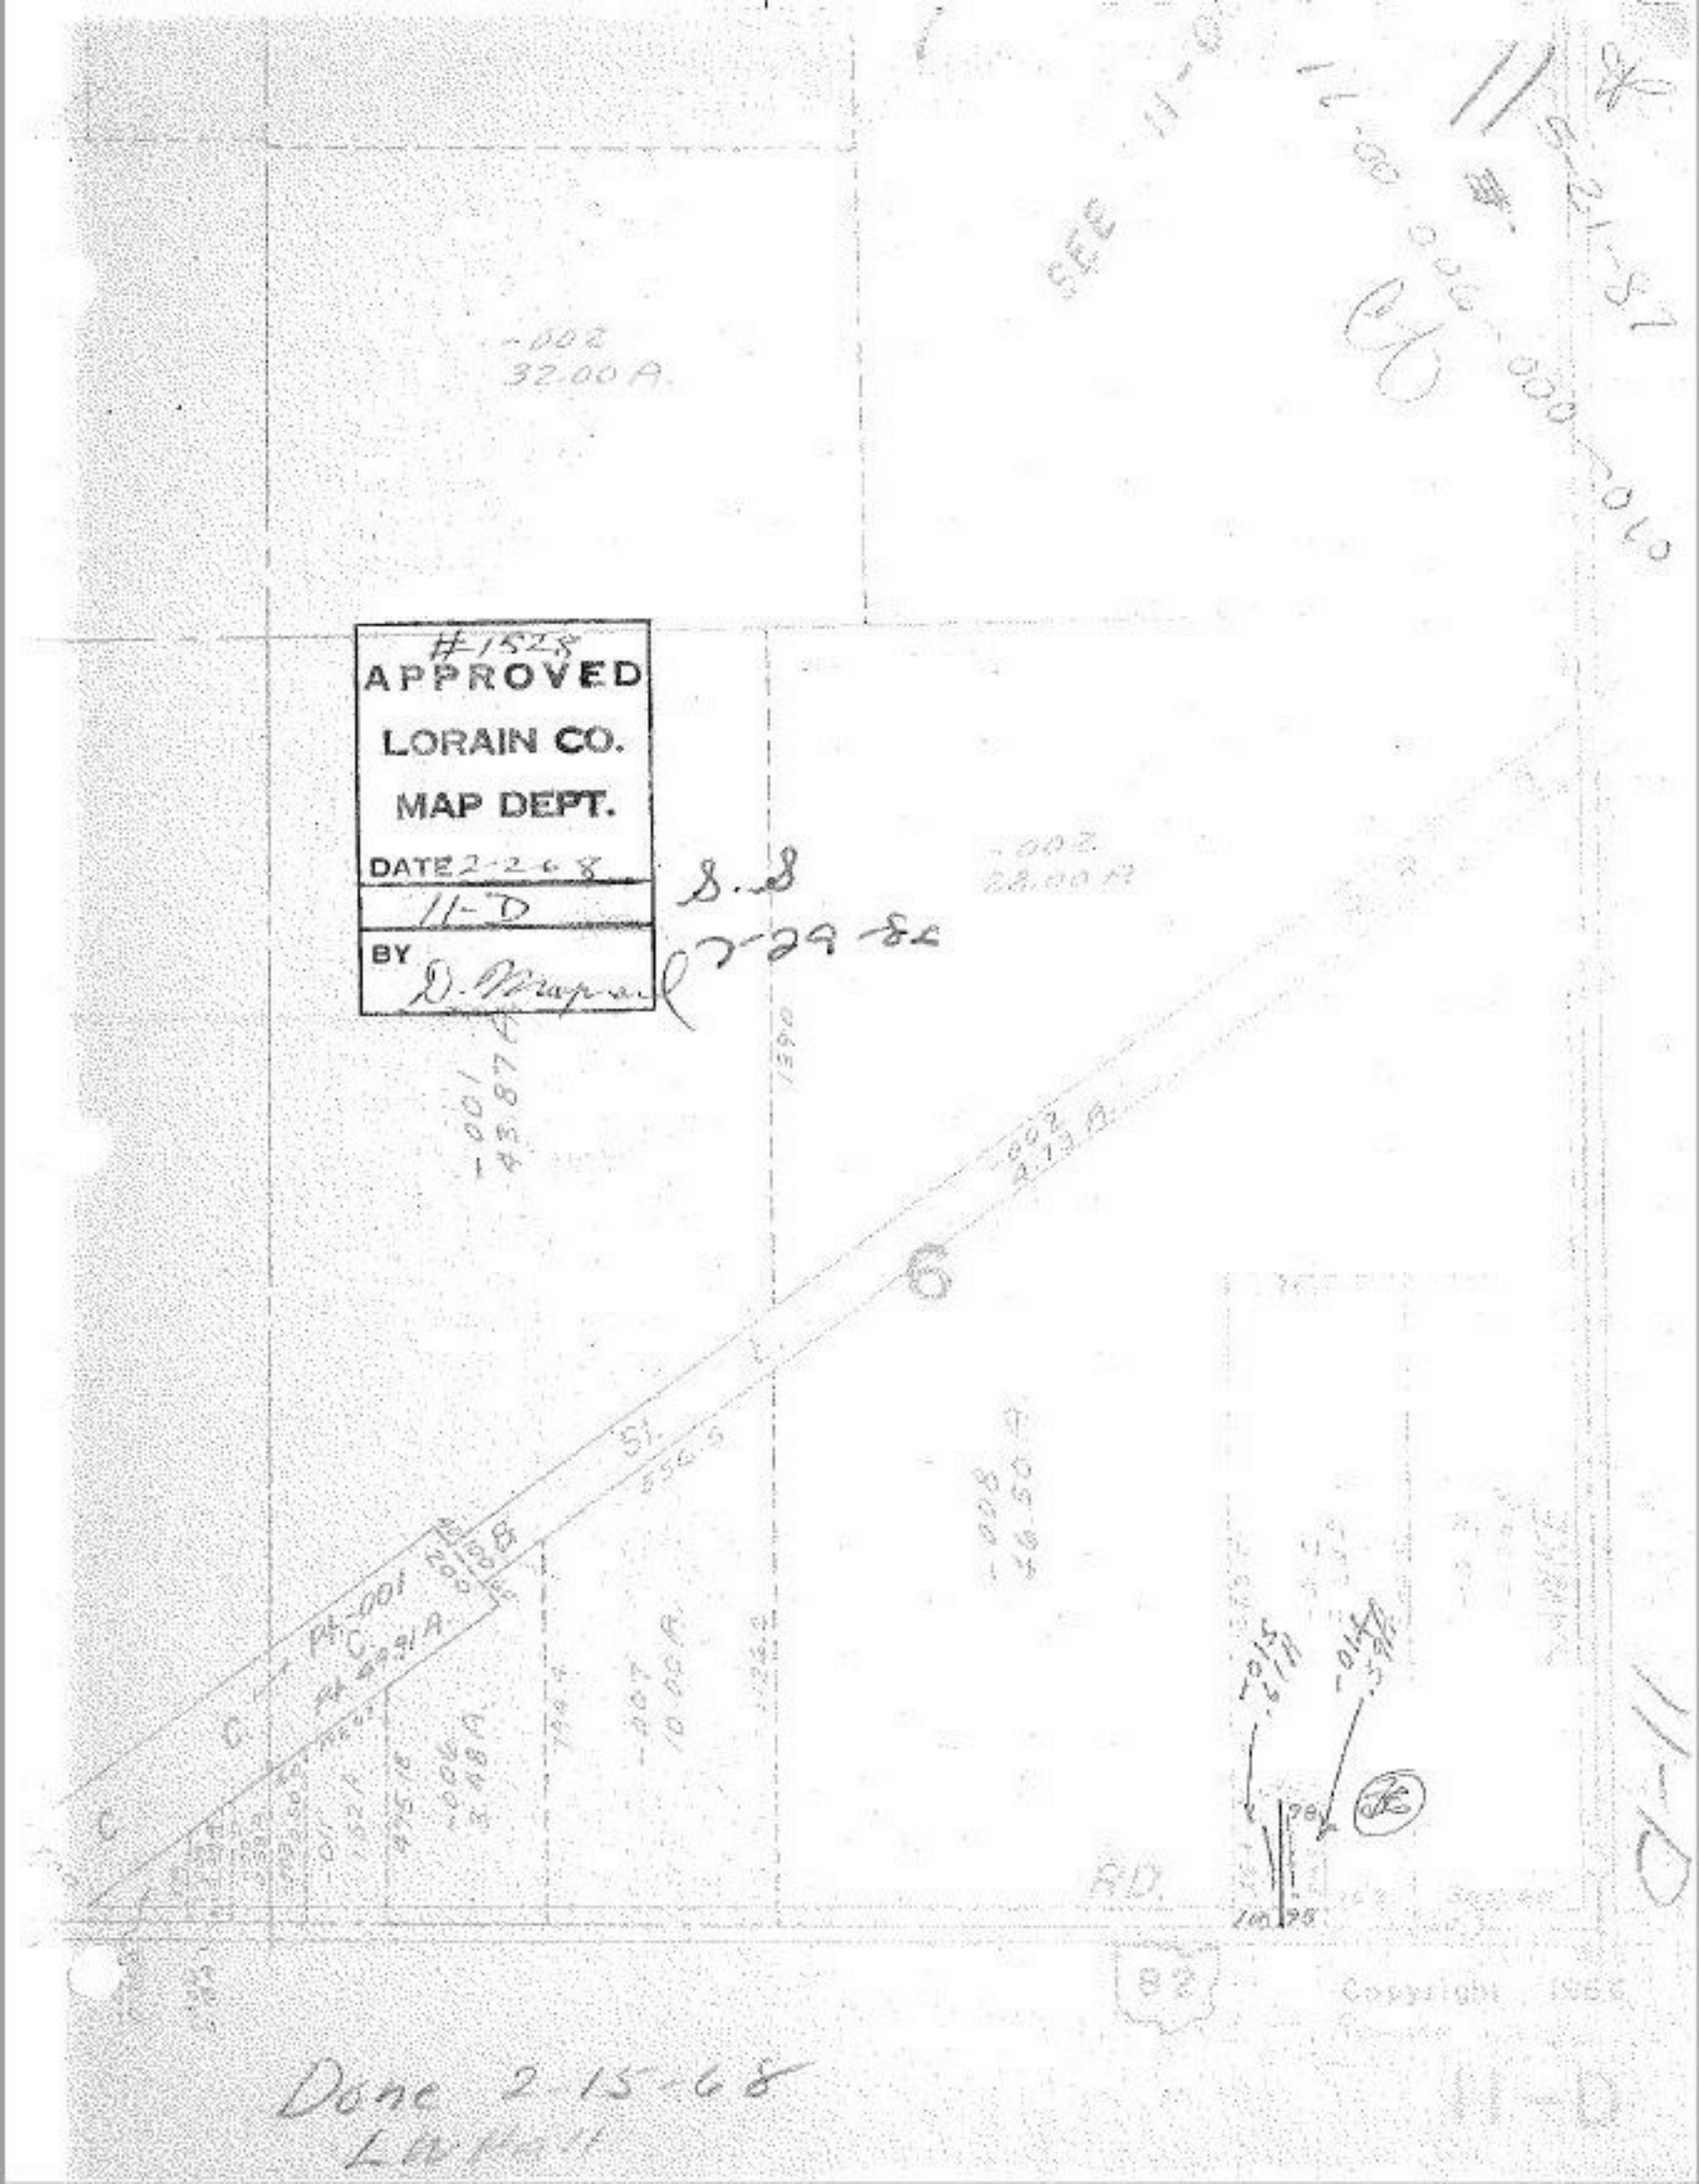

Done 2-15-68
LWHall