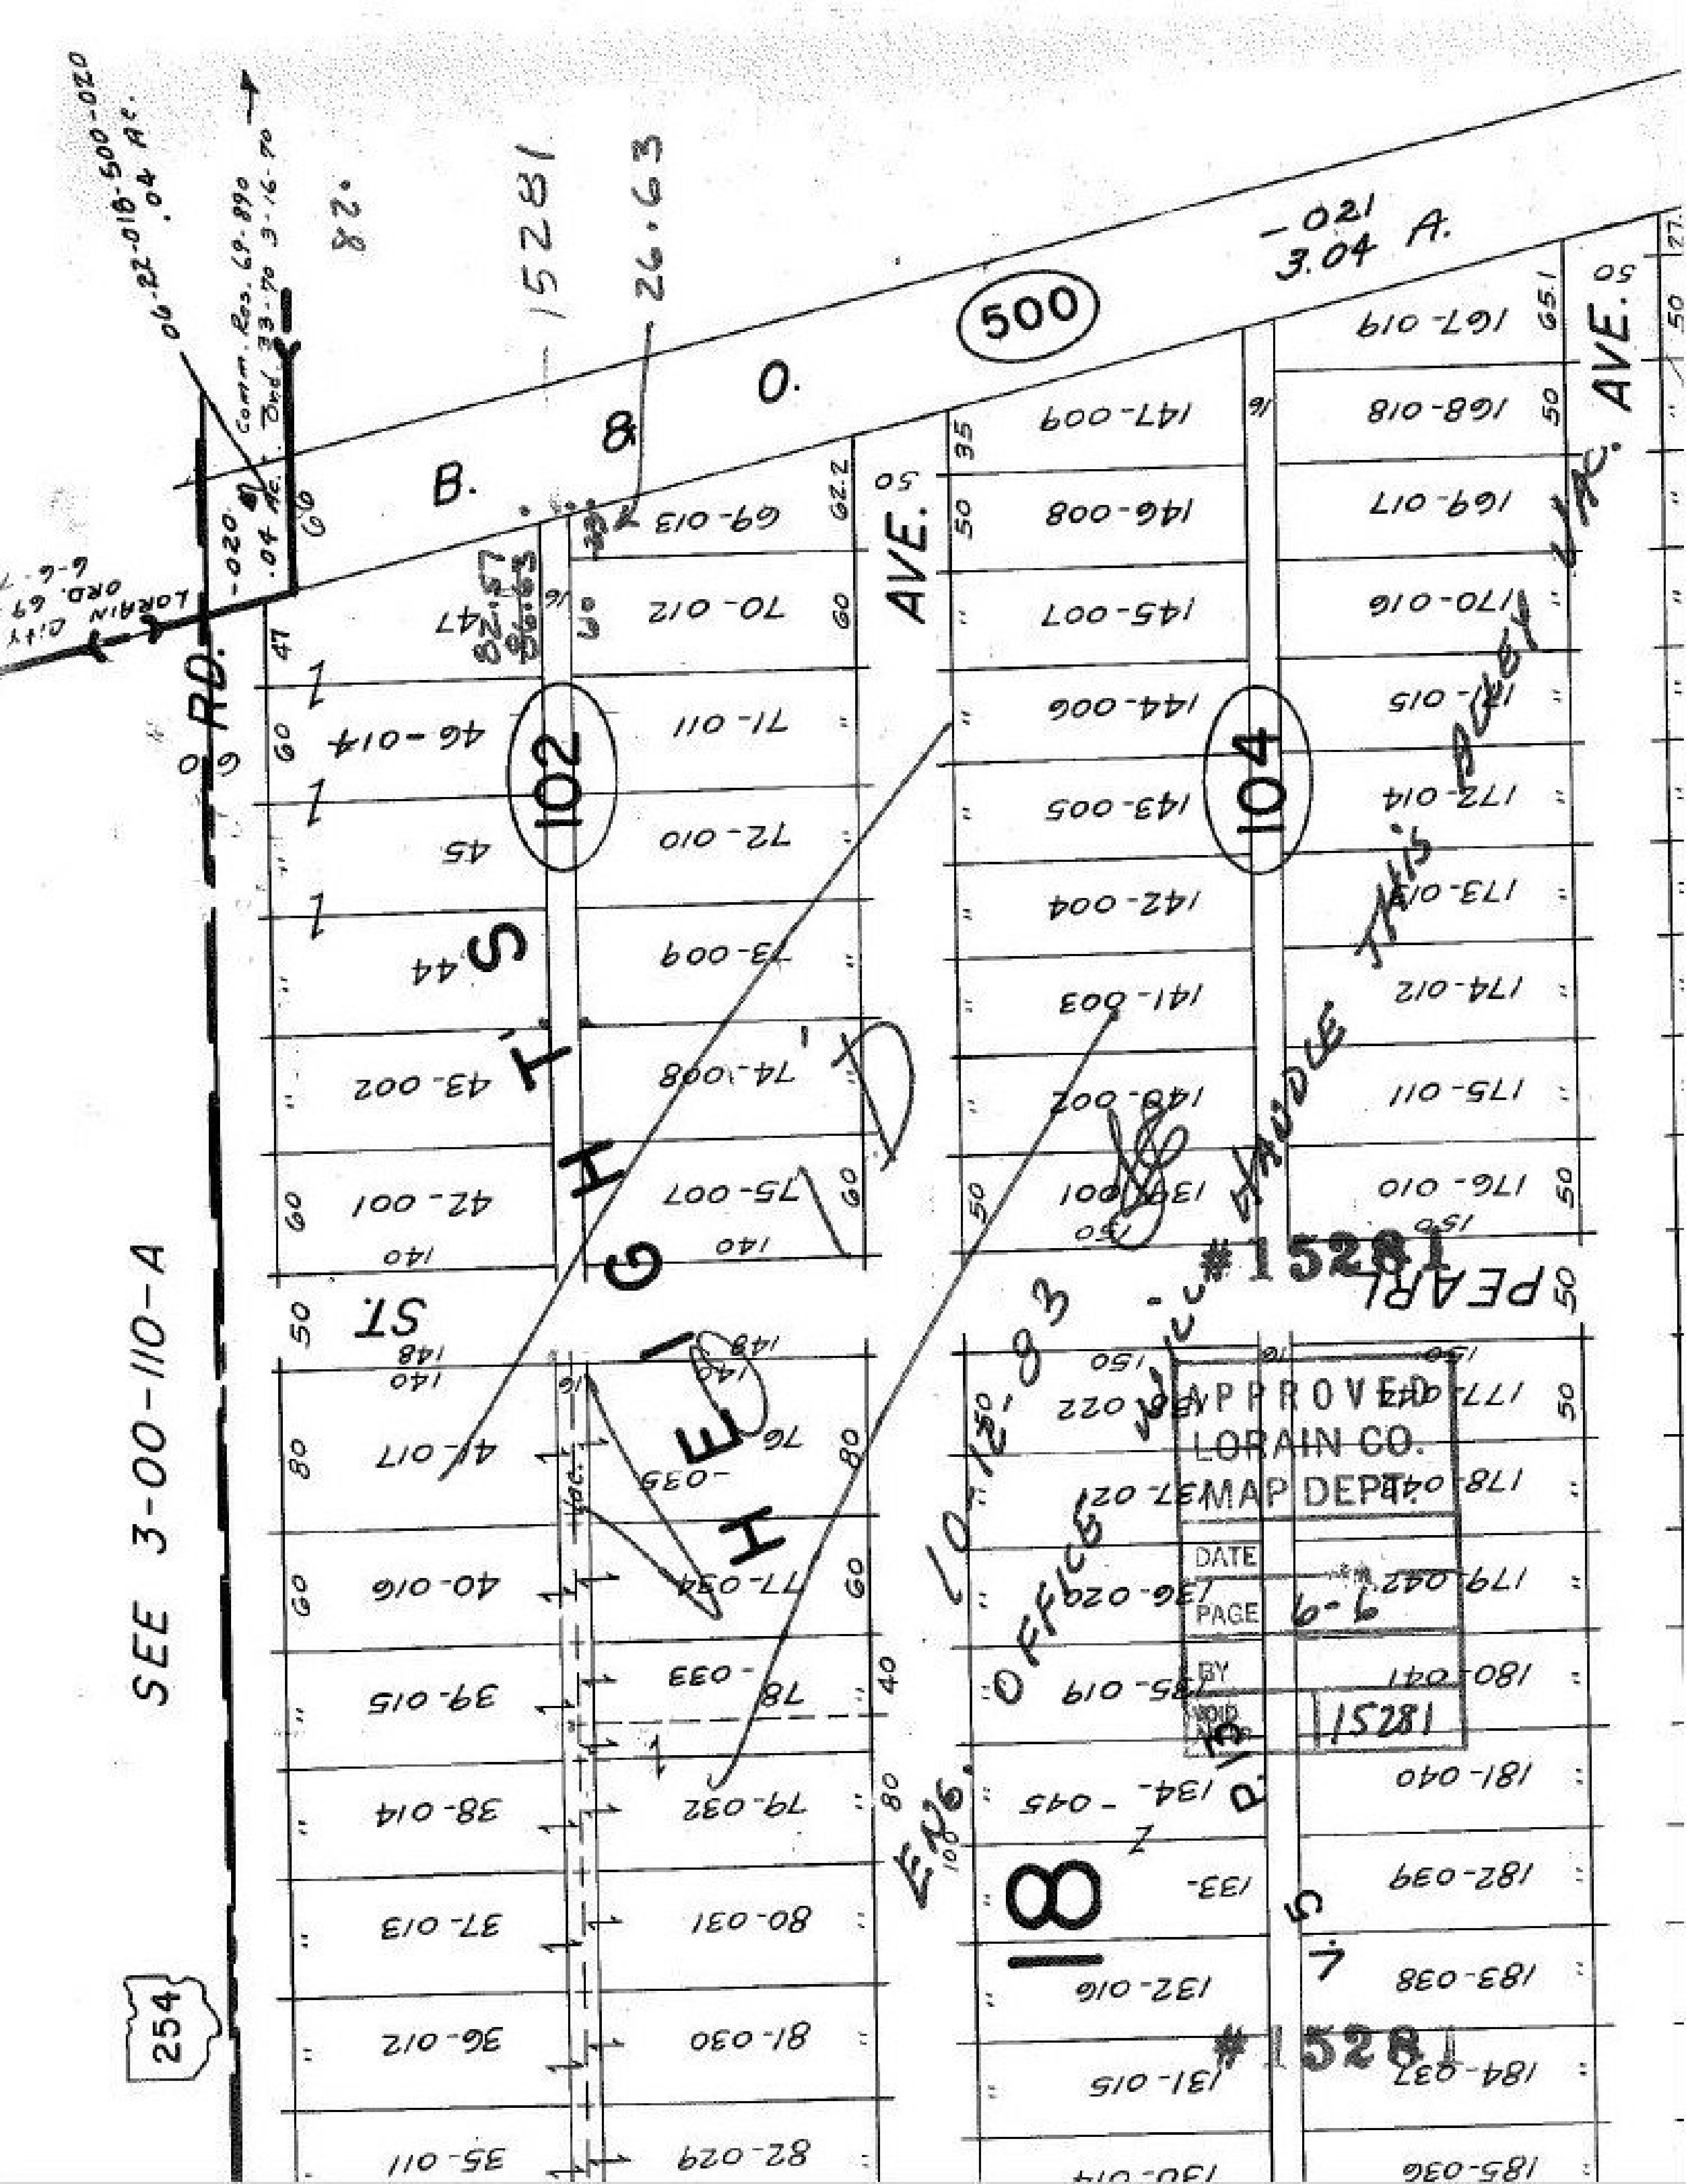

06-22-018-500-020
.04 Ac.
Comm. Res. 69-890
Ord. 33-70 3-16-70
City Lorain Ord. 69 6-6
-020 .04 Ac.
B. & O.
500
-021
3.04 A.
15281
26.63
G RD.
AVE.
AVE.
ST.
PEARL
102
104
18
SEE 3-00-110-A
254
APPROVED
LORAIN CO.
MAP DEPT.
DATE
PAGE 6-6
BY
VOID NO.
15281
#15281
69-013
70-012
71-011
72-010
73-009
74-008
75-007
76
-035
77-034
78
-033
79-032
80-031
81-030
82-029
46-014
45
44
43-002
42-001
41-017
40-016
39-015
38-014
37-013
36-012
35-011
147-009
146-008
145-007
144-006
143-005
142-004
141-003
140-002
139-001
138-022
137-021
136-020
135-019
134-045
133-
132-016
131-015
130-014
167-019
168-018
169-017
170-016
171-015
172-014
173-013
174-012
175-011
176-010
177-043
178-044
179-042
180-041
181-040
182-039
183-038
184-037
185-036