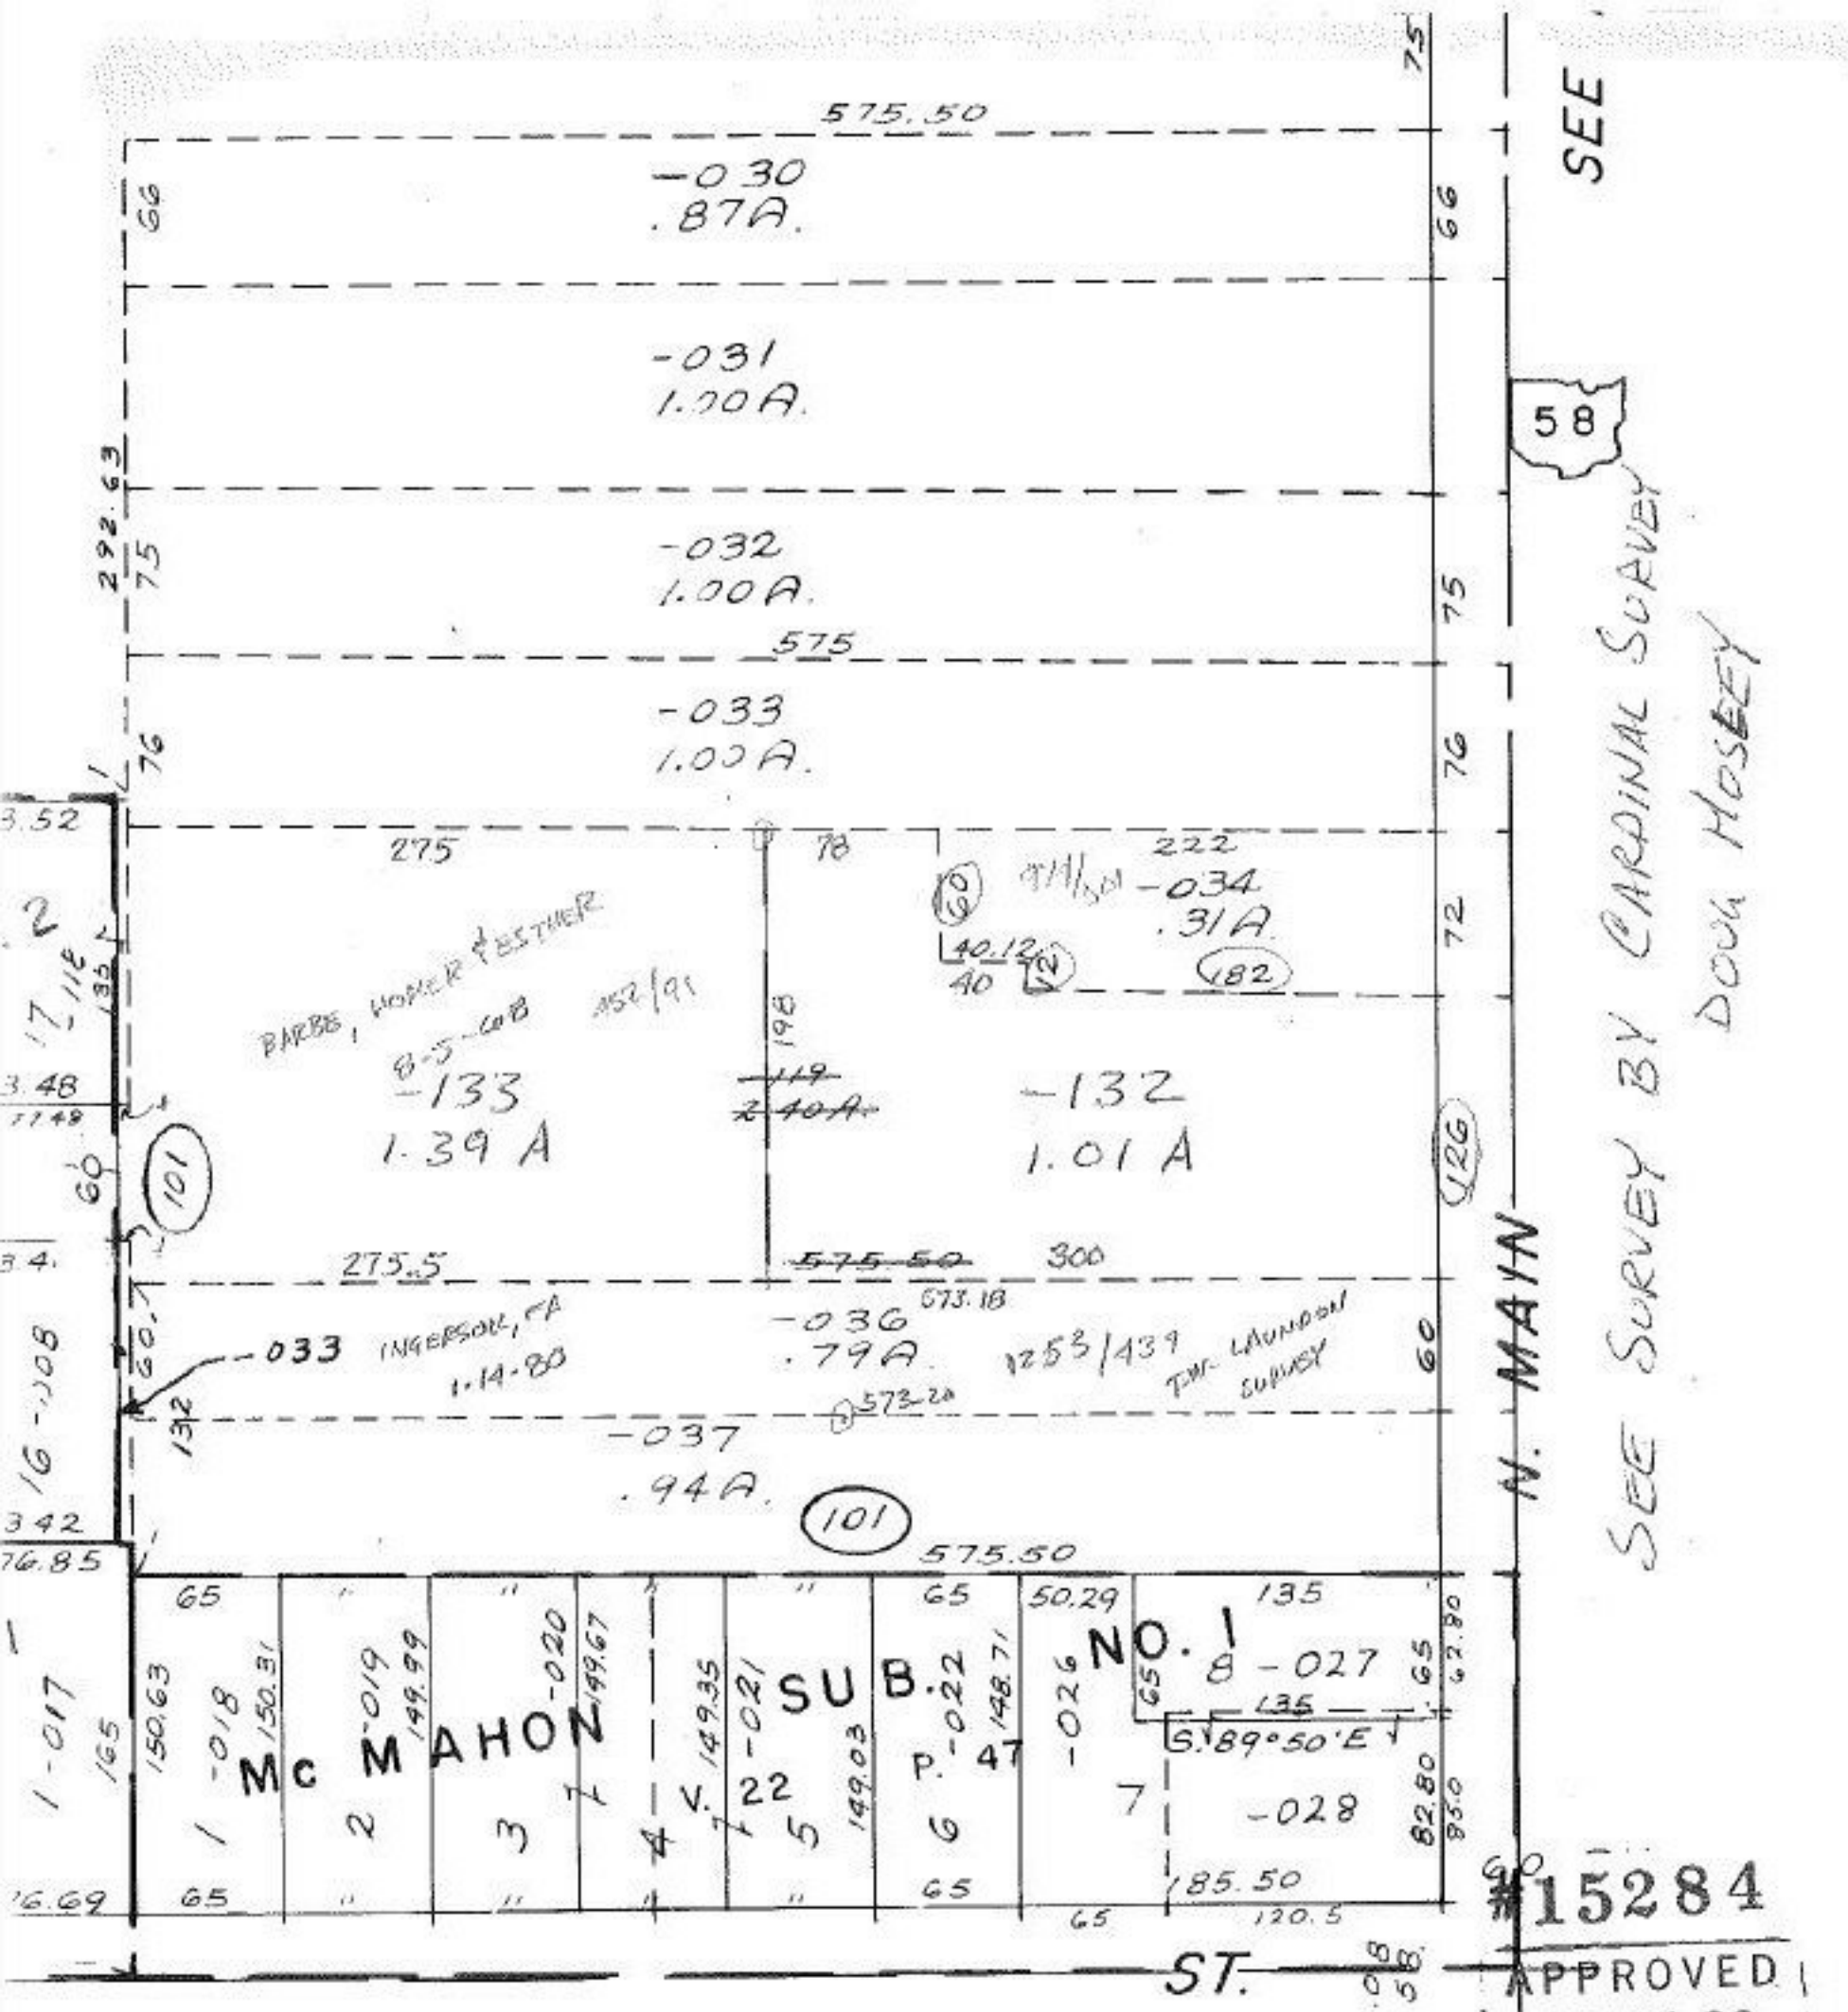

#15284

APPROVED
LORAIN CO.
MAP DEPT.

DATE 9.30.83
PAGE 18.00.028.B
BY T. McNair
VOID AFTER

T.H. 7/9/84