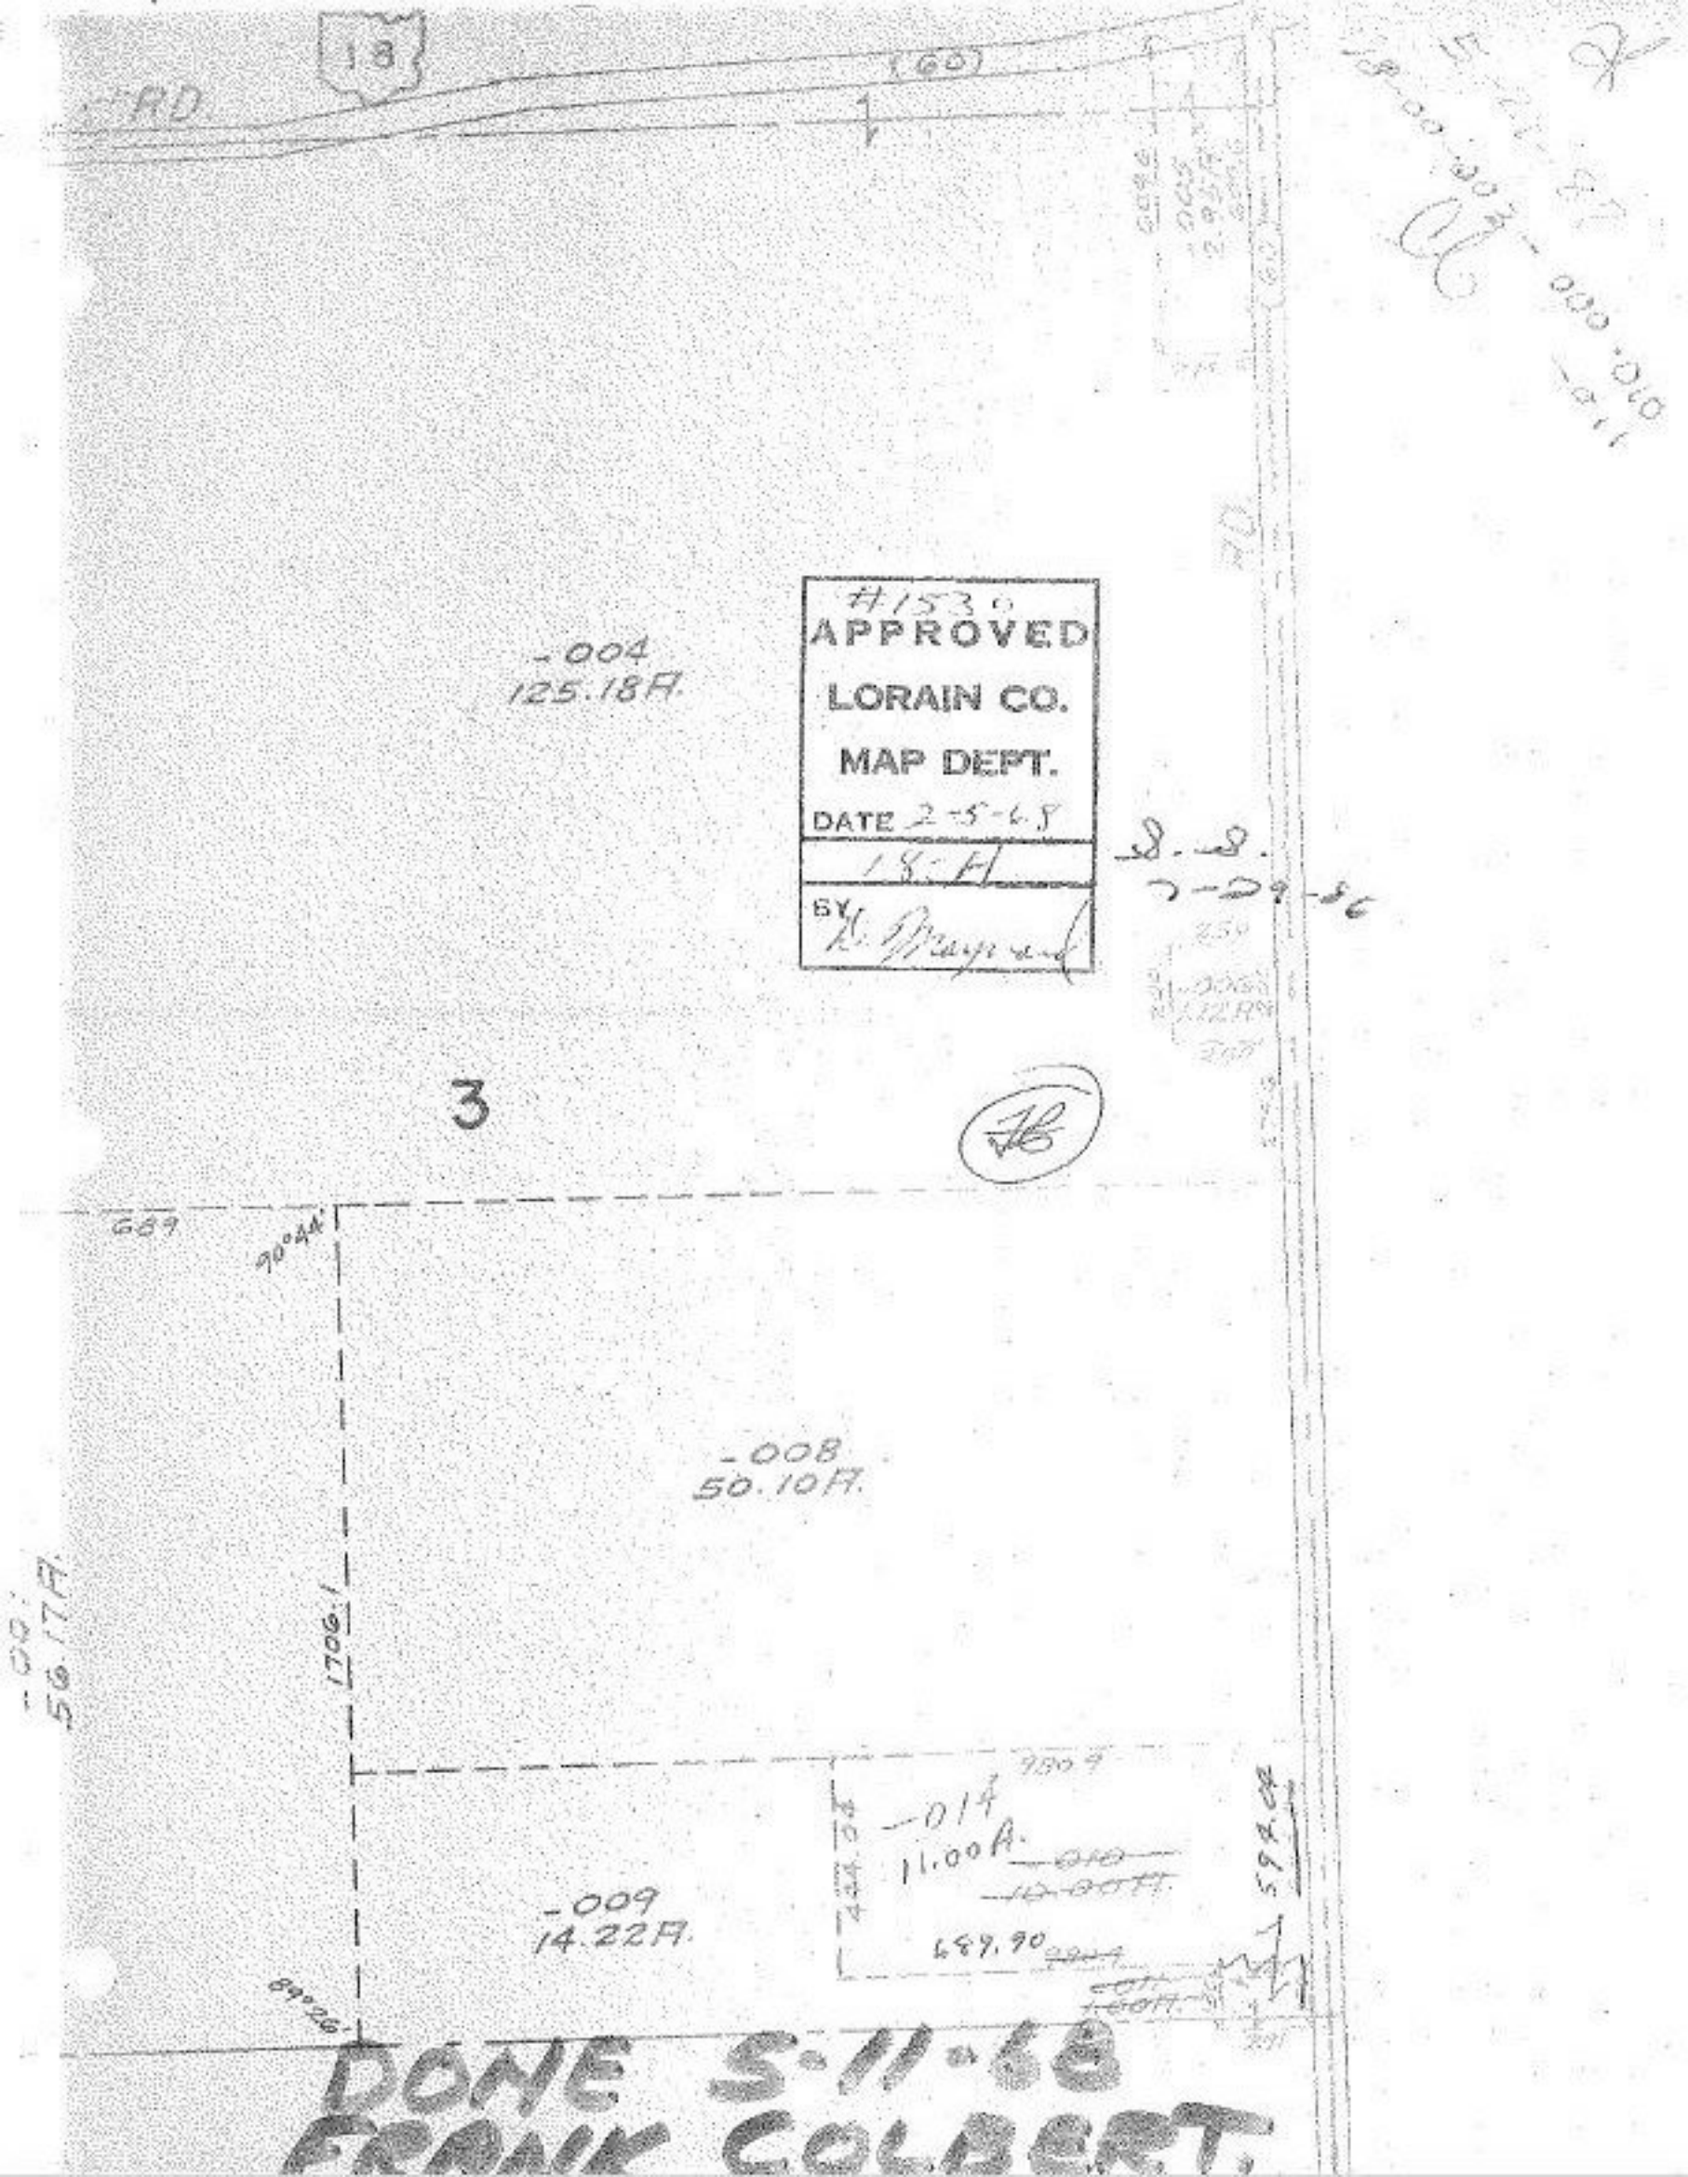

DONE 5-11-68
FRANK COLBERT.