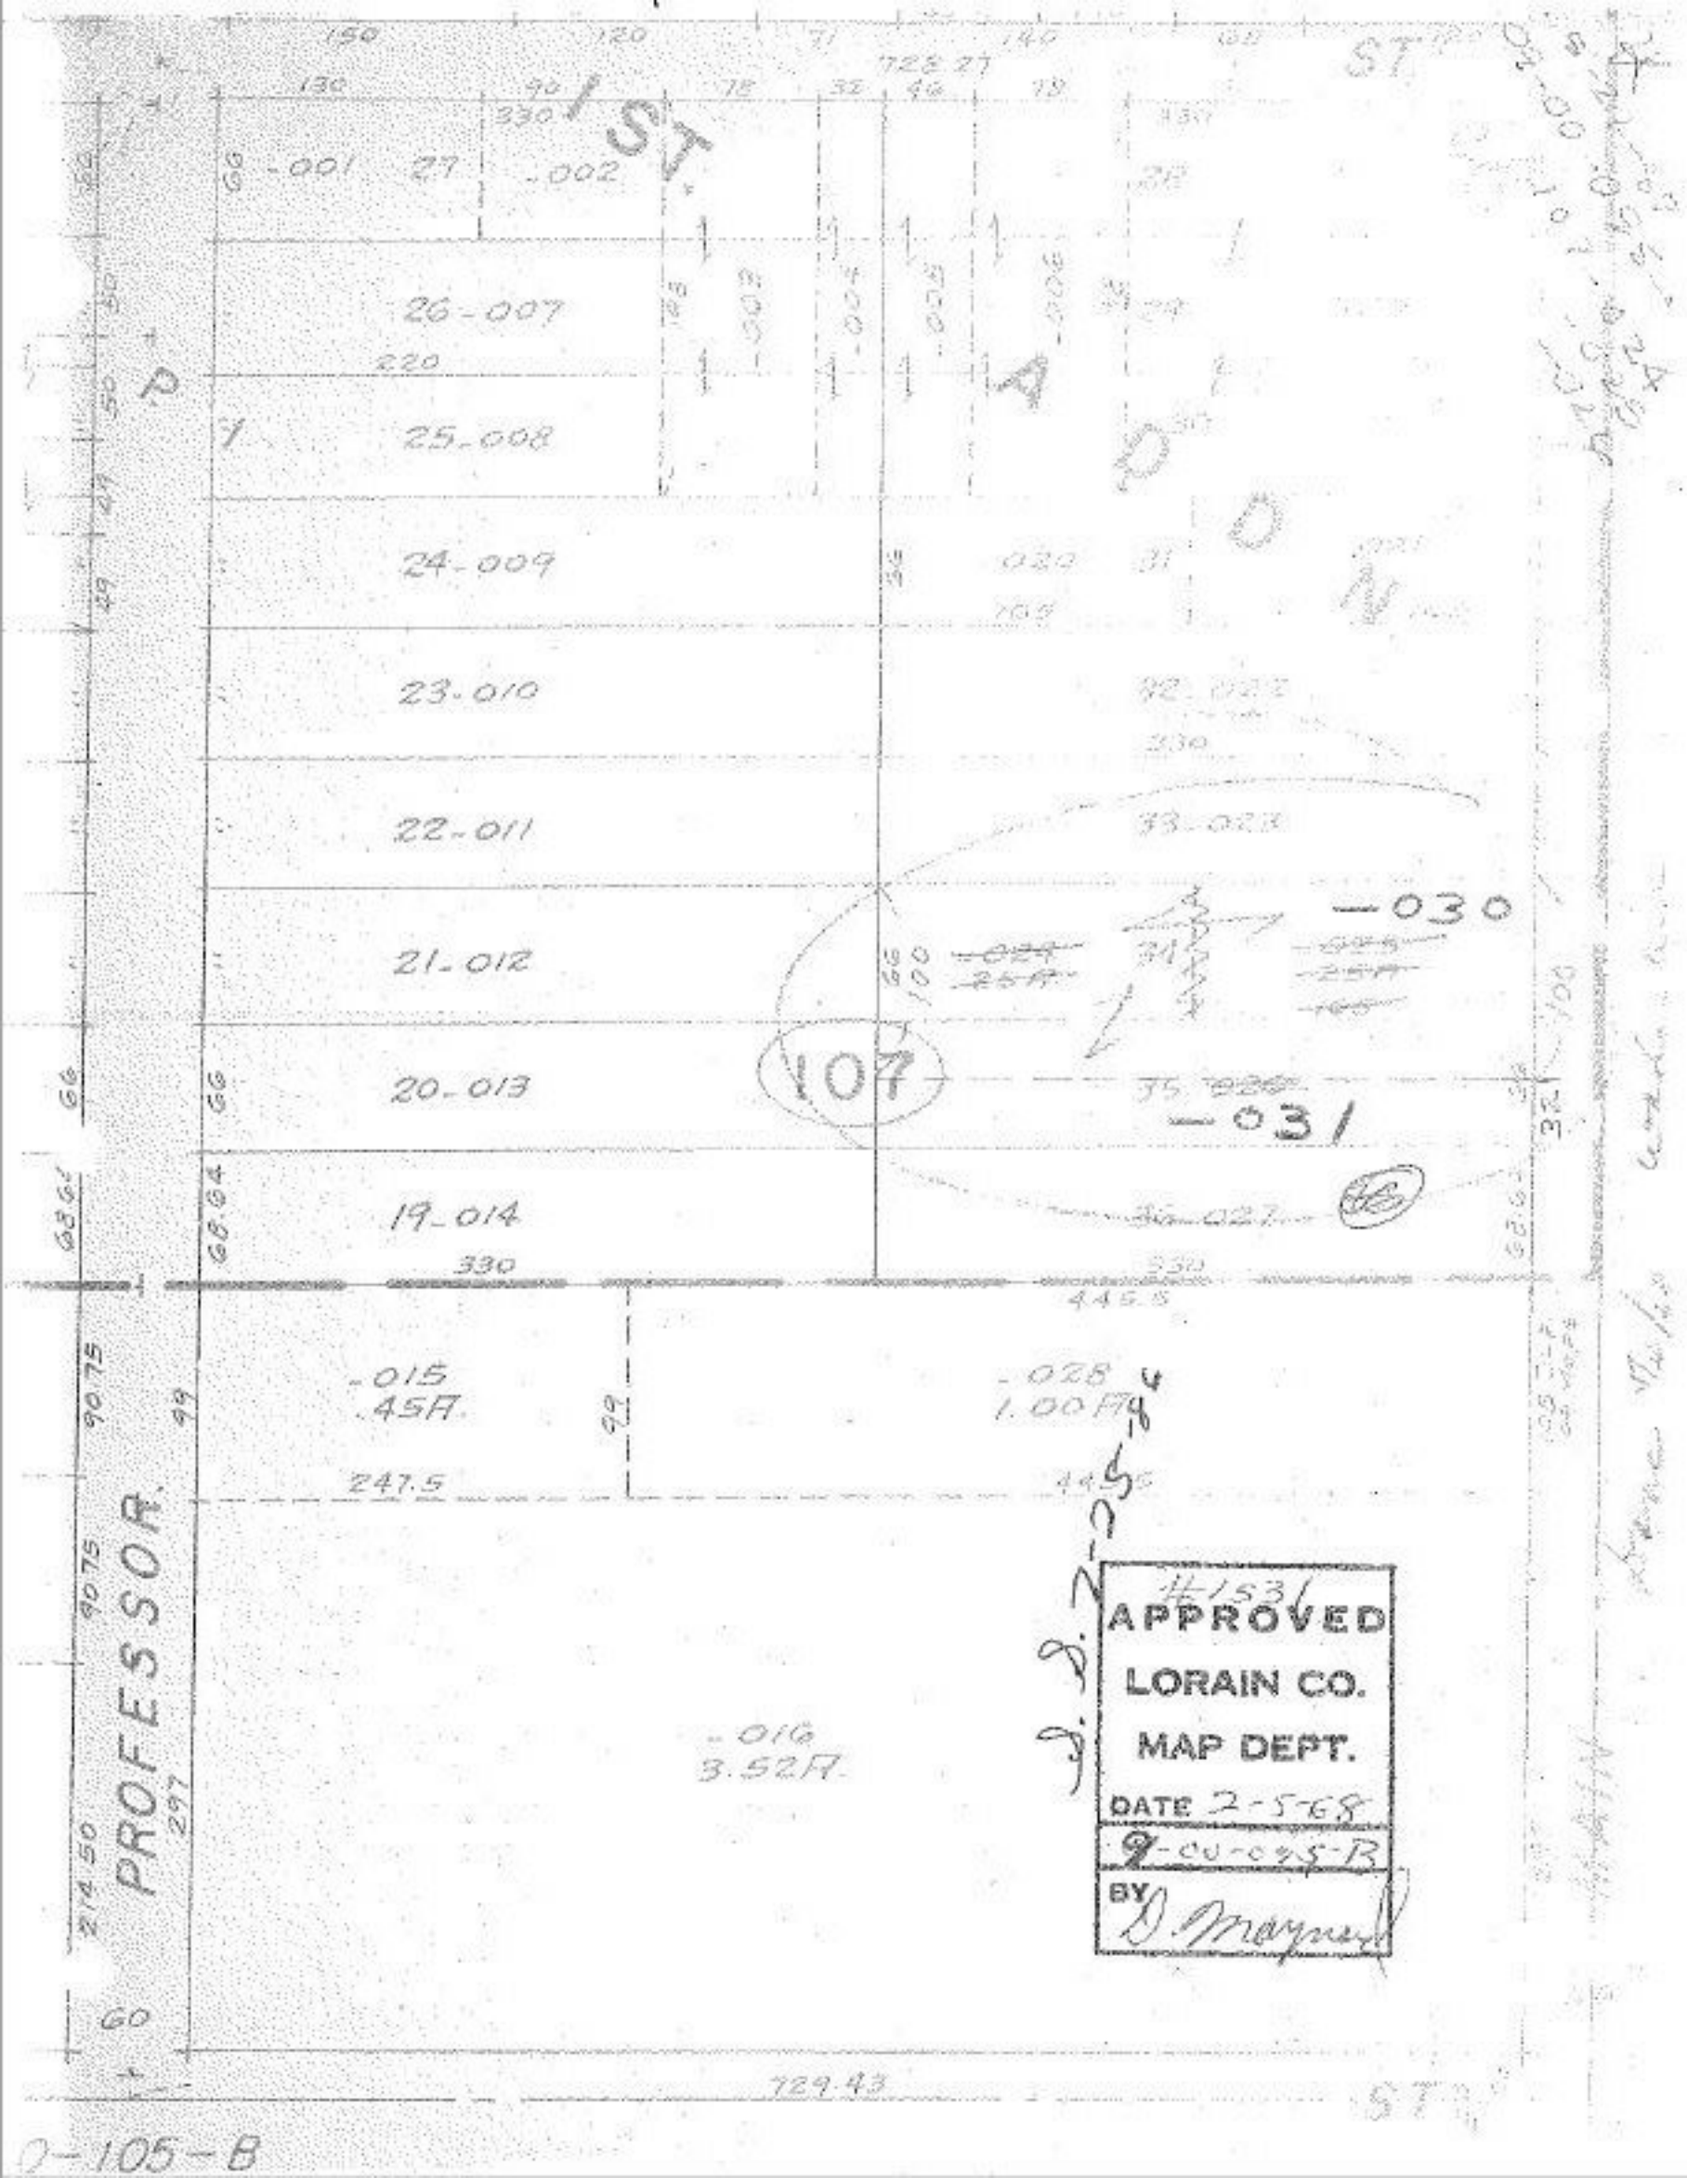
1ST.
26-007
25-008
24-009
23-010
22-011
21-012
20-013
19-014
-001
-002
-003
-004
-005
-006
-007
-008
-009
-010
-011
-012
-013
-014
-015
.45A.
-016
3.52A.
-028
1.00A.
-030
-031
107
PROFESSOR.
729.43
APPROVED
LORAIN CO.
MAP DEPT.
DATE 2-5-68
9-00-025-B
BY D. Mayne

0-105-B