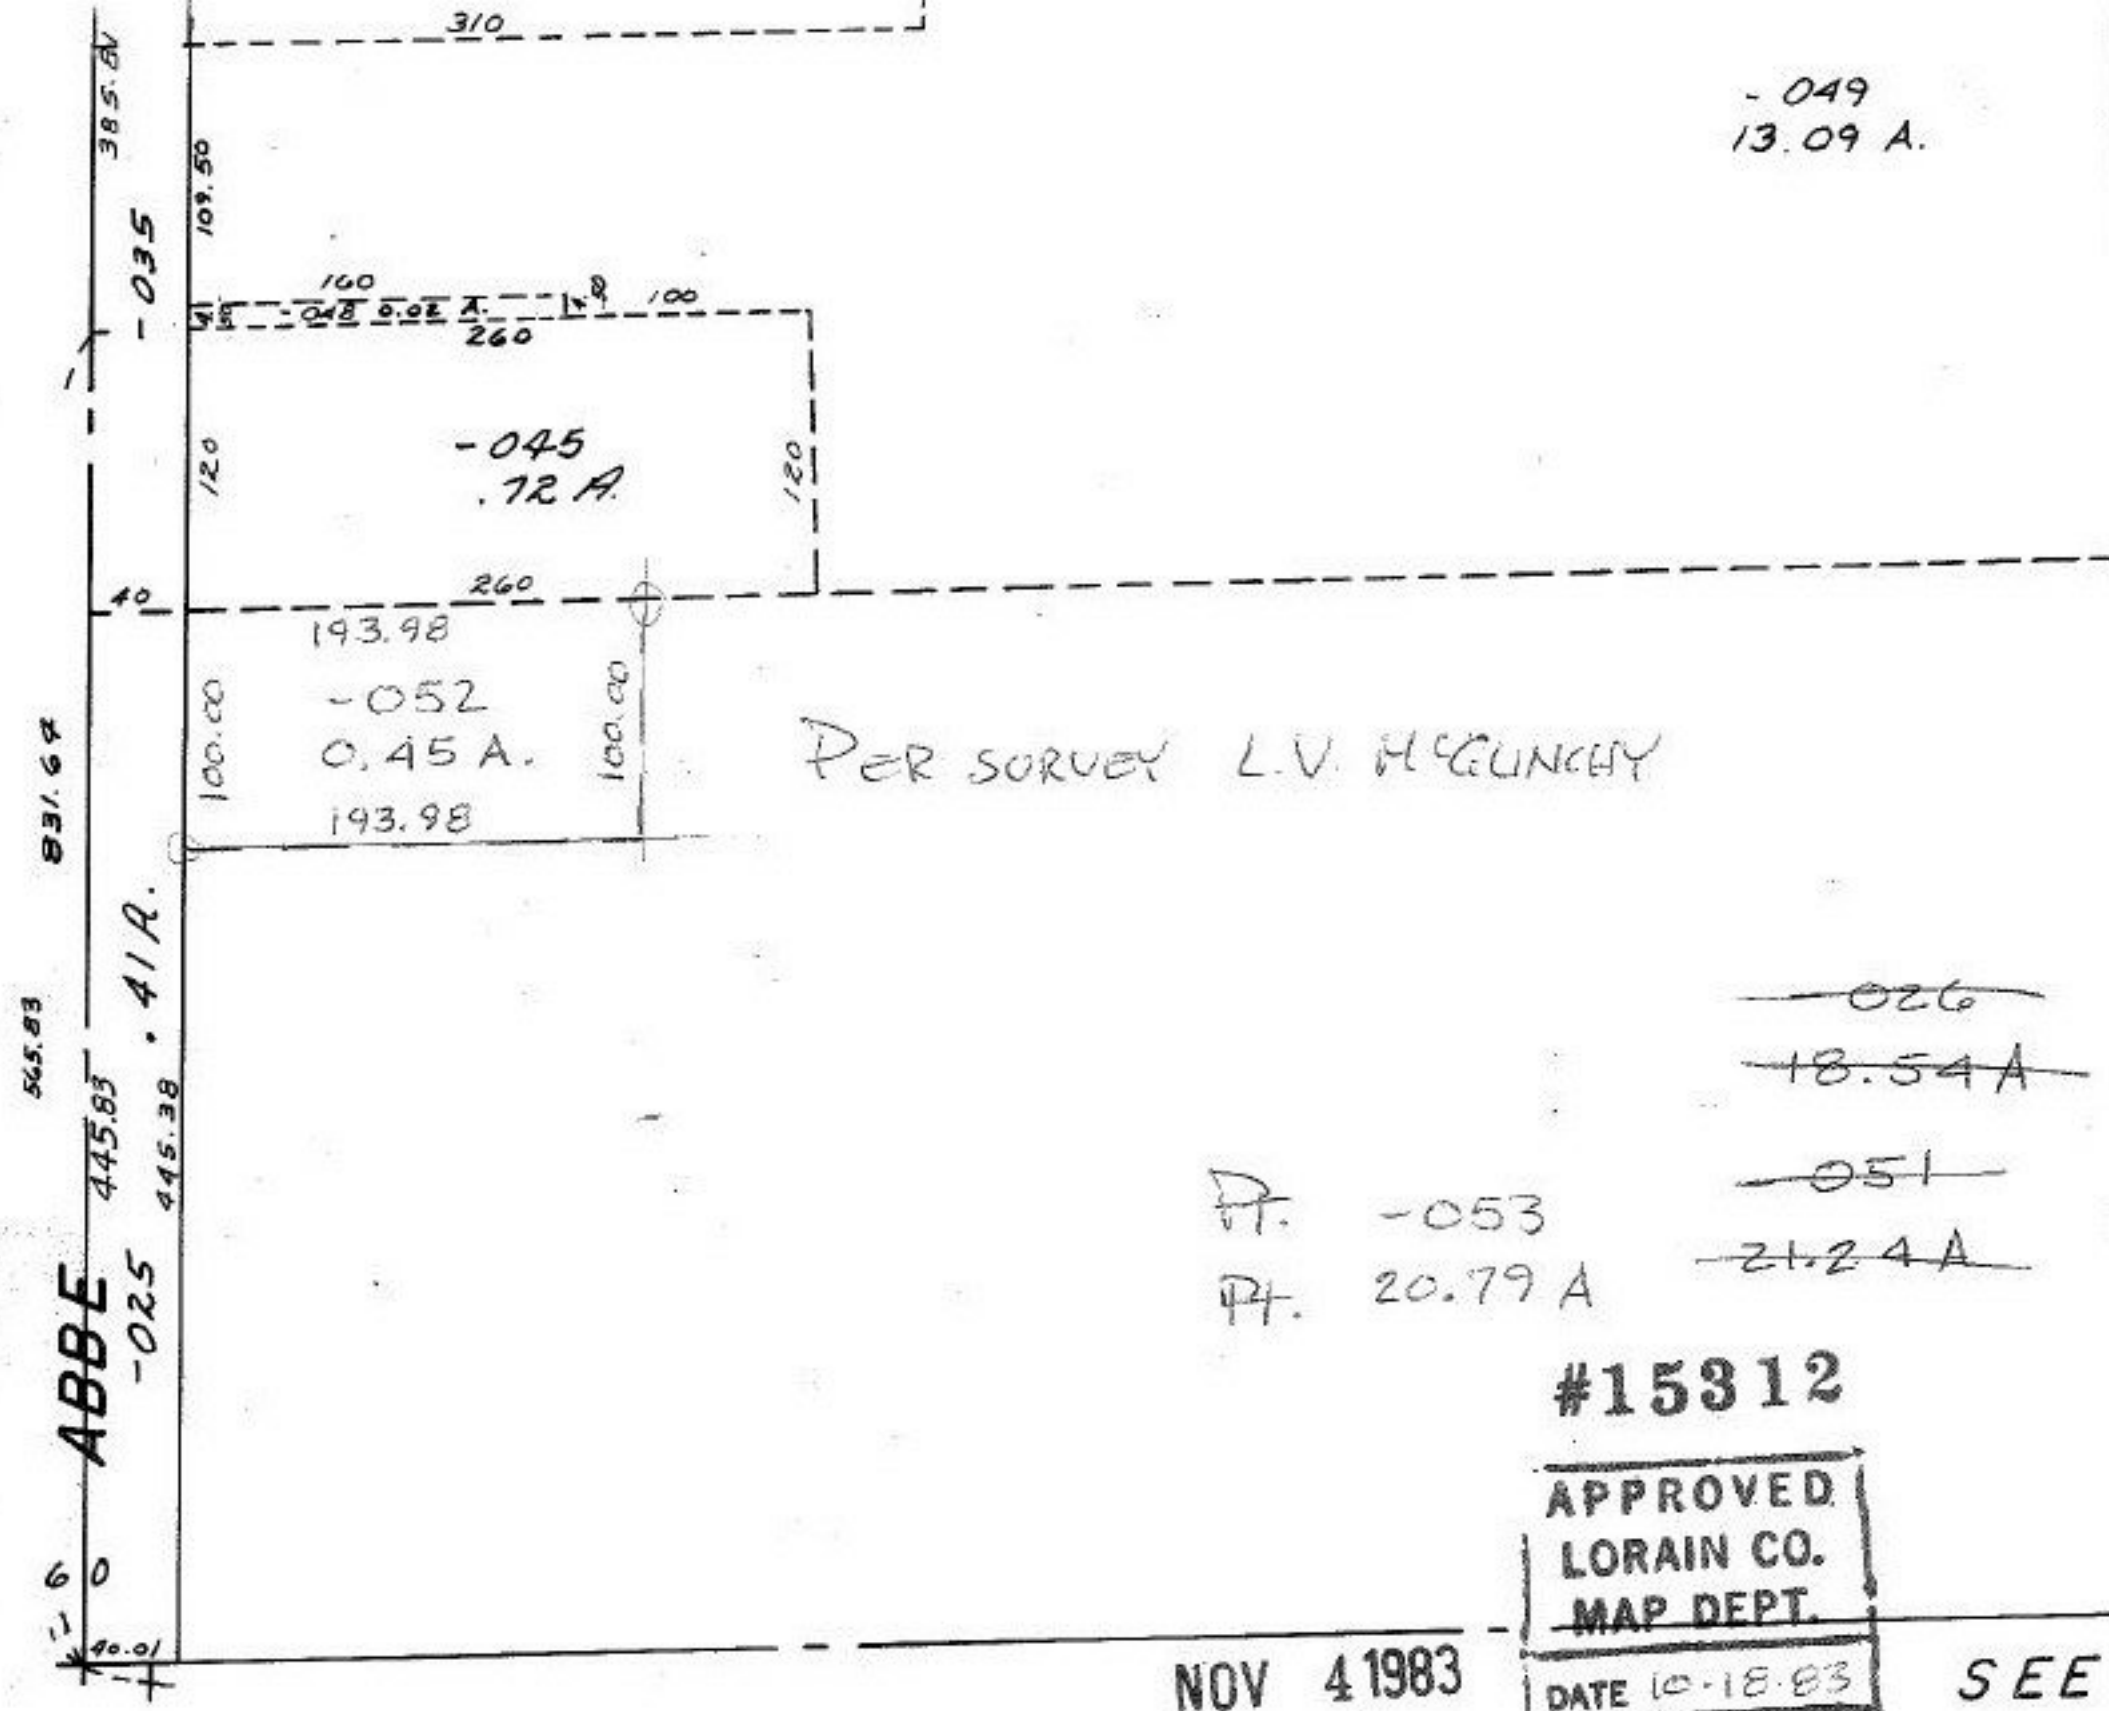
310
385.8V
109.50
-035
160
-048 0.02 A.
100
260
-045
.72 A.
120
120
40
260
193.98
-052
0.45 A.
100.00
100.00
193.98
831.64
565.83
445.83
445.38
.41 A.
ABBE
-025
60
40.01
-049
13.09 A.
PER SURVEY L.V. McGUNCHY
~~-026~~
~~18.54 A~~
~~-051~~
~~21.24 A~~
Pt. -053
Pt. 20.79 A
#15312
APPROVED
LORAIN CO.
MAP DEPT.
DATE 10-18-83
PAGE 3.00.001-A
BY T McNair
NOV 4 1983
SEE