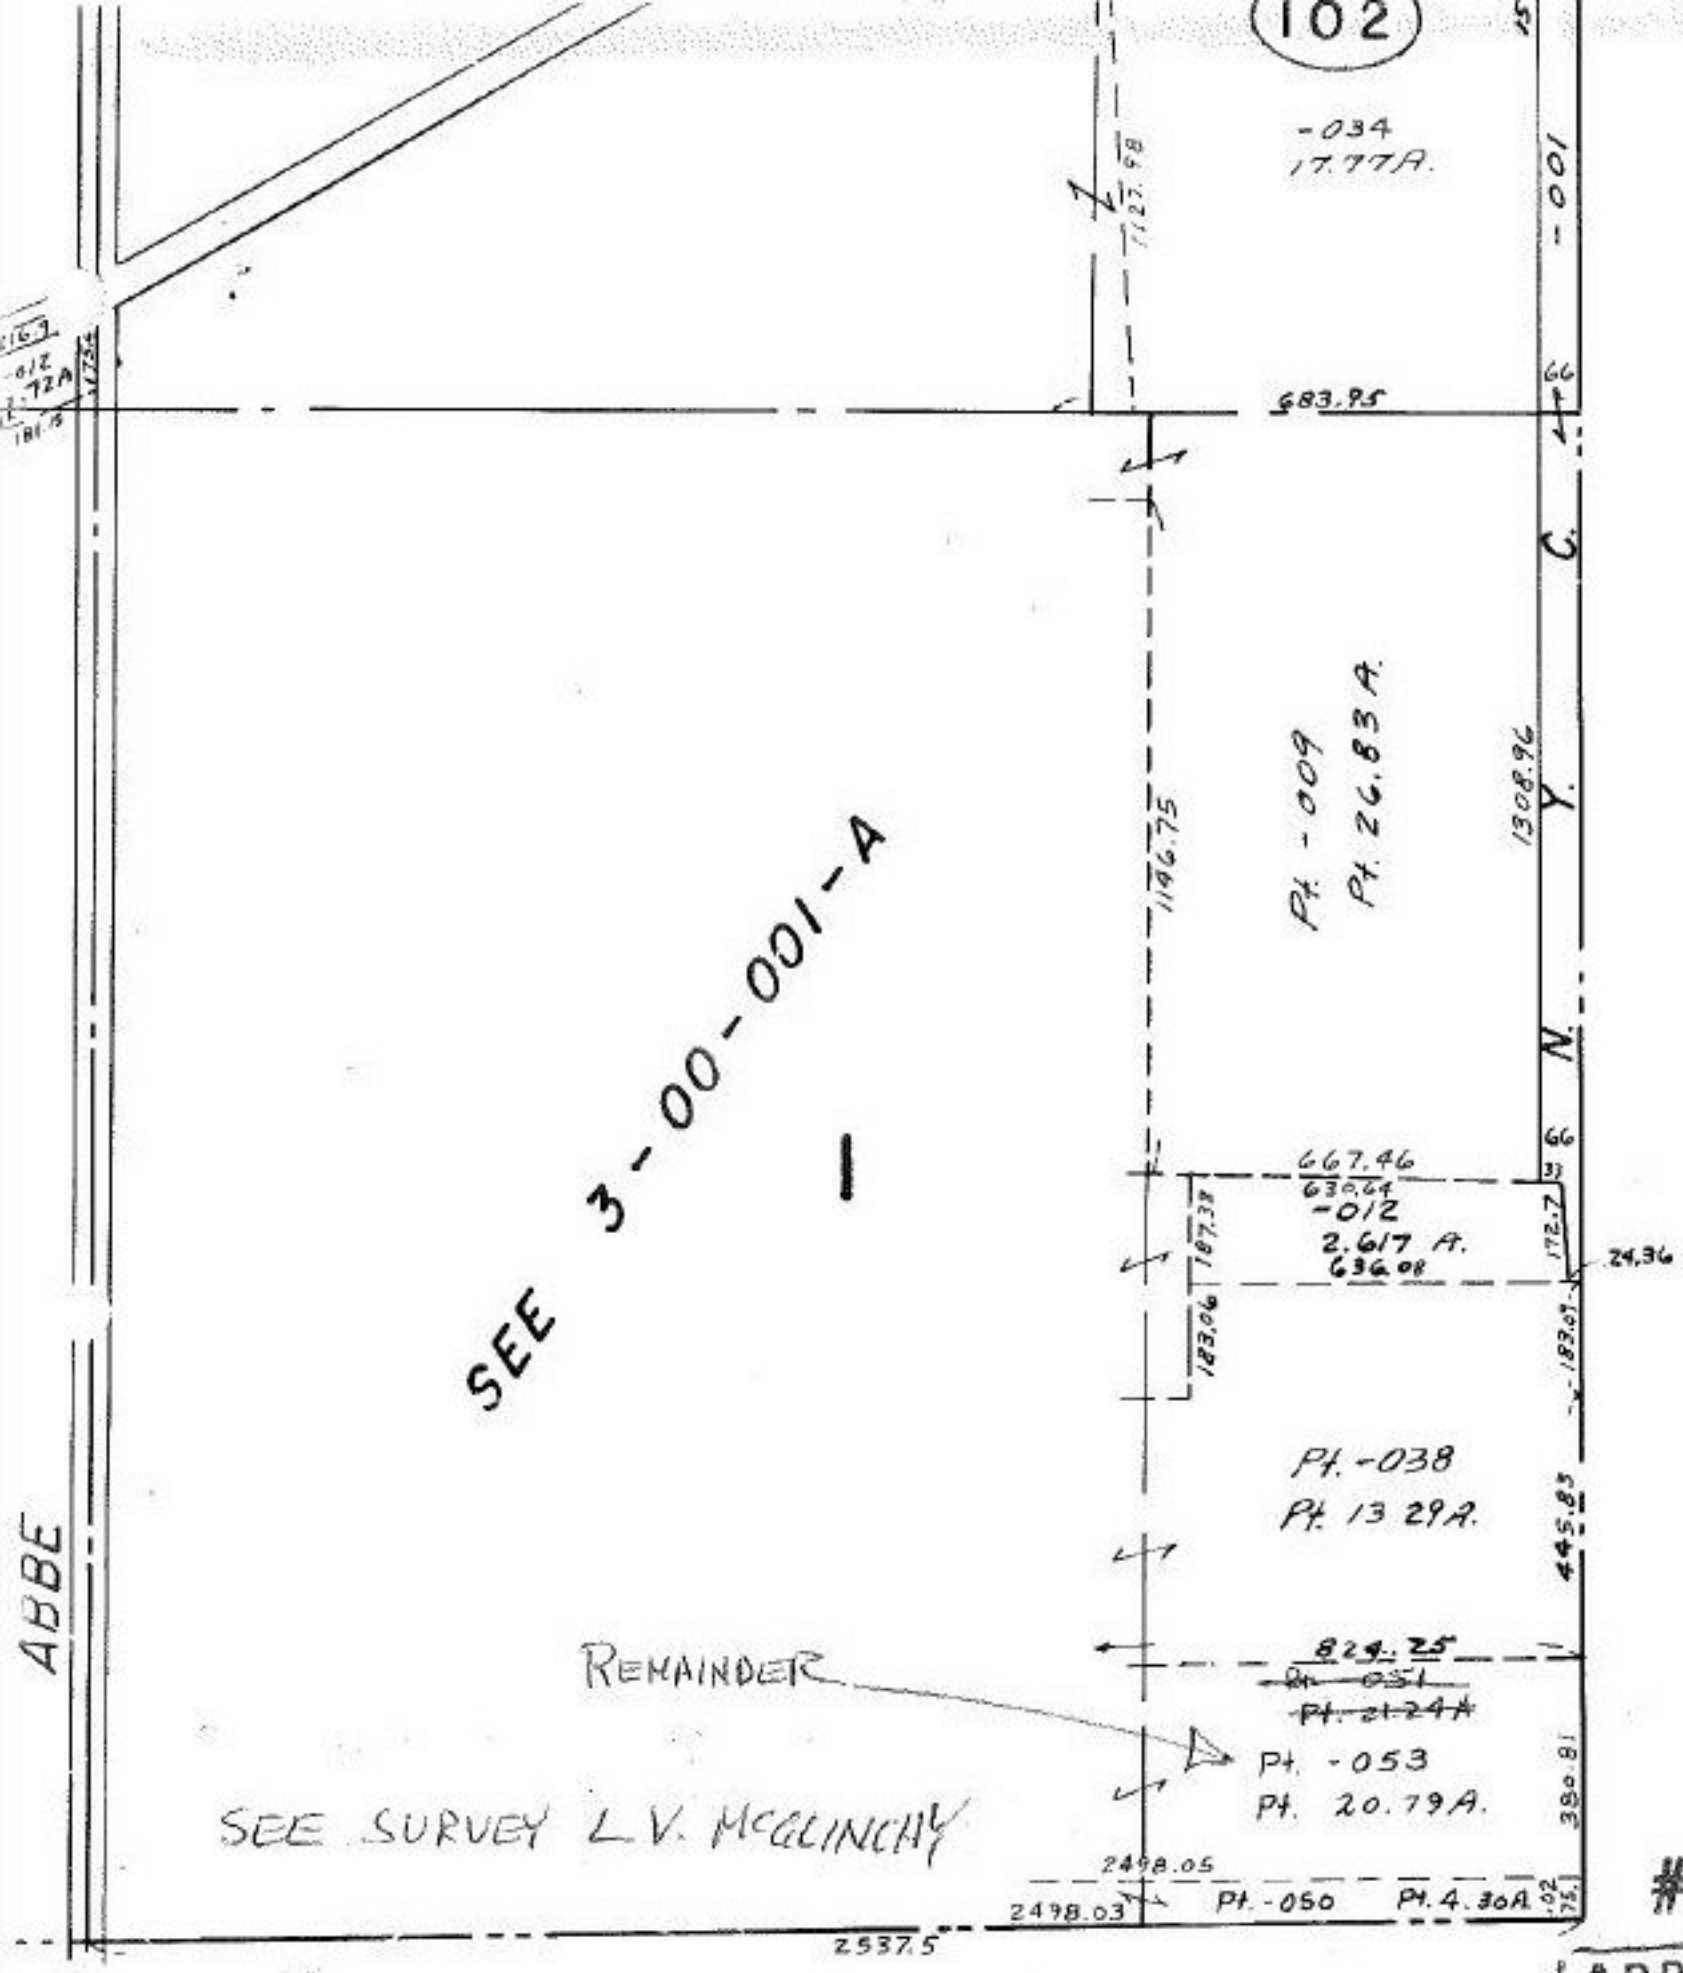

#15312

NOV 4 1983

APPROVED
LORAIN CO.
MAP DEPT.
DATE 10.18.83
PAGE 3-L
BY T. McNair
VOID
AFTER

LOTS 1 THRU 5
& 11 " 15