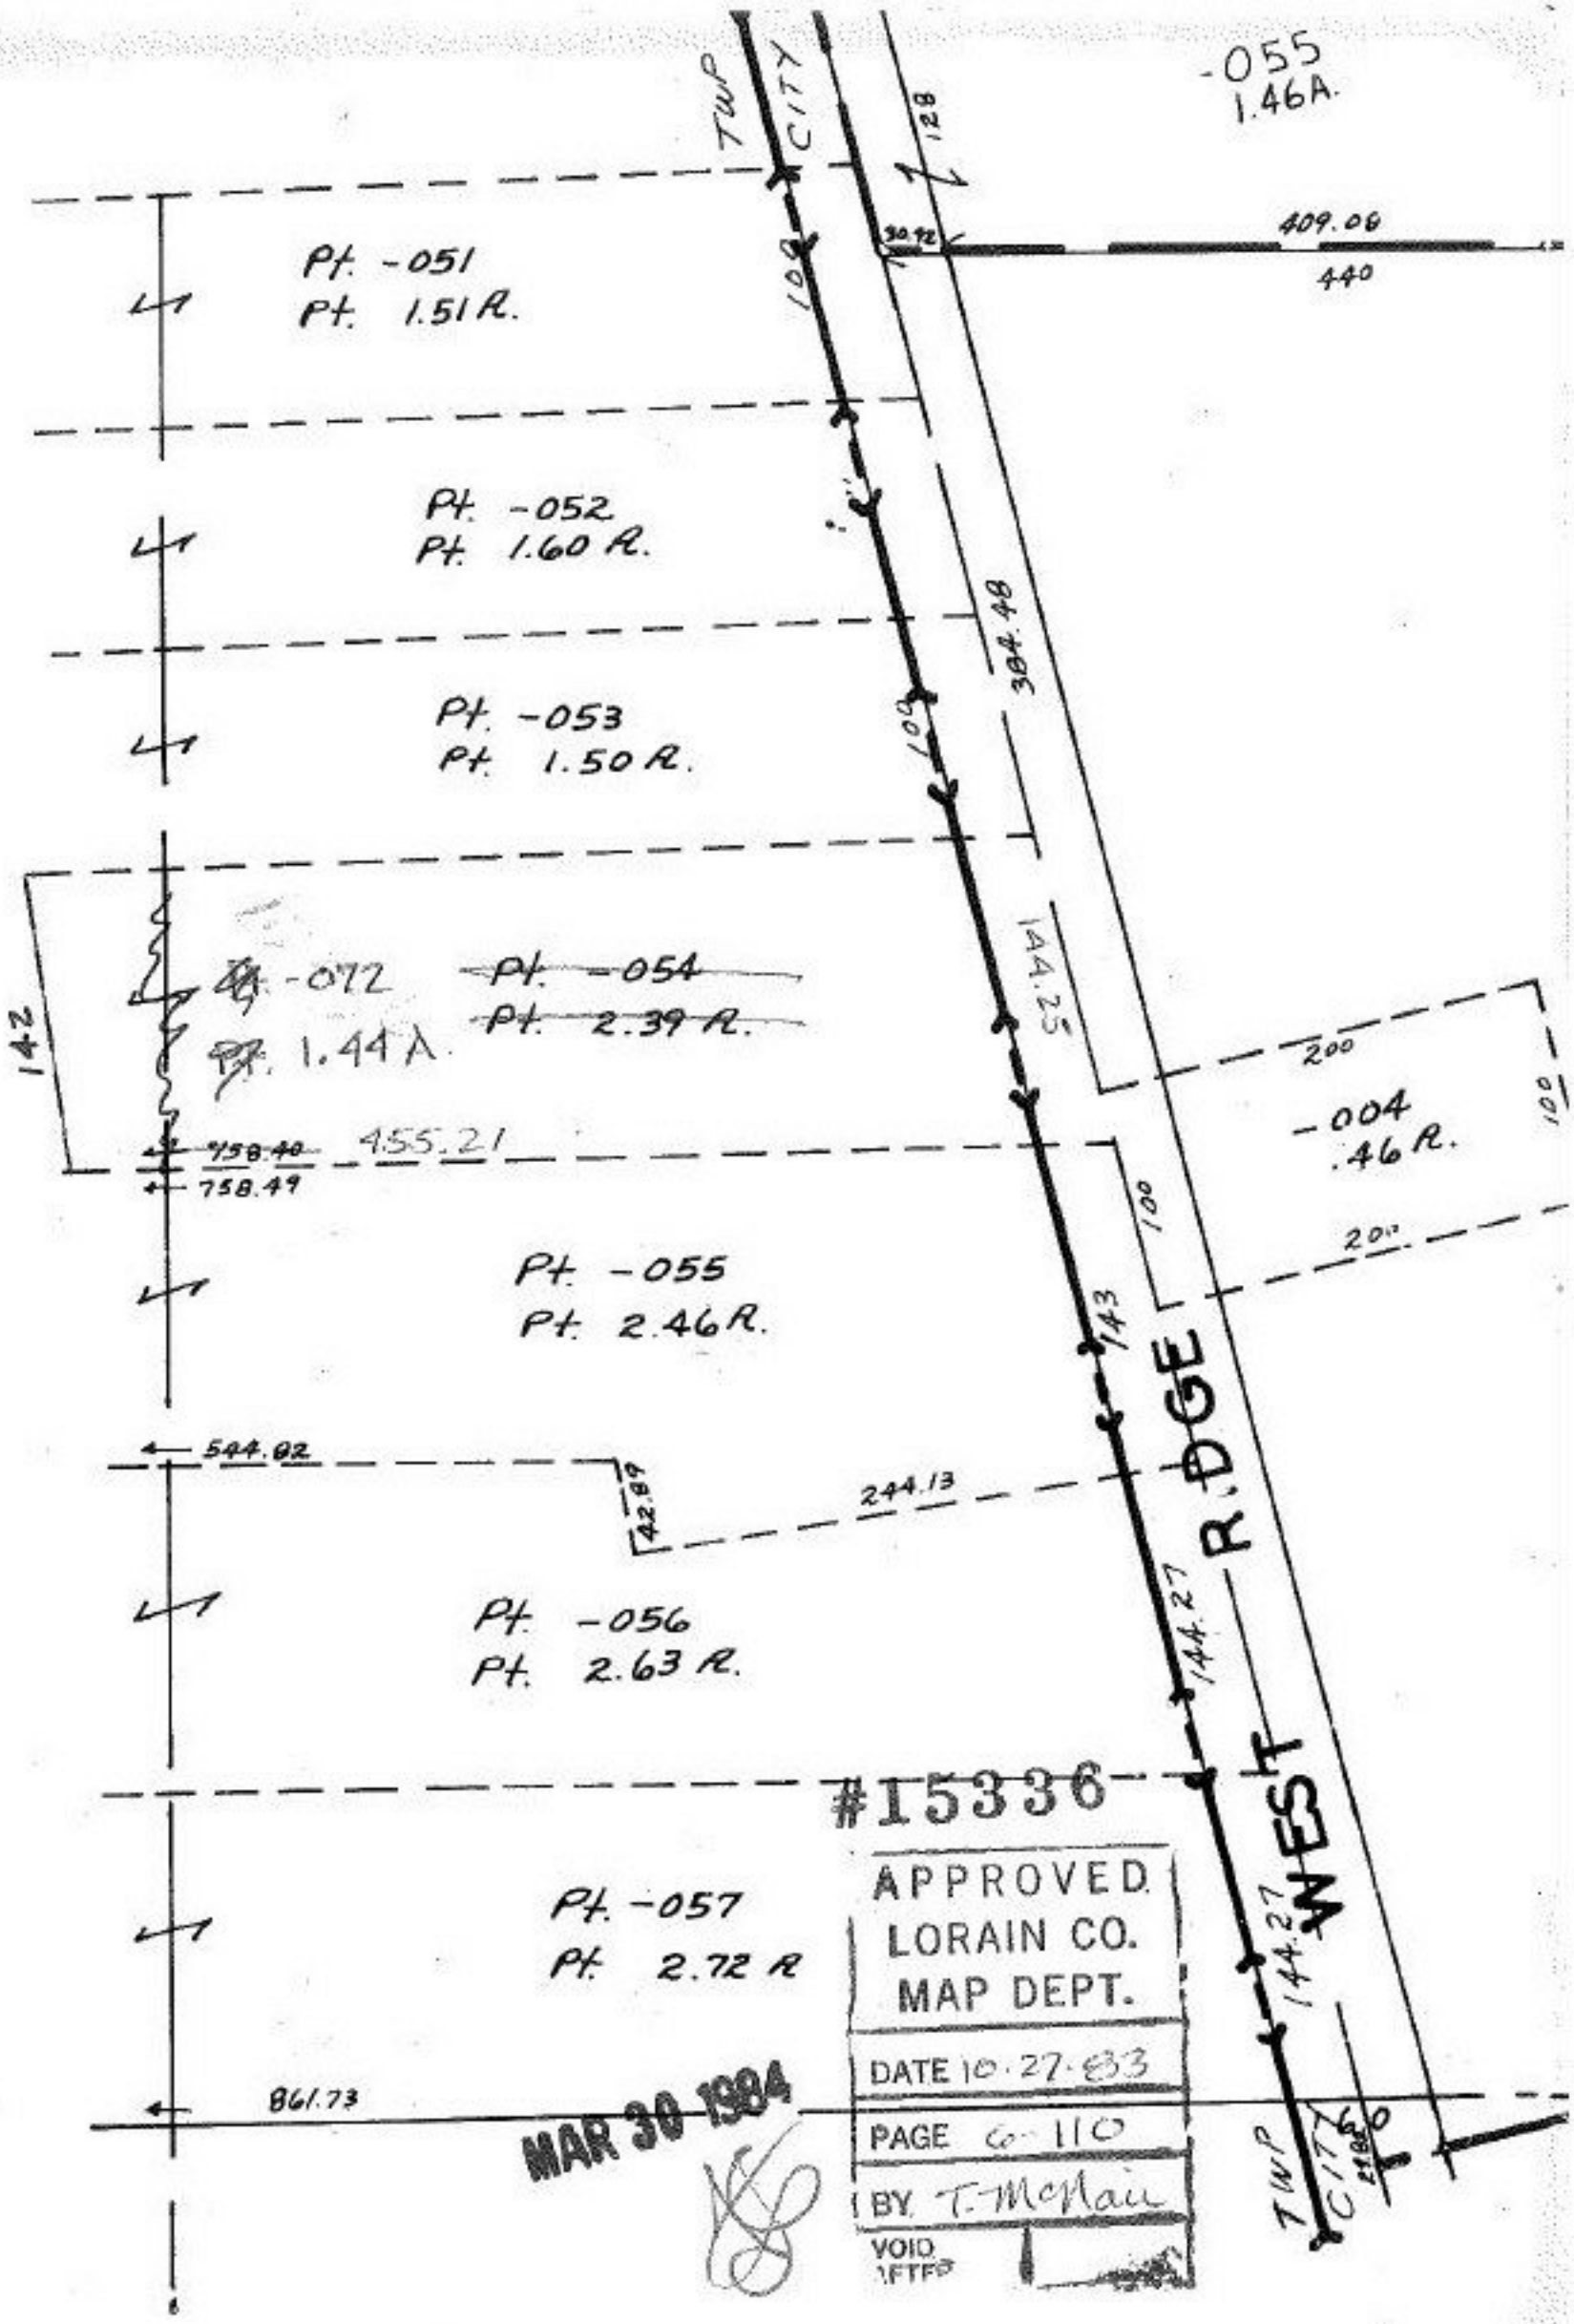

APPROVED
LORAIN CO.
MAP DEPT.
DATE 10-27-83
PAGE 6-110
BY T. McNair
VOID AFTER

FLYRIA