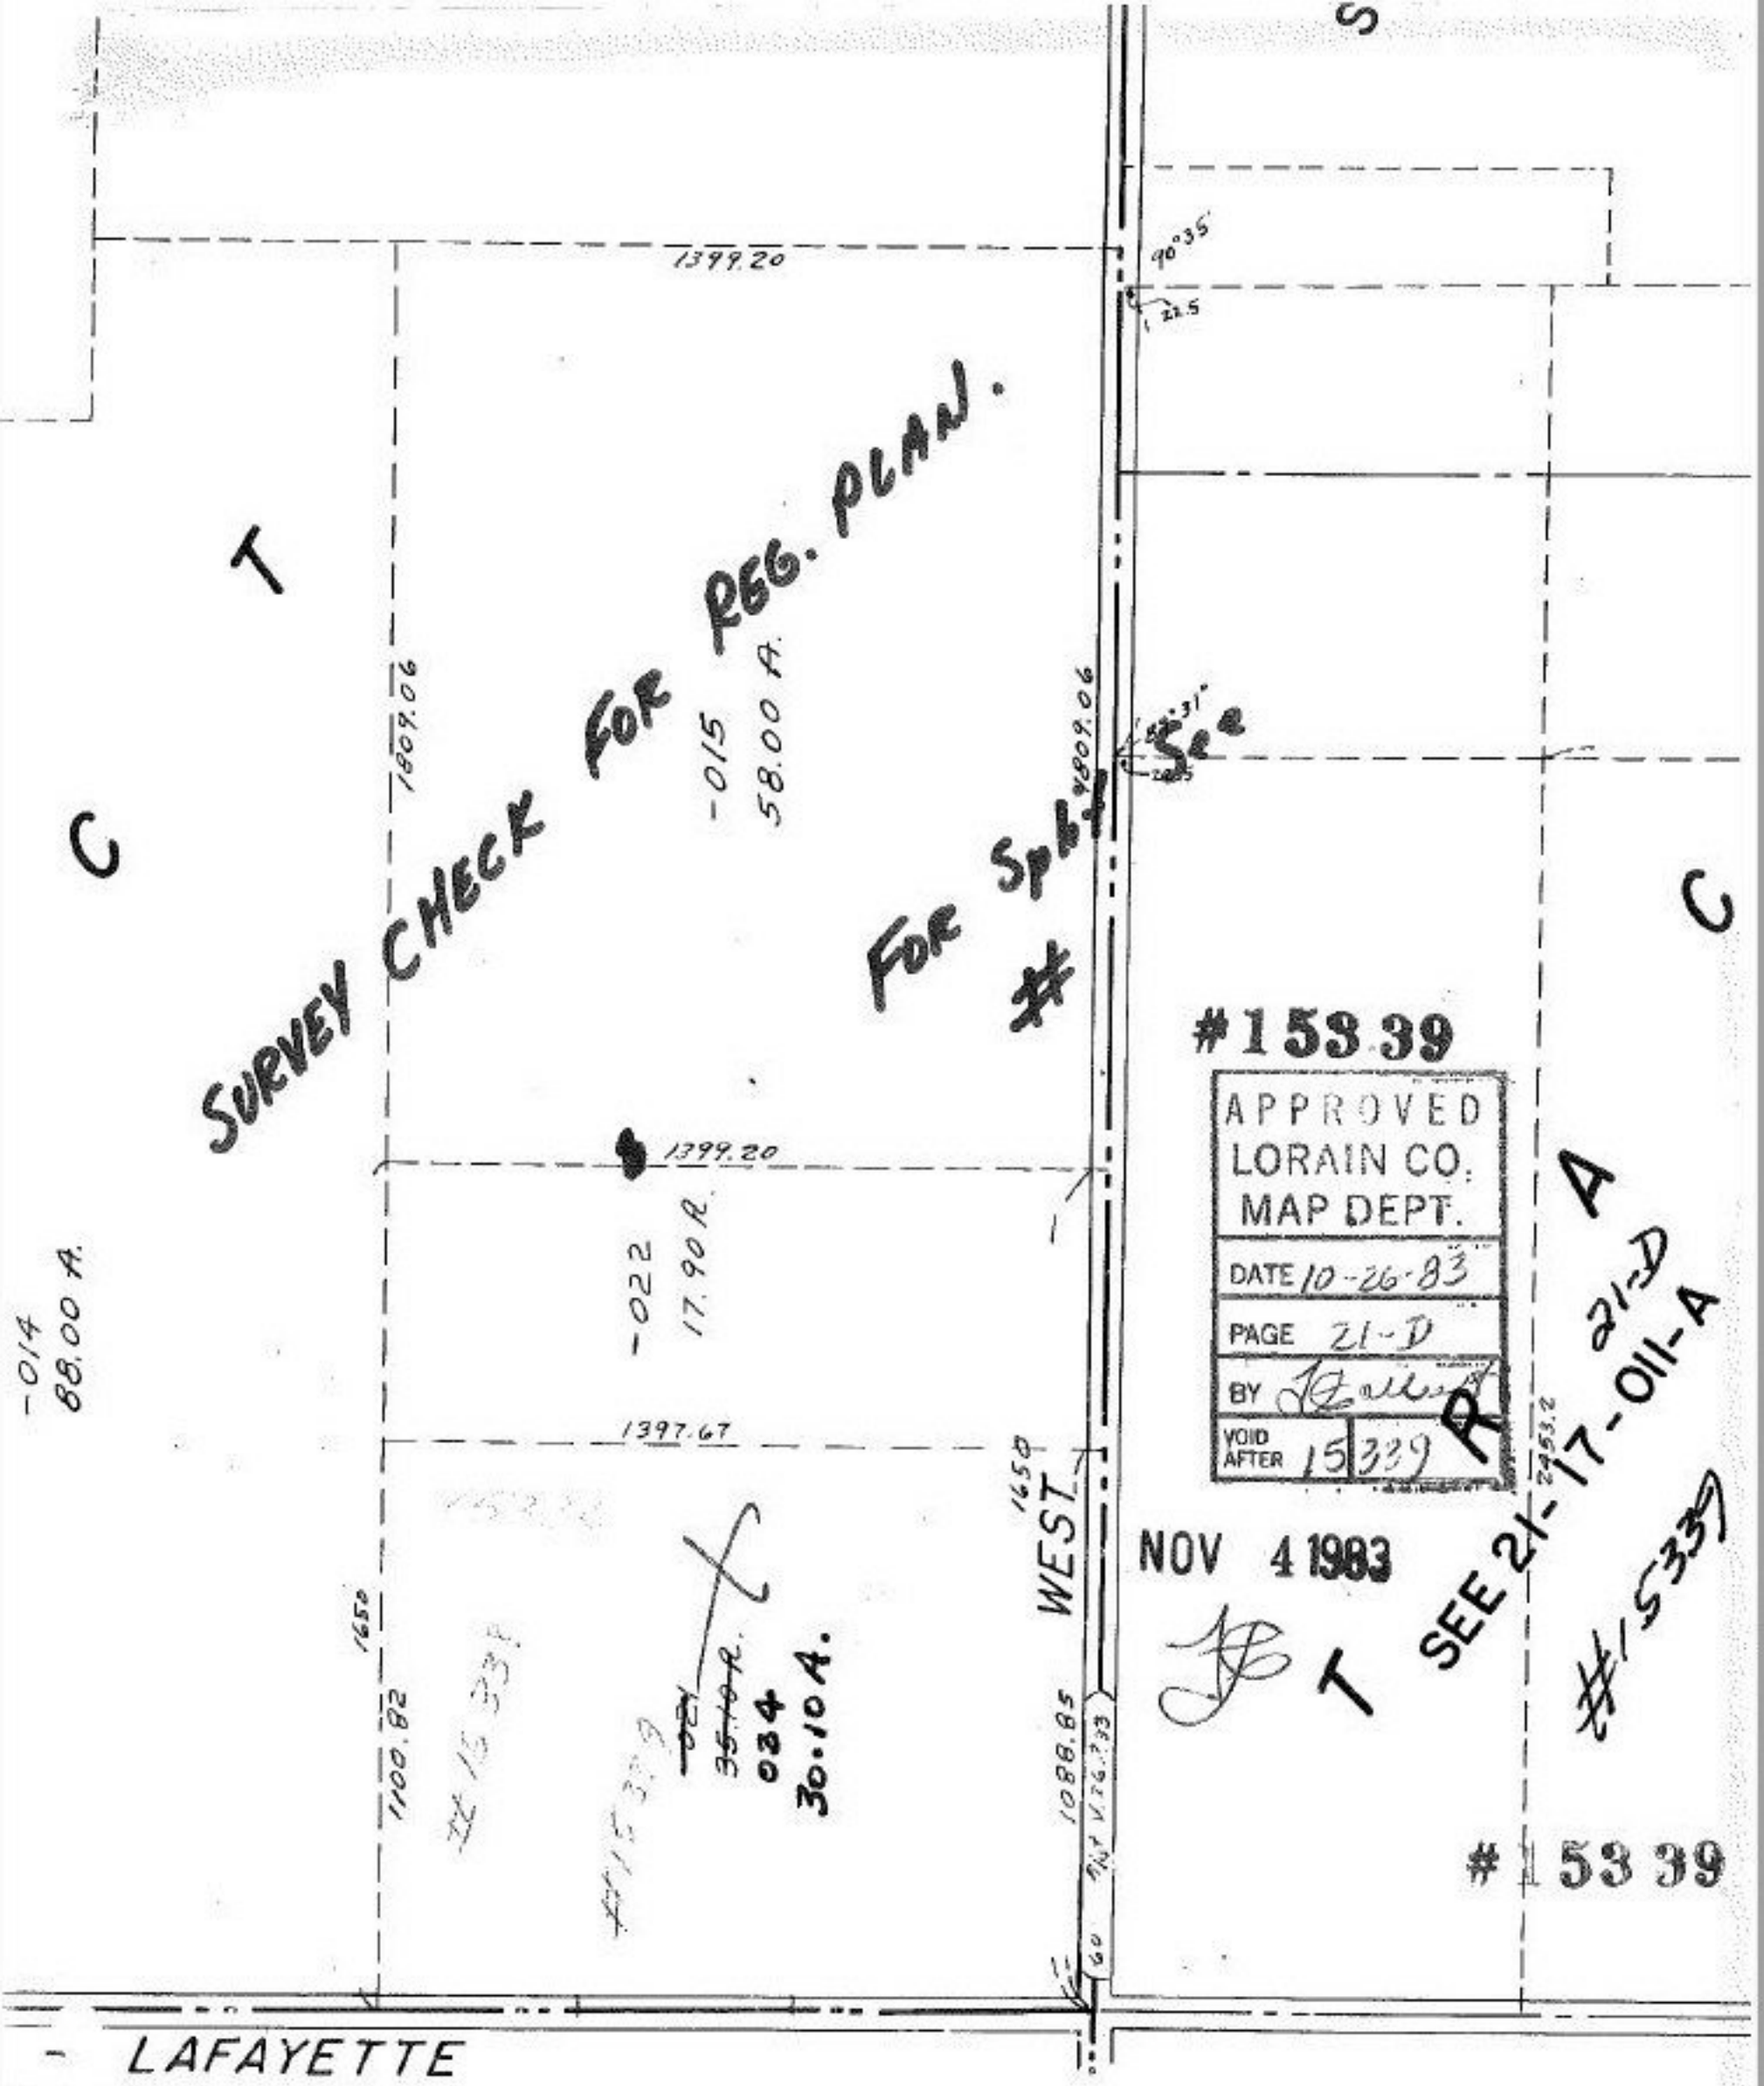

TON TWP.

ELY. PT TRACT 12
TRACT 17 LOTS 1