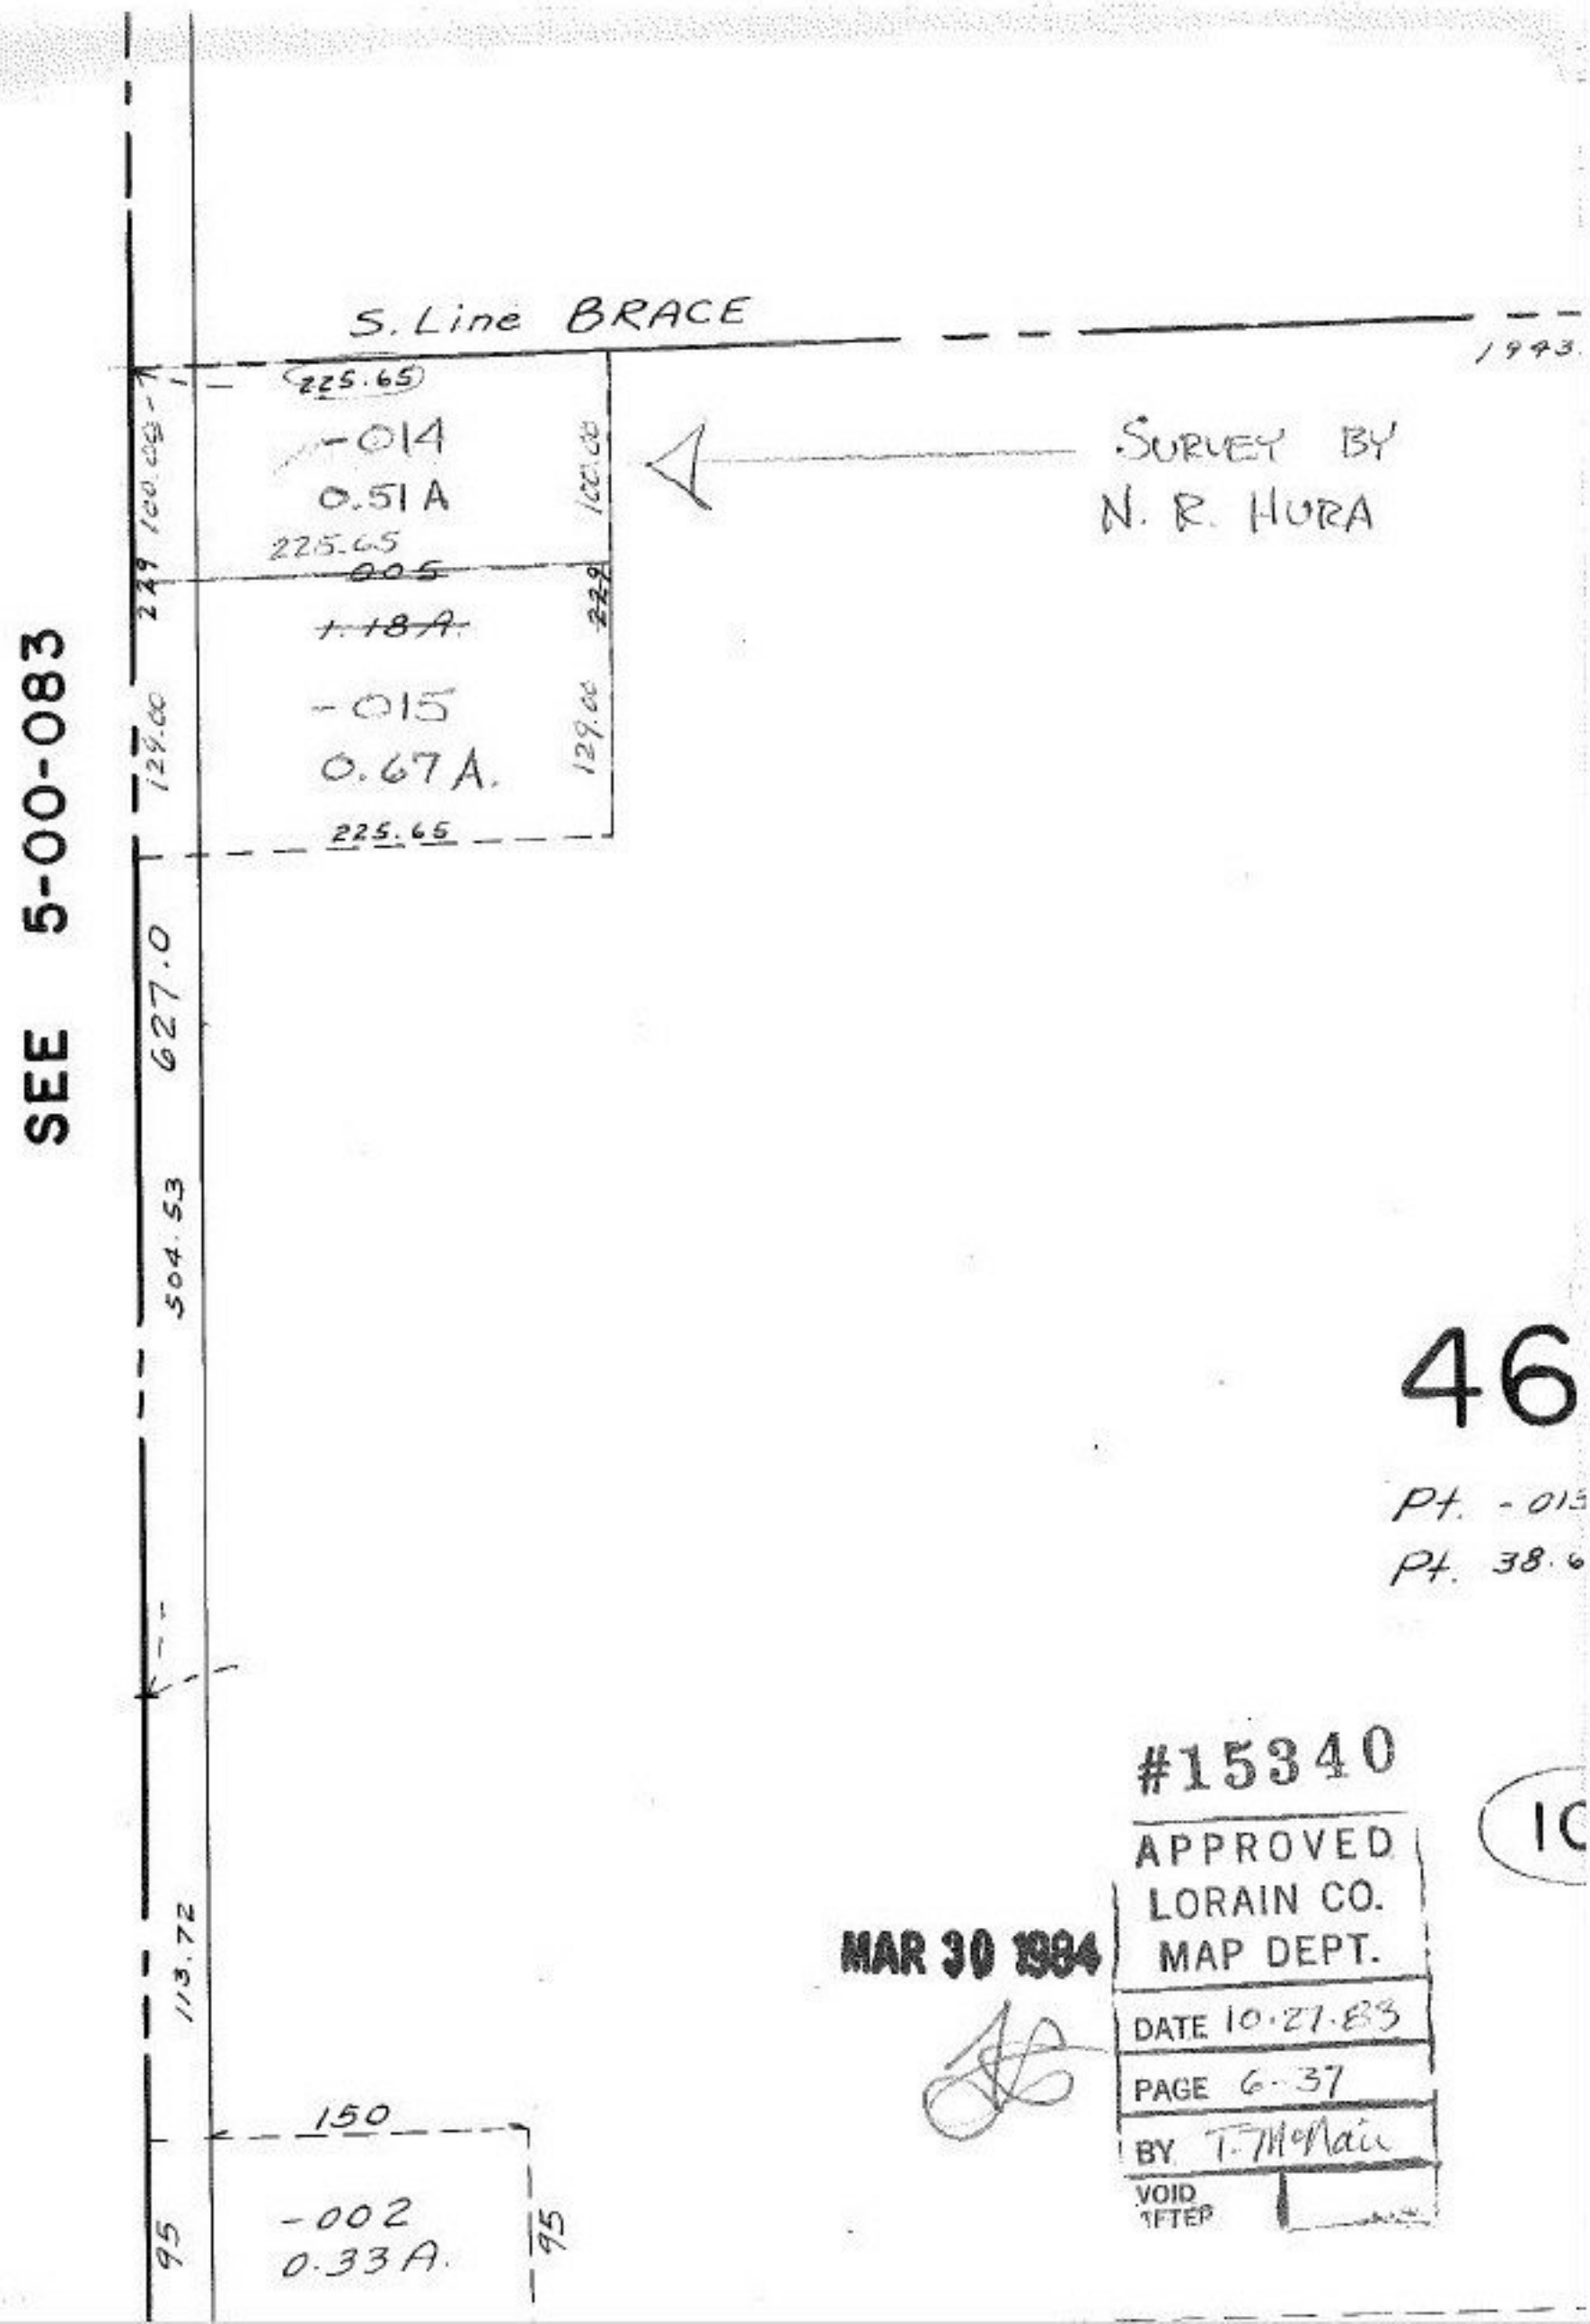
S. Line BRACE
1943.
225.65
-014
0.51 A
225.65
122.00
SURVEY BY
N. R. HURA
249 100.00
~~005~~
~~1.18 A.~~
~~229~~
-015
0.67 A.
129.00
129.00
225.65
627.0
304.53
113.72
150
-002
0.33 A.
95
95
SEE 5-00-083
46
Pt. -015
Pt. 38.6
#15340
APPROVED
LORAIN CO.
MAP DEPT.
DATE 10-27-83
PAGE 6-37
BY T. McNair
VOID AFTER
MAR 30 1984
10