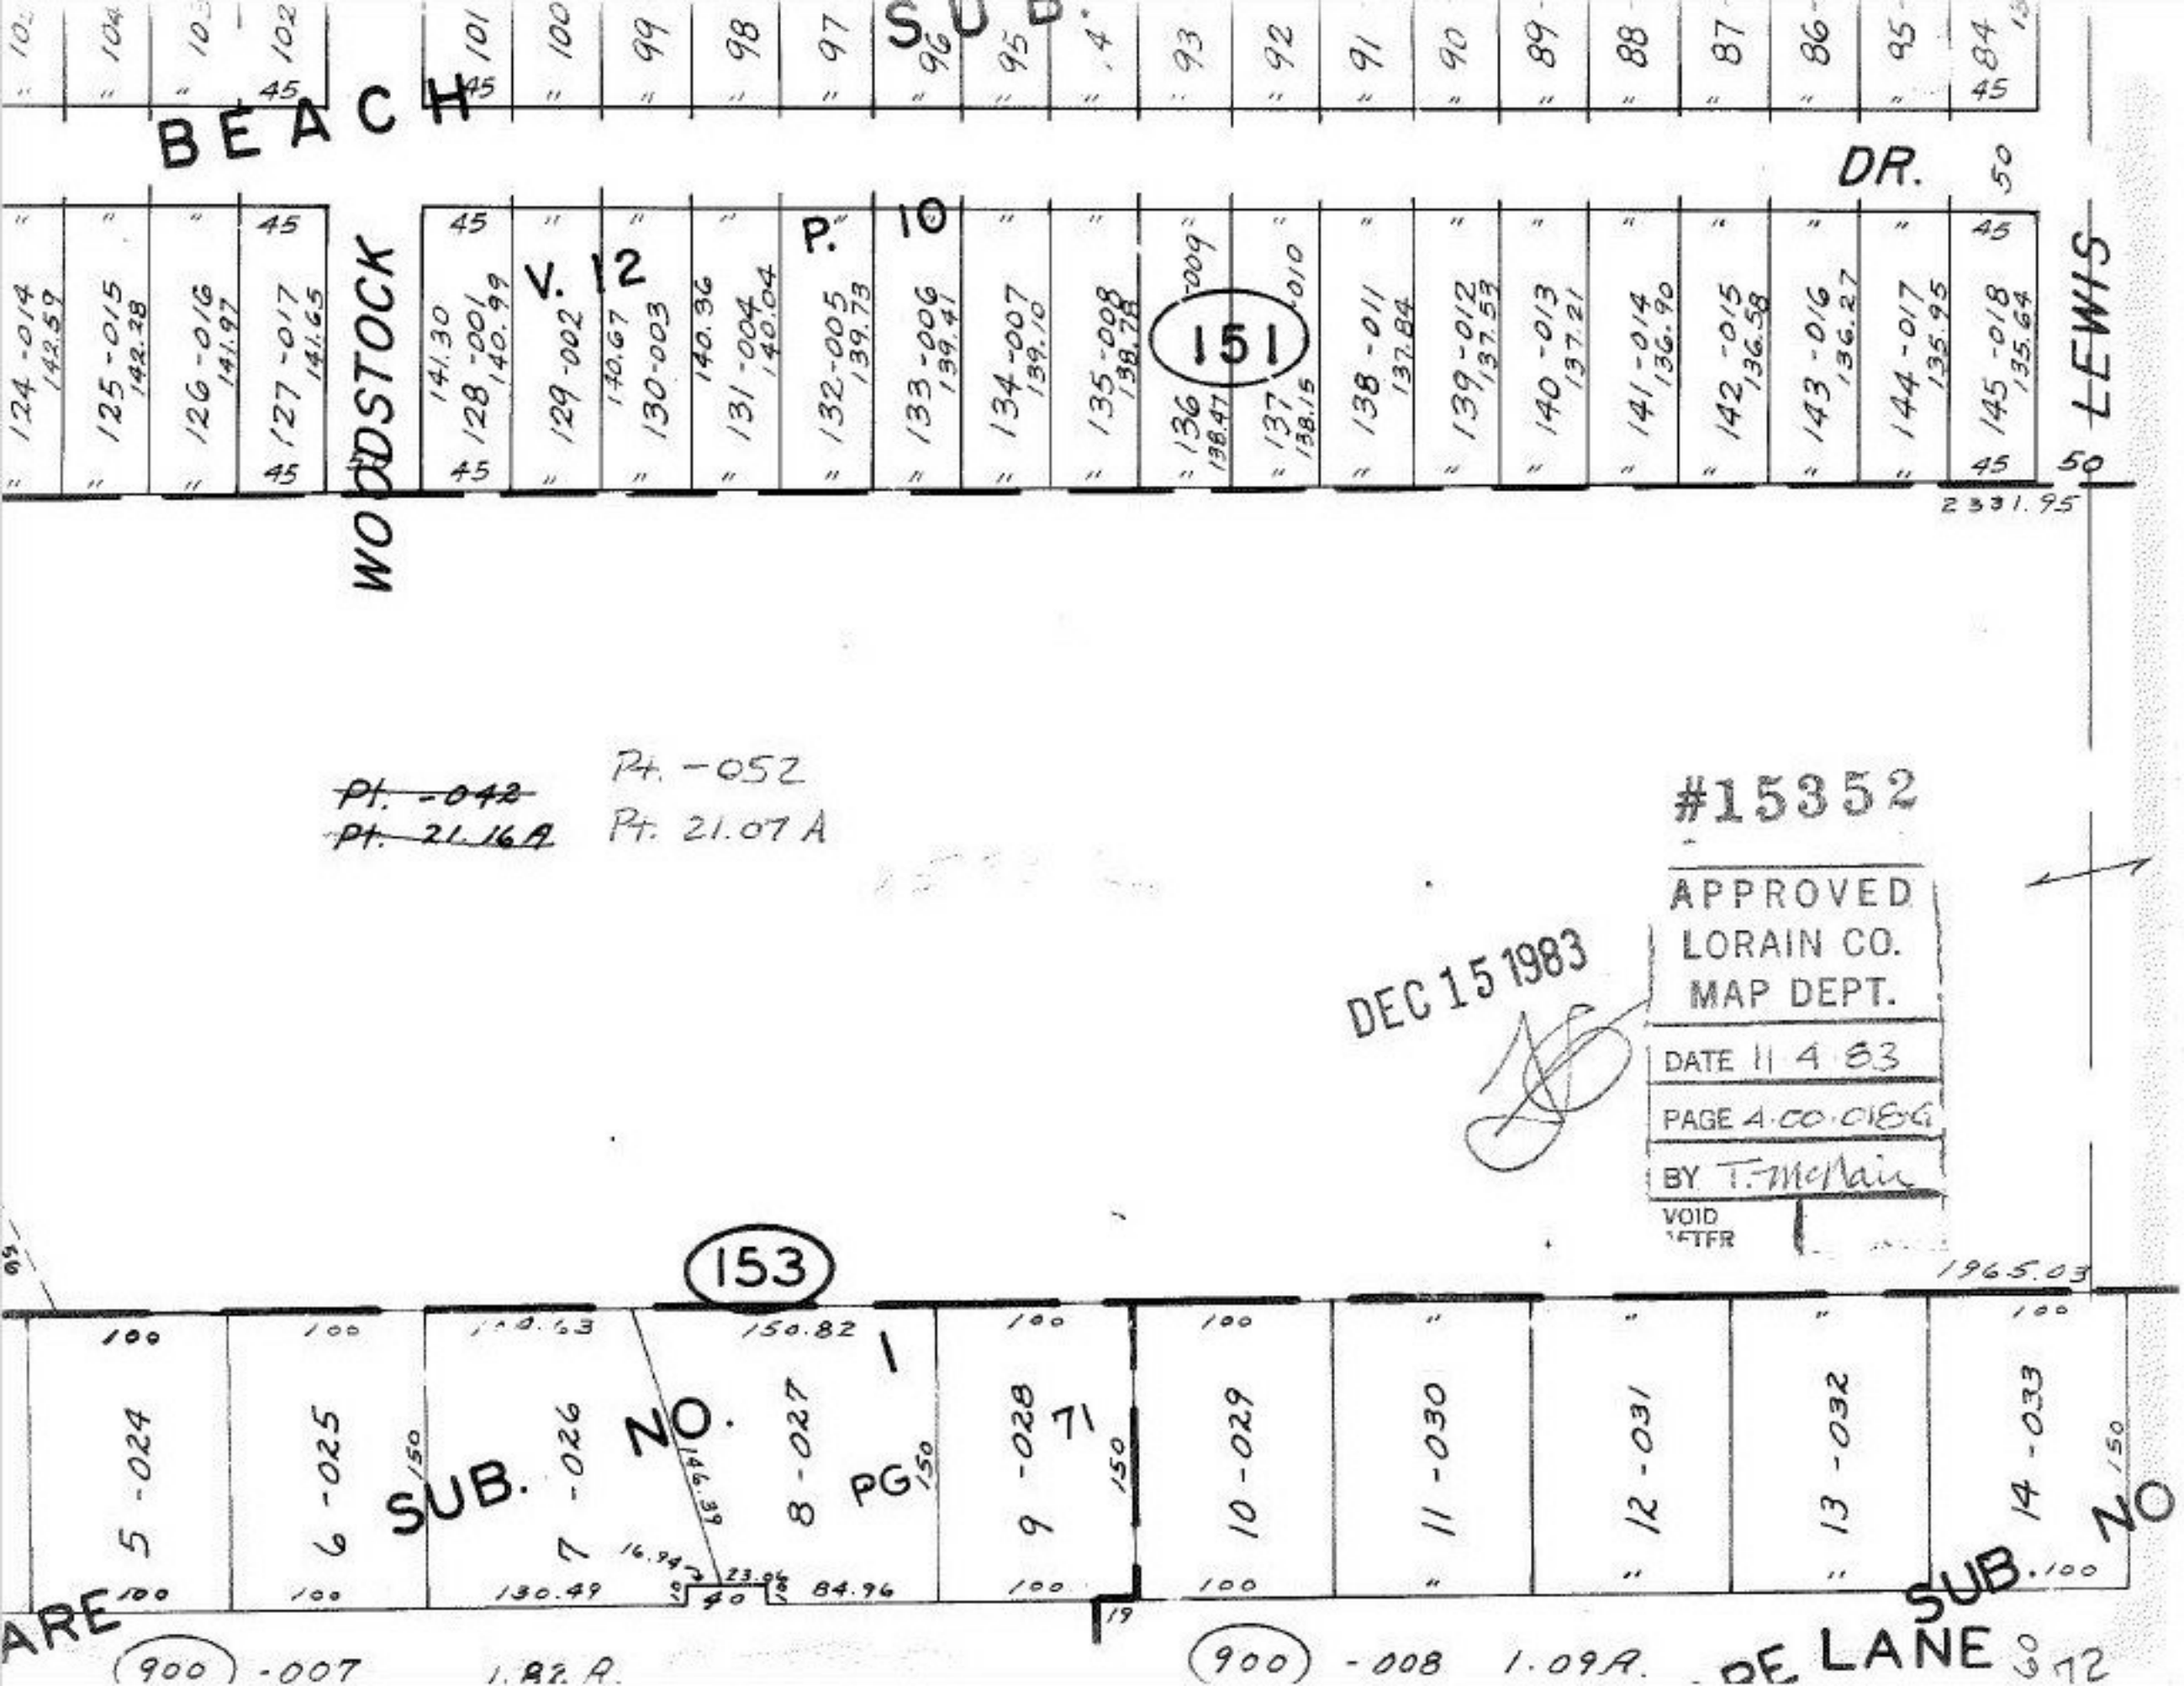

BEACH
SUB.
DR.
WOODSTOCK
LEWIS
V. 12
P. 10
151
124-014 142.59
125-015 142.28
126-016 141.97
127-017 141.65
128-001 140.99
129-002
130-003
131-004 140.04
132-005 139.73
133-006 139.41
134-007 139.10
135-008 138.78
136 138.47
137 138.15
138-011 137.84
139-012 137.53
140-013 137.21
141-014 136.90
142-015 136.58
143-016 136.27
144-017 135.95
145-018 135.64
2331.95
Pt. -042
Pt. 21.16A
Pt. -052
Pt. 21.07 A
#15352
APPROVED
LORAIN CO.
MAP DEPT.
DATE 11 4 83
PAGE 4.00.018G
BY T. McNair
VOID
DEC 15 1983
153
1965.03
5-024
6-025
7-026
8-027
9-028
10-029
11-030
12-031
13-032
14-033
SUB. NO. 1
PG 71
SUB. NO
ARE
(900) -007 1.82 A.
(900) -008 1.09A.
RE LANE