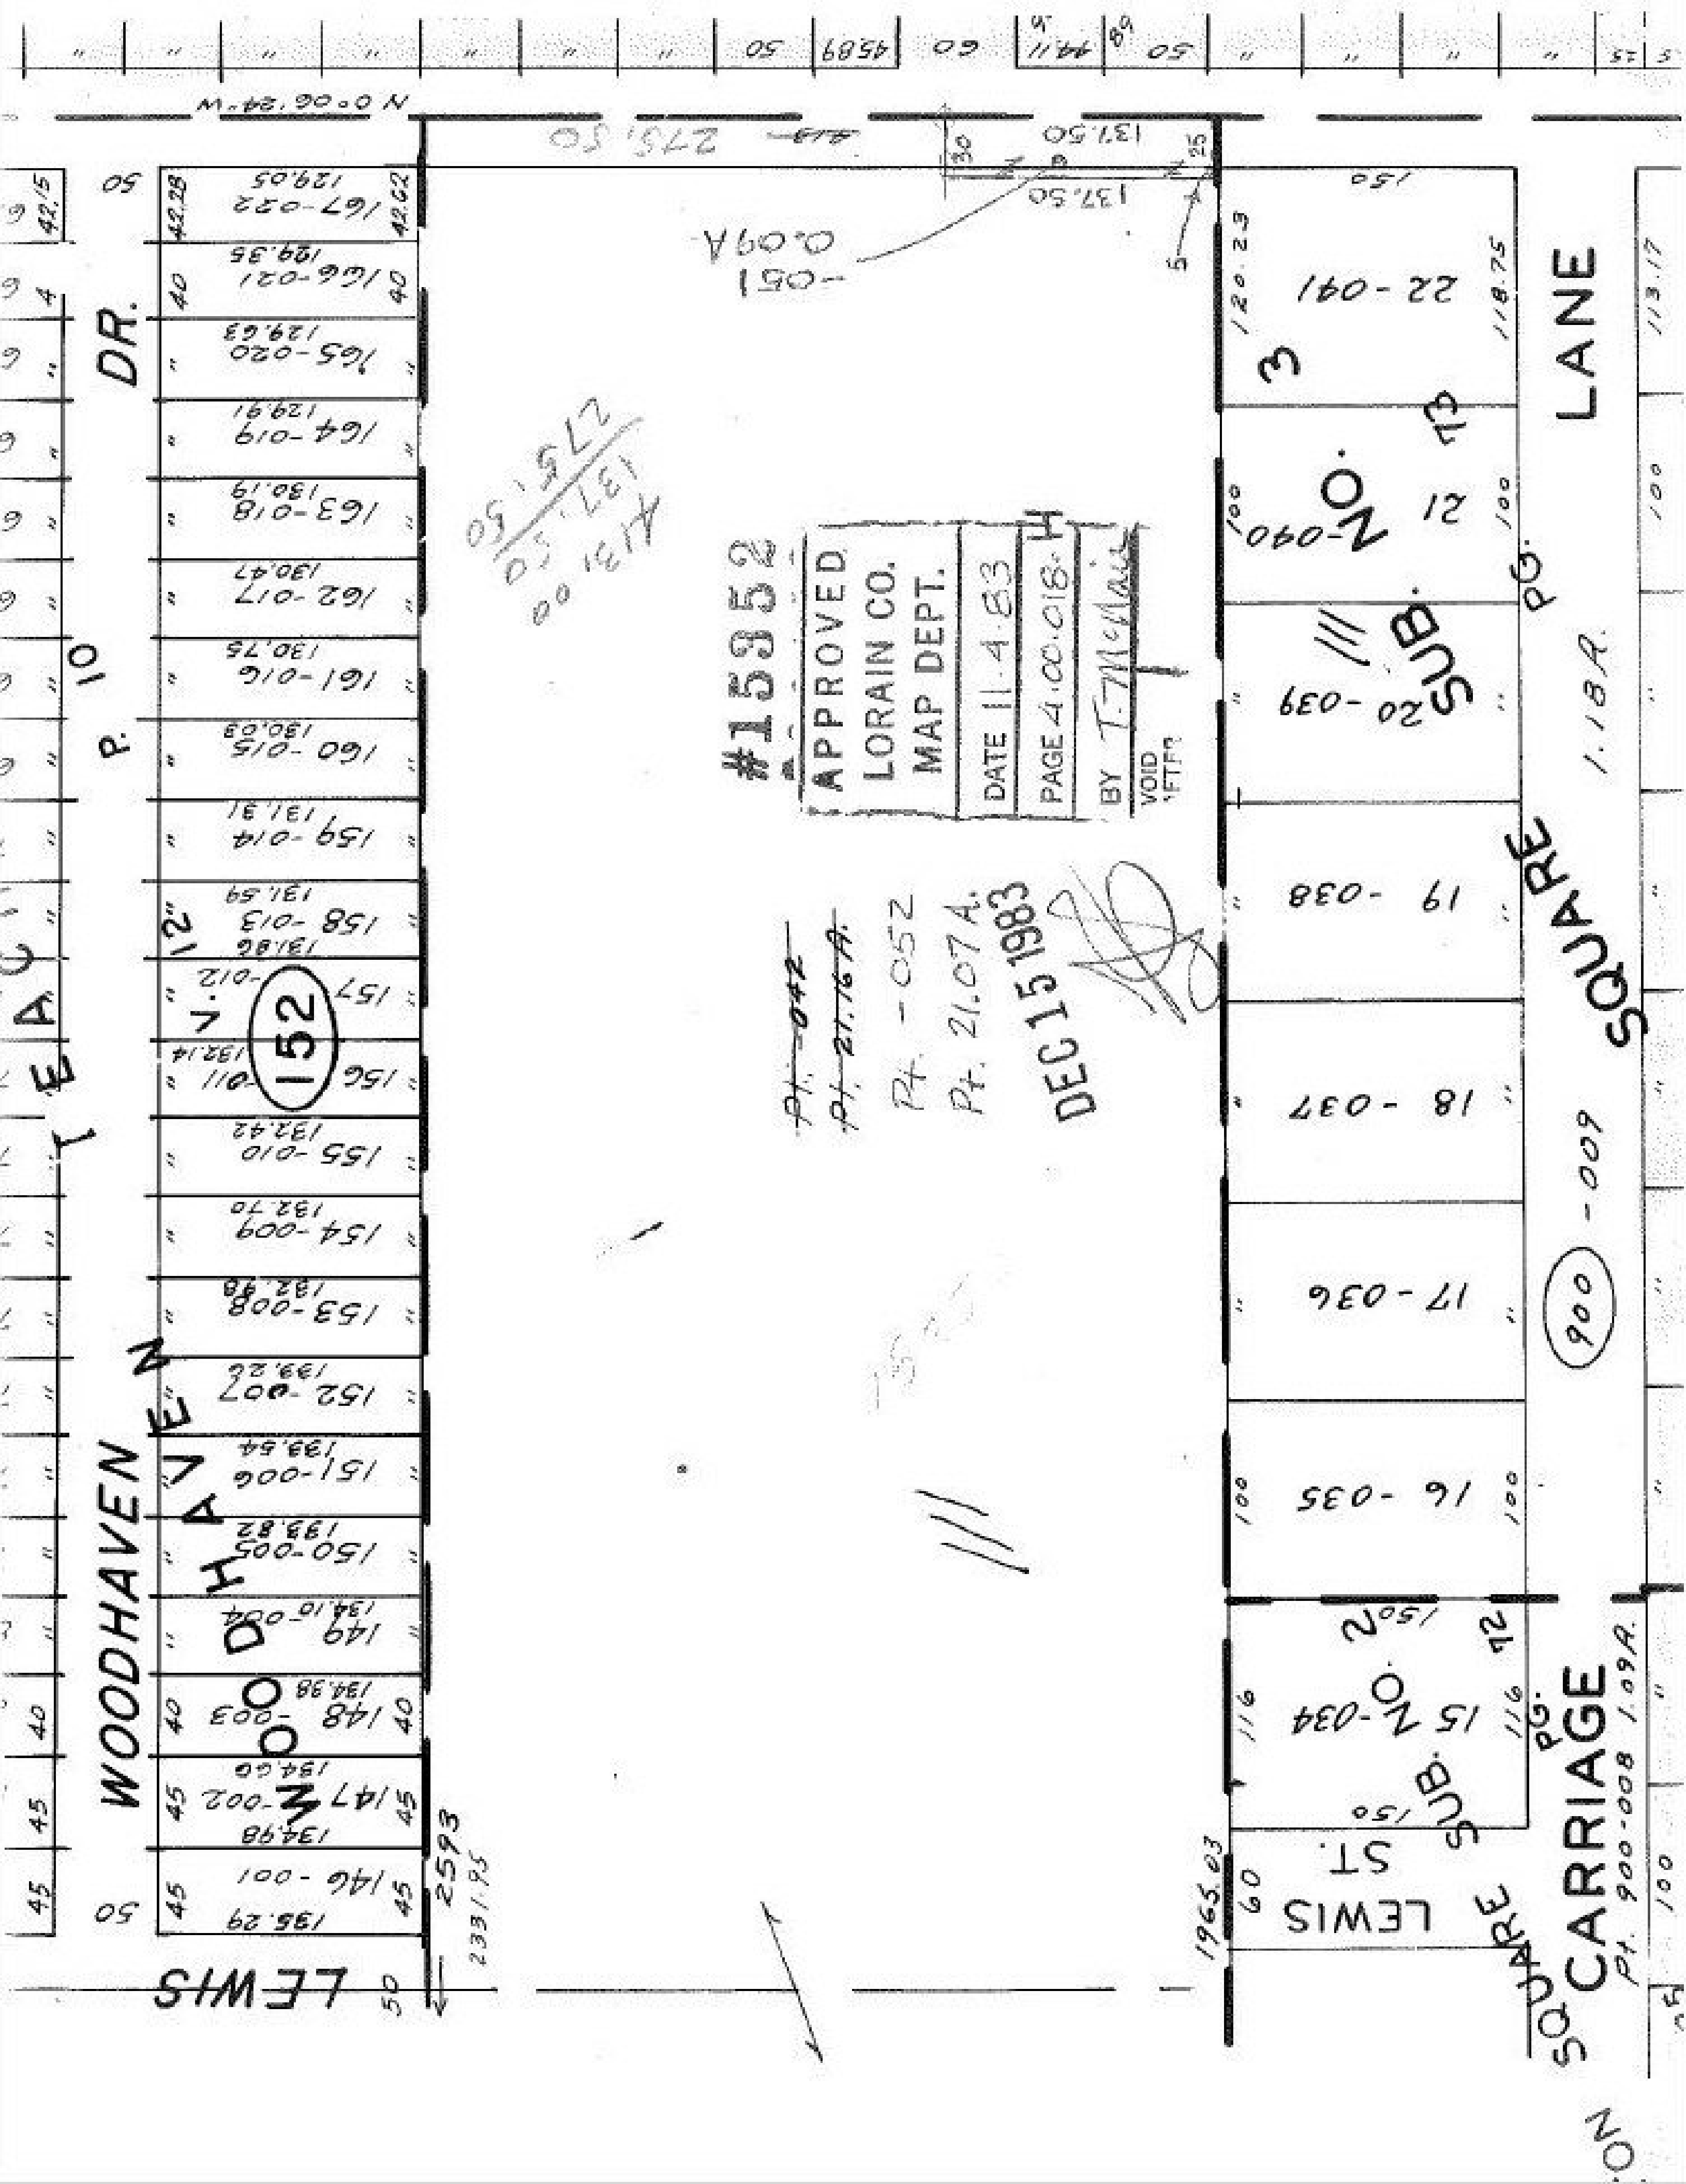

WOODHAVEN DR.
WOODHAVEN AVE.
LEWIS
LEWIS ST.
SQUARE LANE
CARRIAGE SQUARE
SQUARE SUB. NO. 3 PG. 13
SQUARE SUB. NO. 2 PG. 12
P. 10
V. 12
152
900-009
1.18A.
Pt. 900-008 1.09A.
#15352
APPROVED LORAIN CO. MAP DEPT.
DATE 11-4-83
PAGE 4.00.018-H
BY T. McMains
VOID AFTER
DEC 15 1983
Pt. -052
Pt. 21.07 A.
Pt. -042
Pt. 21.16 A.
051-
0.09A
275.50
137.50
N 0°06'24" W
167-022
166-021
165-020
164-019
163-018
162-017
161-016
160-015
159-014
158-013
157-012
156-011
155-010
154-009
153-008
152-007
151-006
150-005
149-004
148-003
147-002
146-001
22-041
21-040
20-039
19-038
18-037
17-036
16-035
15-034
2593
2331.95
1965.03