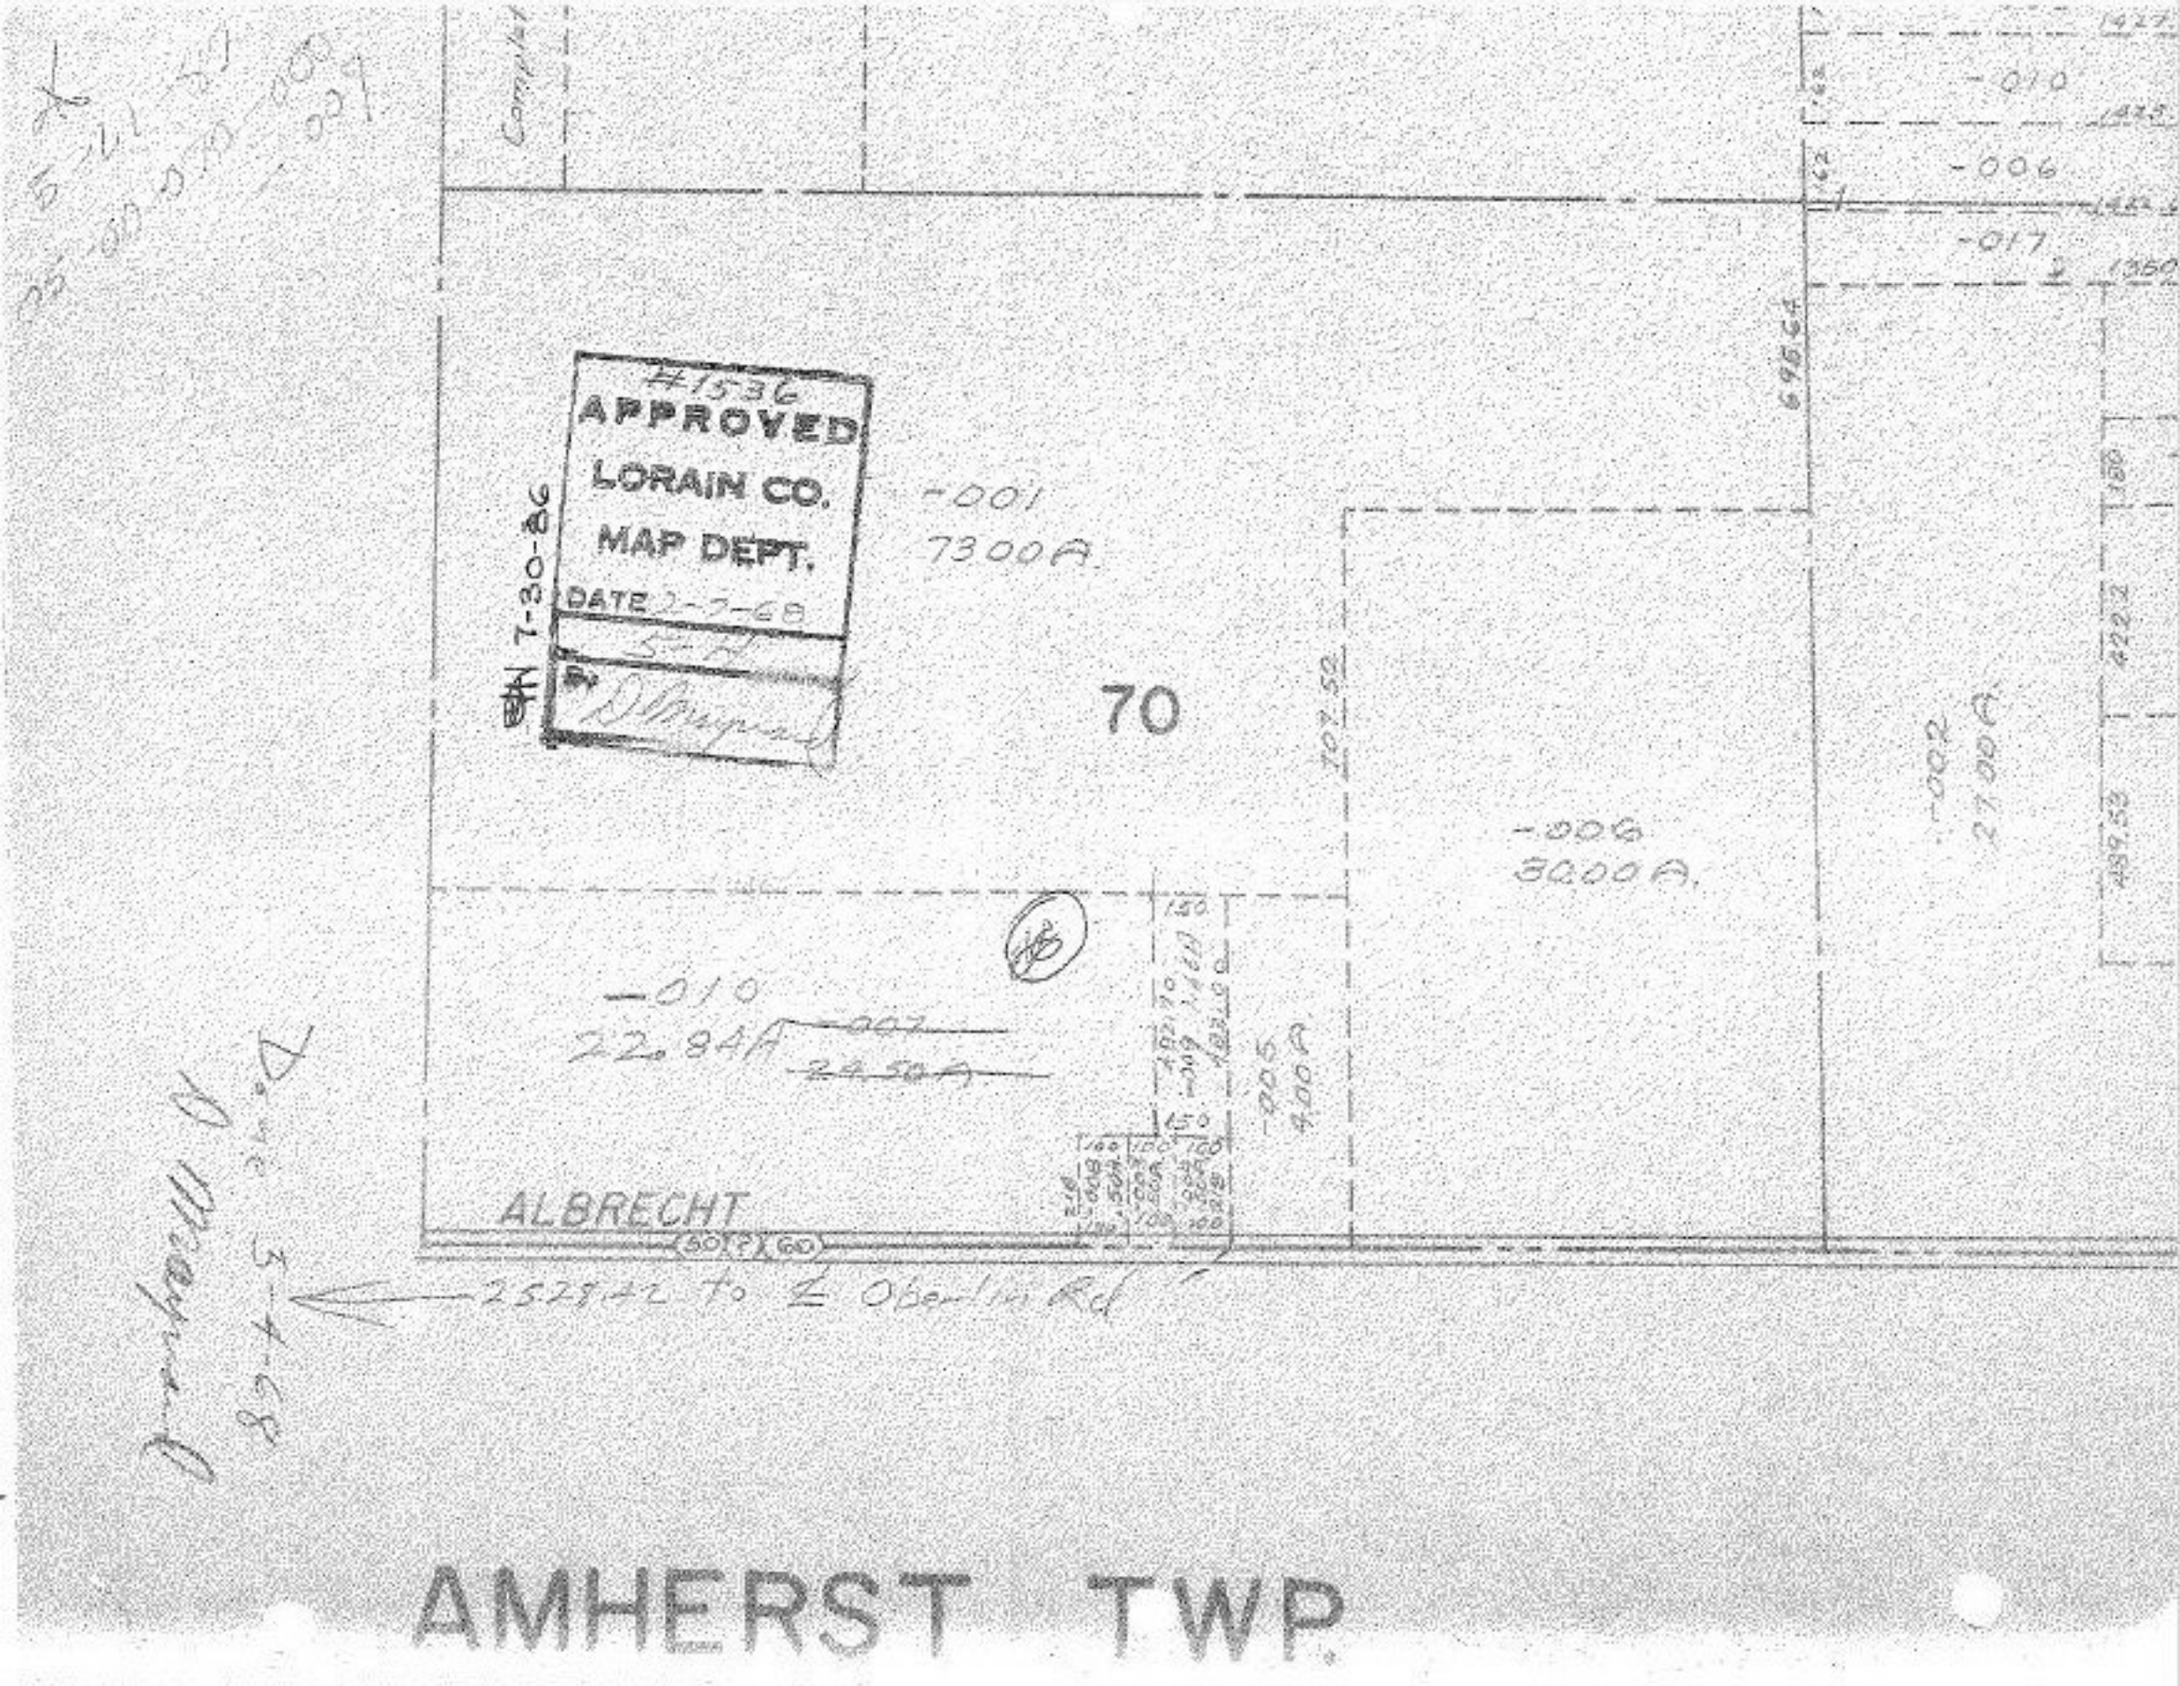

#1536
APPROVED
LORAIN CO.
MAP DEPT.
DATE 2-7-68
7-30-86
-001
7300A
70
-006
30.00A
-010
22.84A
-007
24.50A
-005
4.00A
-002
27.00A
-010
-006
-017
ALBRECHT
2528.42 to ℄ Oberlin Rd
AMHERST TWP.