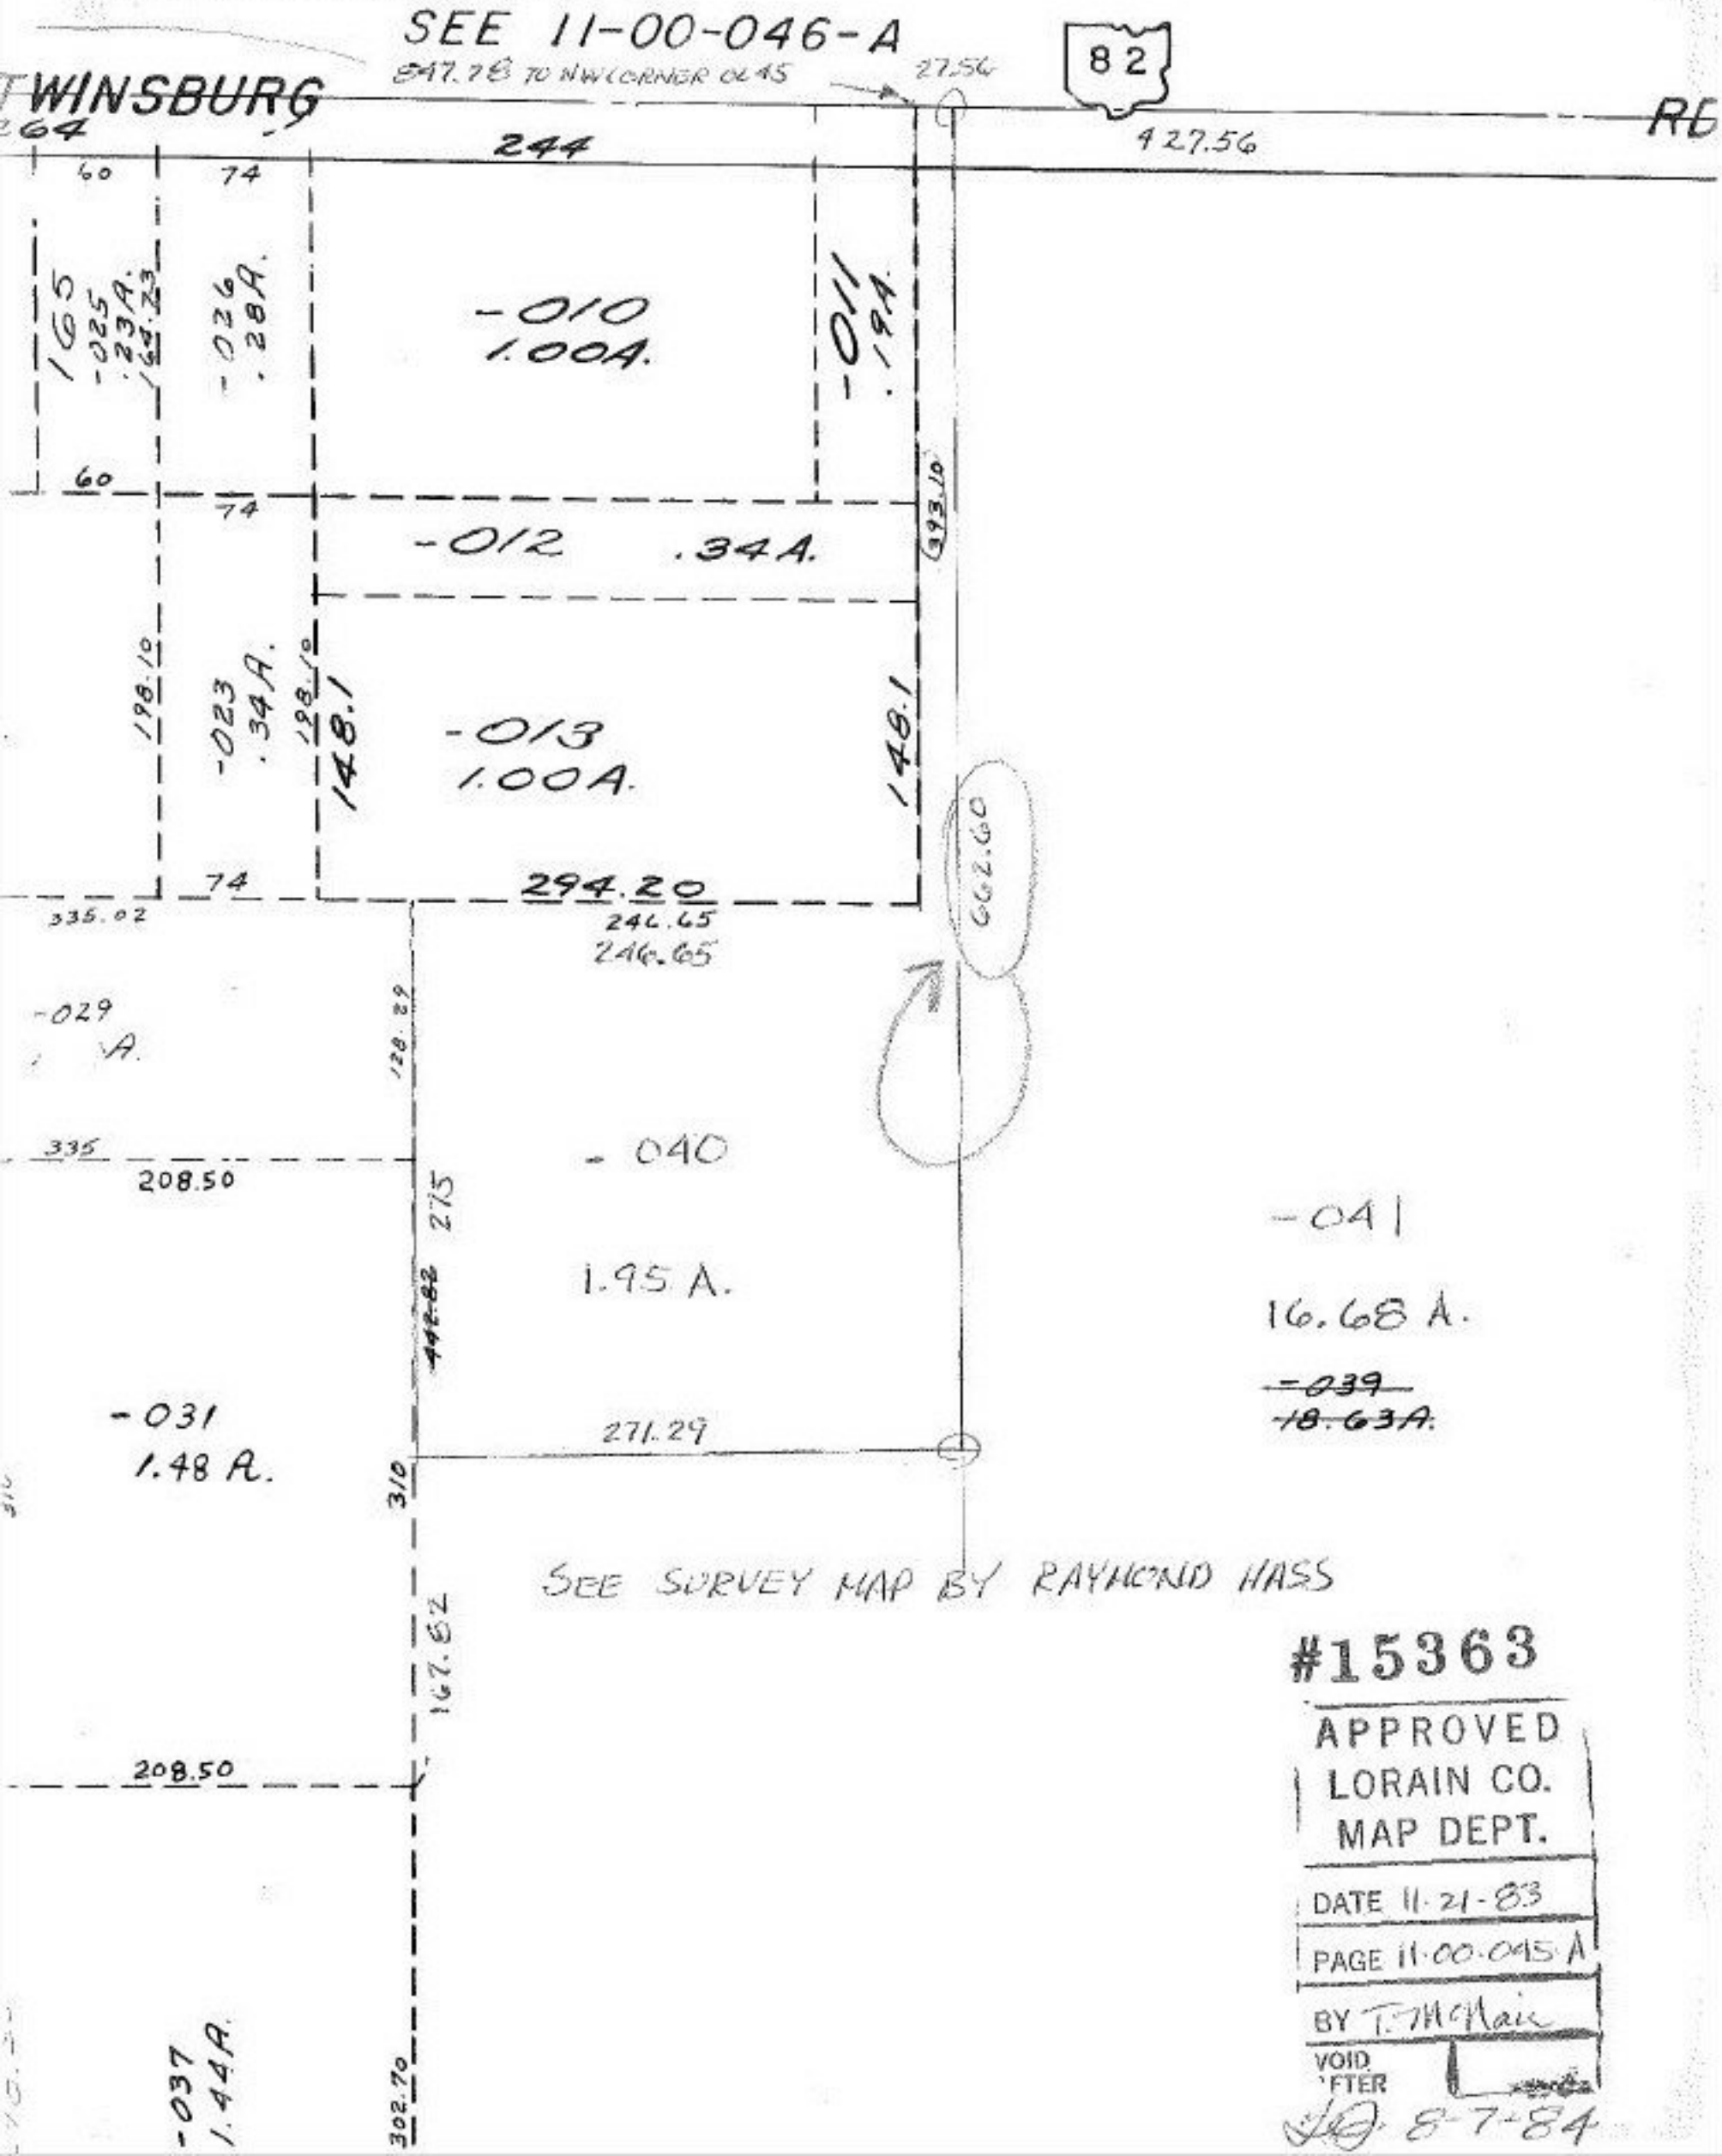

#15363

APPROVED
LORAIN CO.
MAP DEPT.

DATE 11-21-83

PAGE 11-00-045-A

BY T. McNair

VOID
AFTER

8-7-84