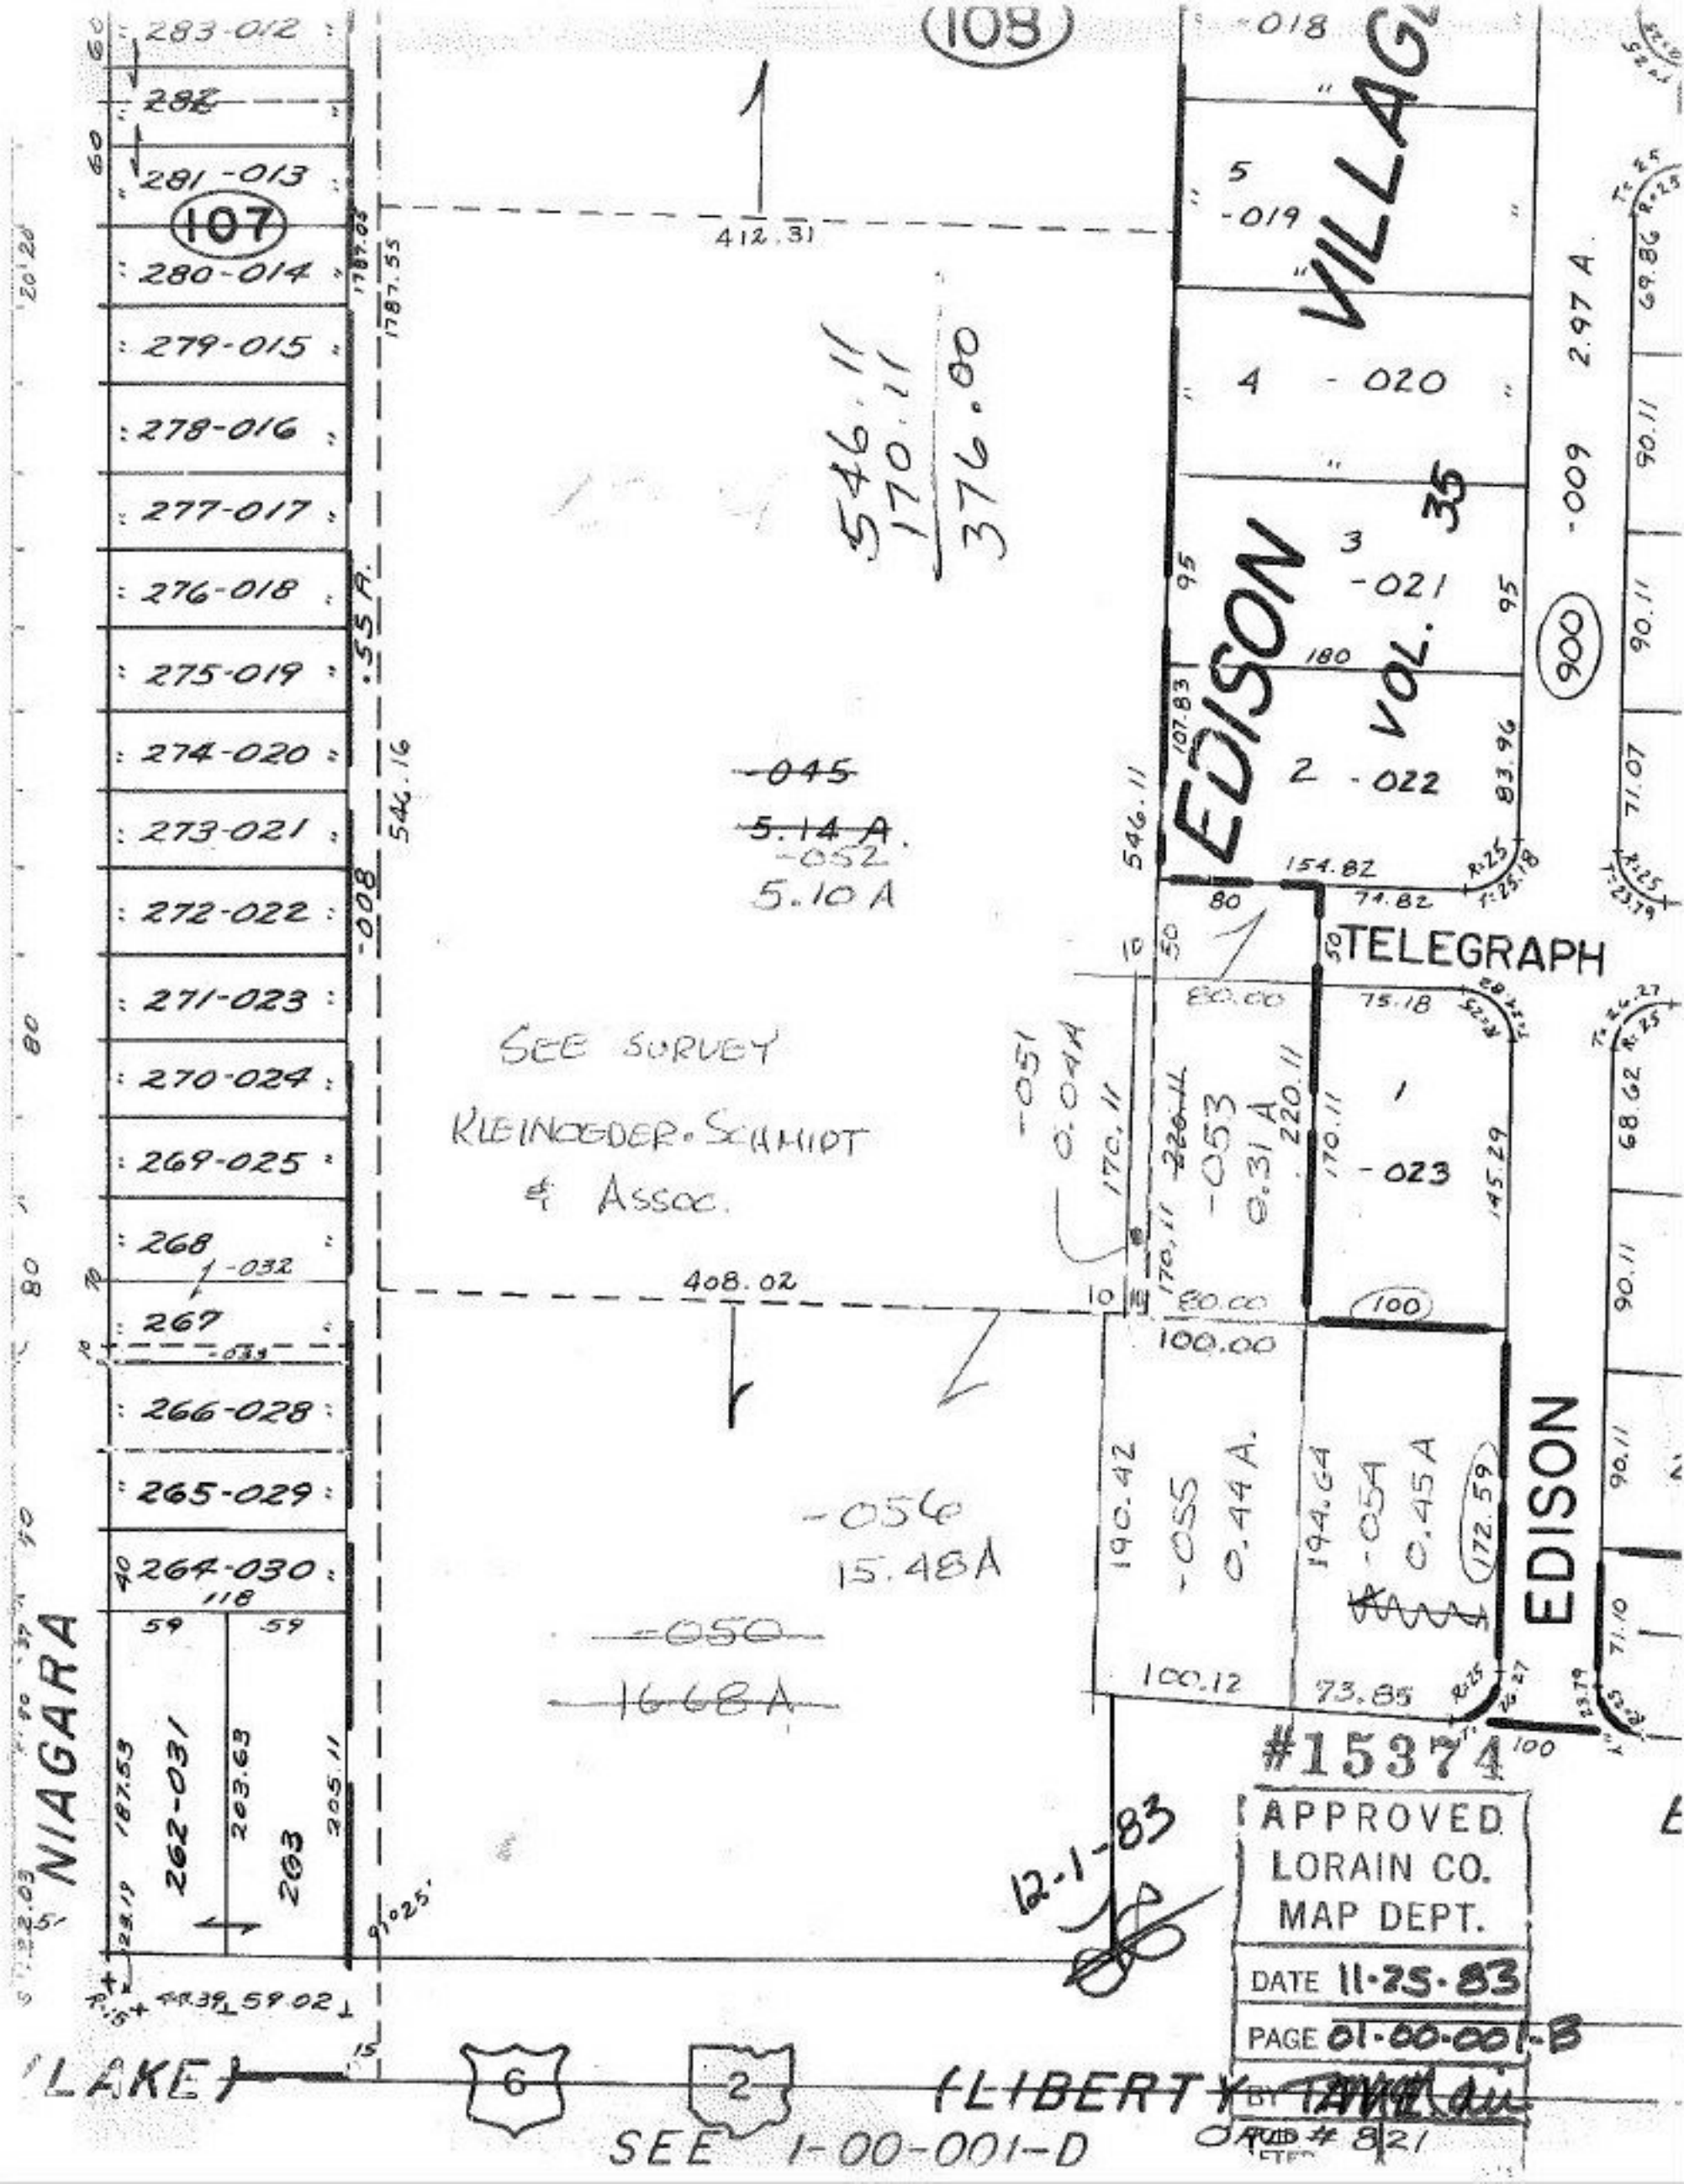

108
107
283-012
282
281-013
280-014
279-015
278-016
277-017
276-018
275-019
274-020
273-021
272-022
271-023
270-024
269-025
268
267
266-028
265-029
264-030
262-031
263
NIAGARA
412.31
546.11
170.11
376.00
-045
5.14 A
-052
5.10 A
SEE SURVEY
KLEINOEDER-SCHMIDT
& ASSOC.
408.02
-056
15.48A
-050
16.68A
EDISON VILLAGE
VOL. 35
-018
5
-019
4
-020
3
-021
2
-022
-009
2.97 A
900
TELEGRAPH
-051
0.04A
-053
0.31 A
-023
100
-055
0.44 A.
-054
0.45 A
EDISON
#15374
APPROVED
LORAIN CO.
MAP DEPT.
DATE 11-25-83
PAGE 01-00-001-B
12-1-83
(LAKE)
6
2
(LIBERTY)
SEE 1-00-001-D