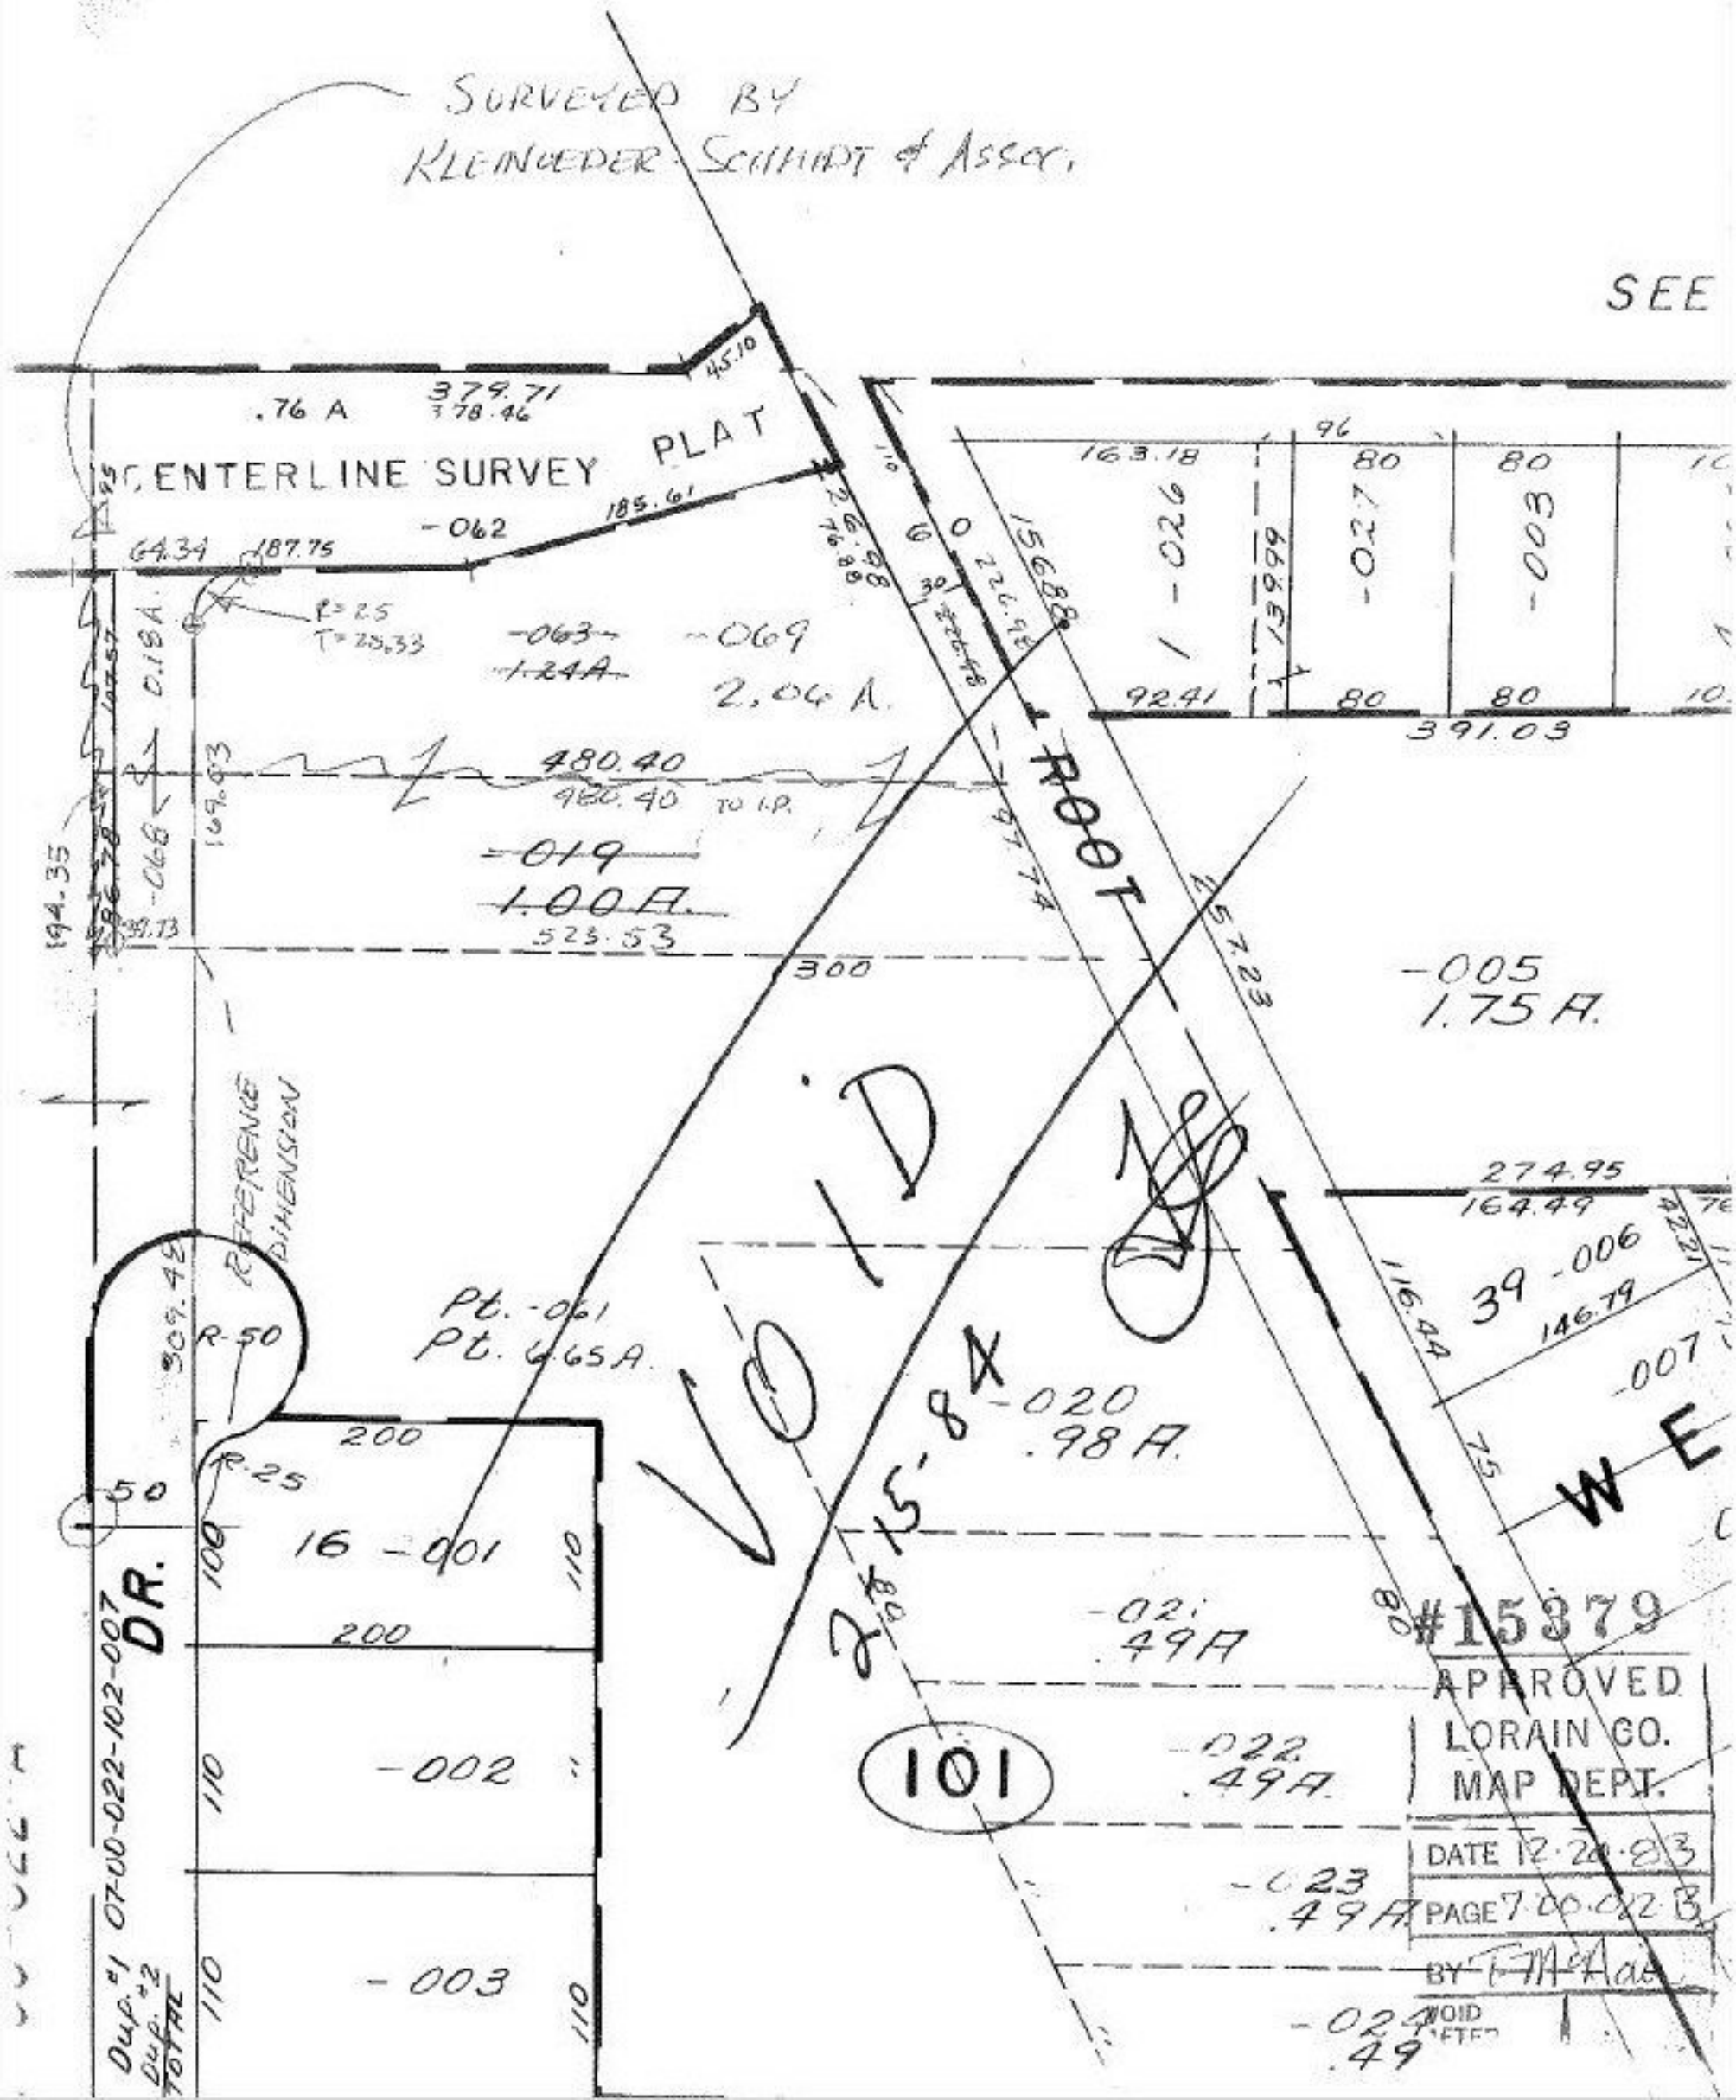
SURVEYED BY
KLEINOEDER SCHMIDT & ASSOC.
SEE
CENTERLINE SURVEY PLAT
.76 A
379.71
378.46
45.10
185.61
-062
64.34
187.75
R=25
T=25.33
-063
1.24A
-069
2.06 A.
480.40
480.40 TO I.P.
-019
1.00 A.
523.53
300
194.35
169.03
-068
0.18A
REFERENCE DIMENSION
309.48
R-50
R-25
Pt. -061
Pt. 6.65 A.
200
16 -001
100
110
-002
-003
DR.
Dup. #1 07-00-022-102-007
Dup. #2
TOTAL
VOID
2-15-84
-020
.98 A.
-021
.49 A
-022
.49 A.
-023
.49 A
-024
.49
101
ROOT
156.88
226.98
97.74
257.23
163.18
96
80
80
1 -026
139.99
-027
-003
92.41
80
80
391.03
-005
1.75 A.
274.95
164.49
116.44
39 -006
146.79
-007
75
WE
#15379
APPROVED
LORAIN CO.
MAP DEPT.
DATE 12-20-83
PAGE 7-00-022-B
BY
VOID
AFTER