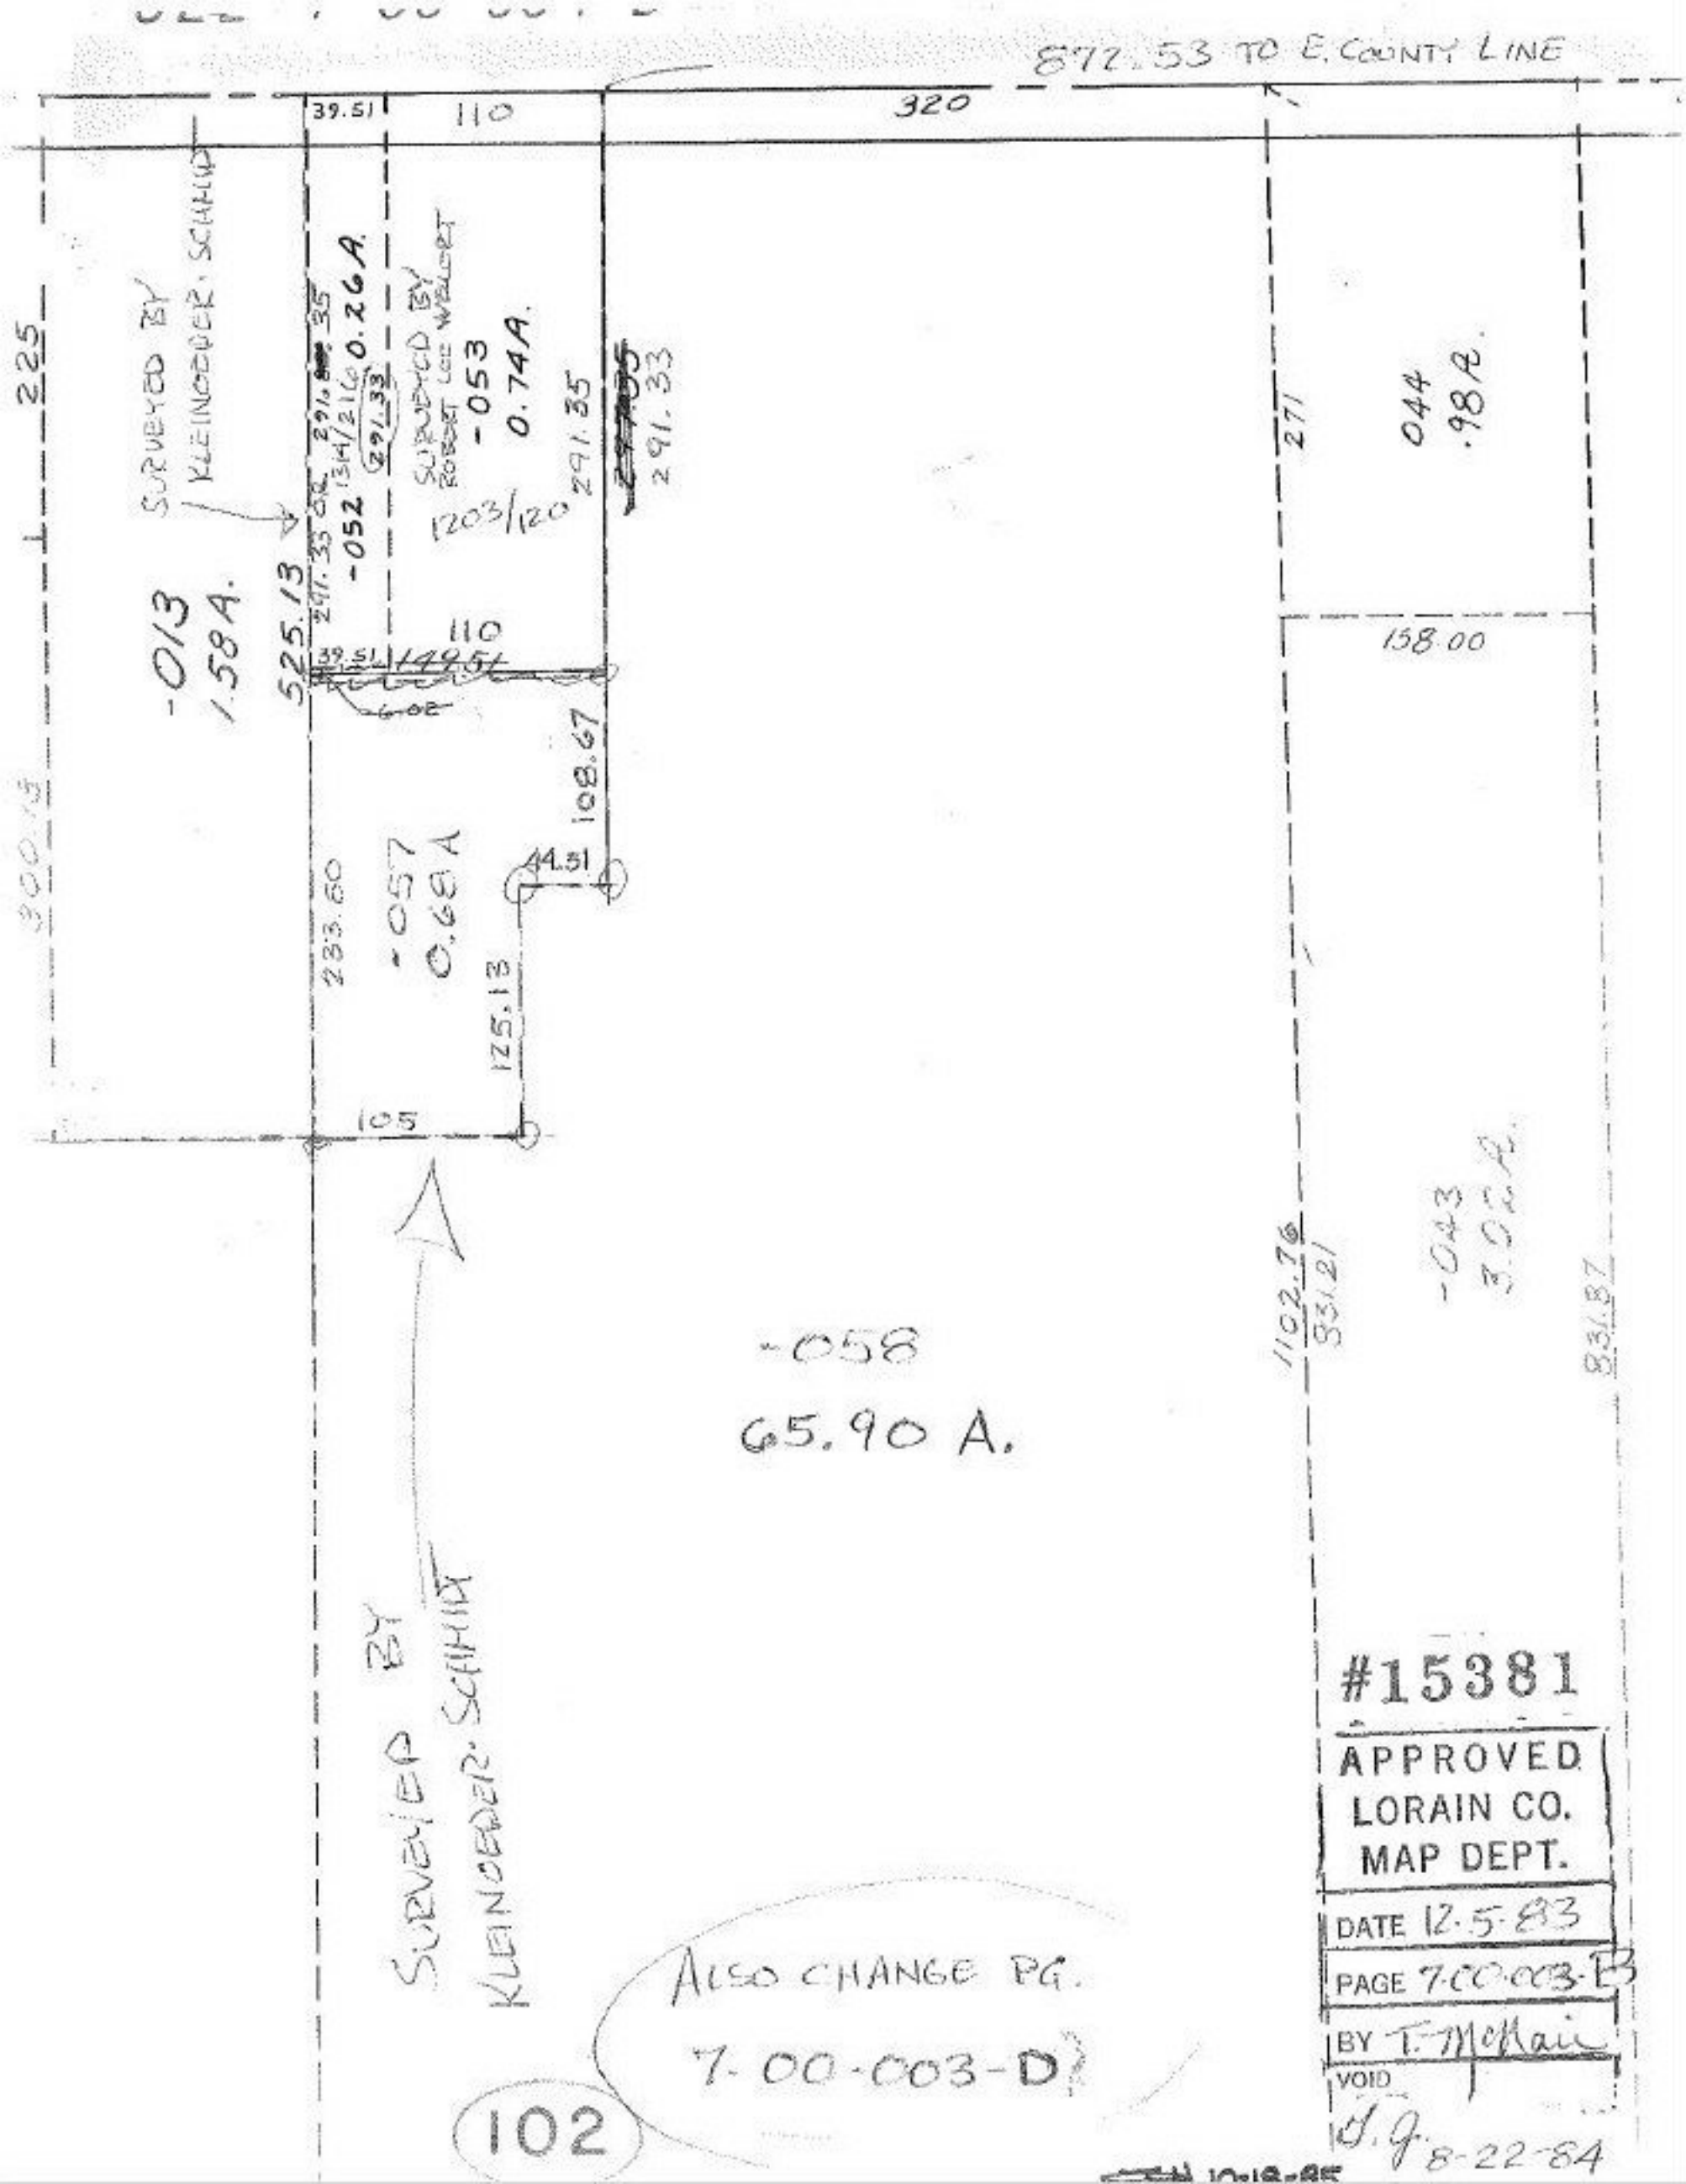

#15381

APPROVED
LORAIN CO.
MAP DEPT.

DATE 12-5-83

PAGE 7-00-003-B

BY T. McNair

VOID

G.J. 8-22-84

ALSO CHANGE PG.
7-00-003-D

102