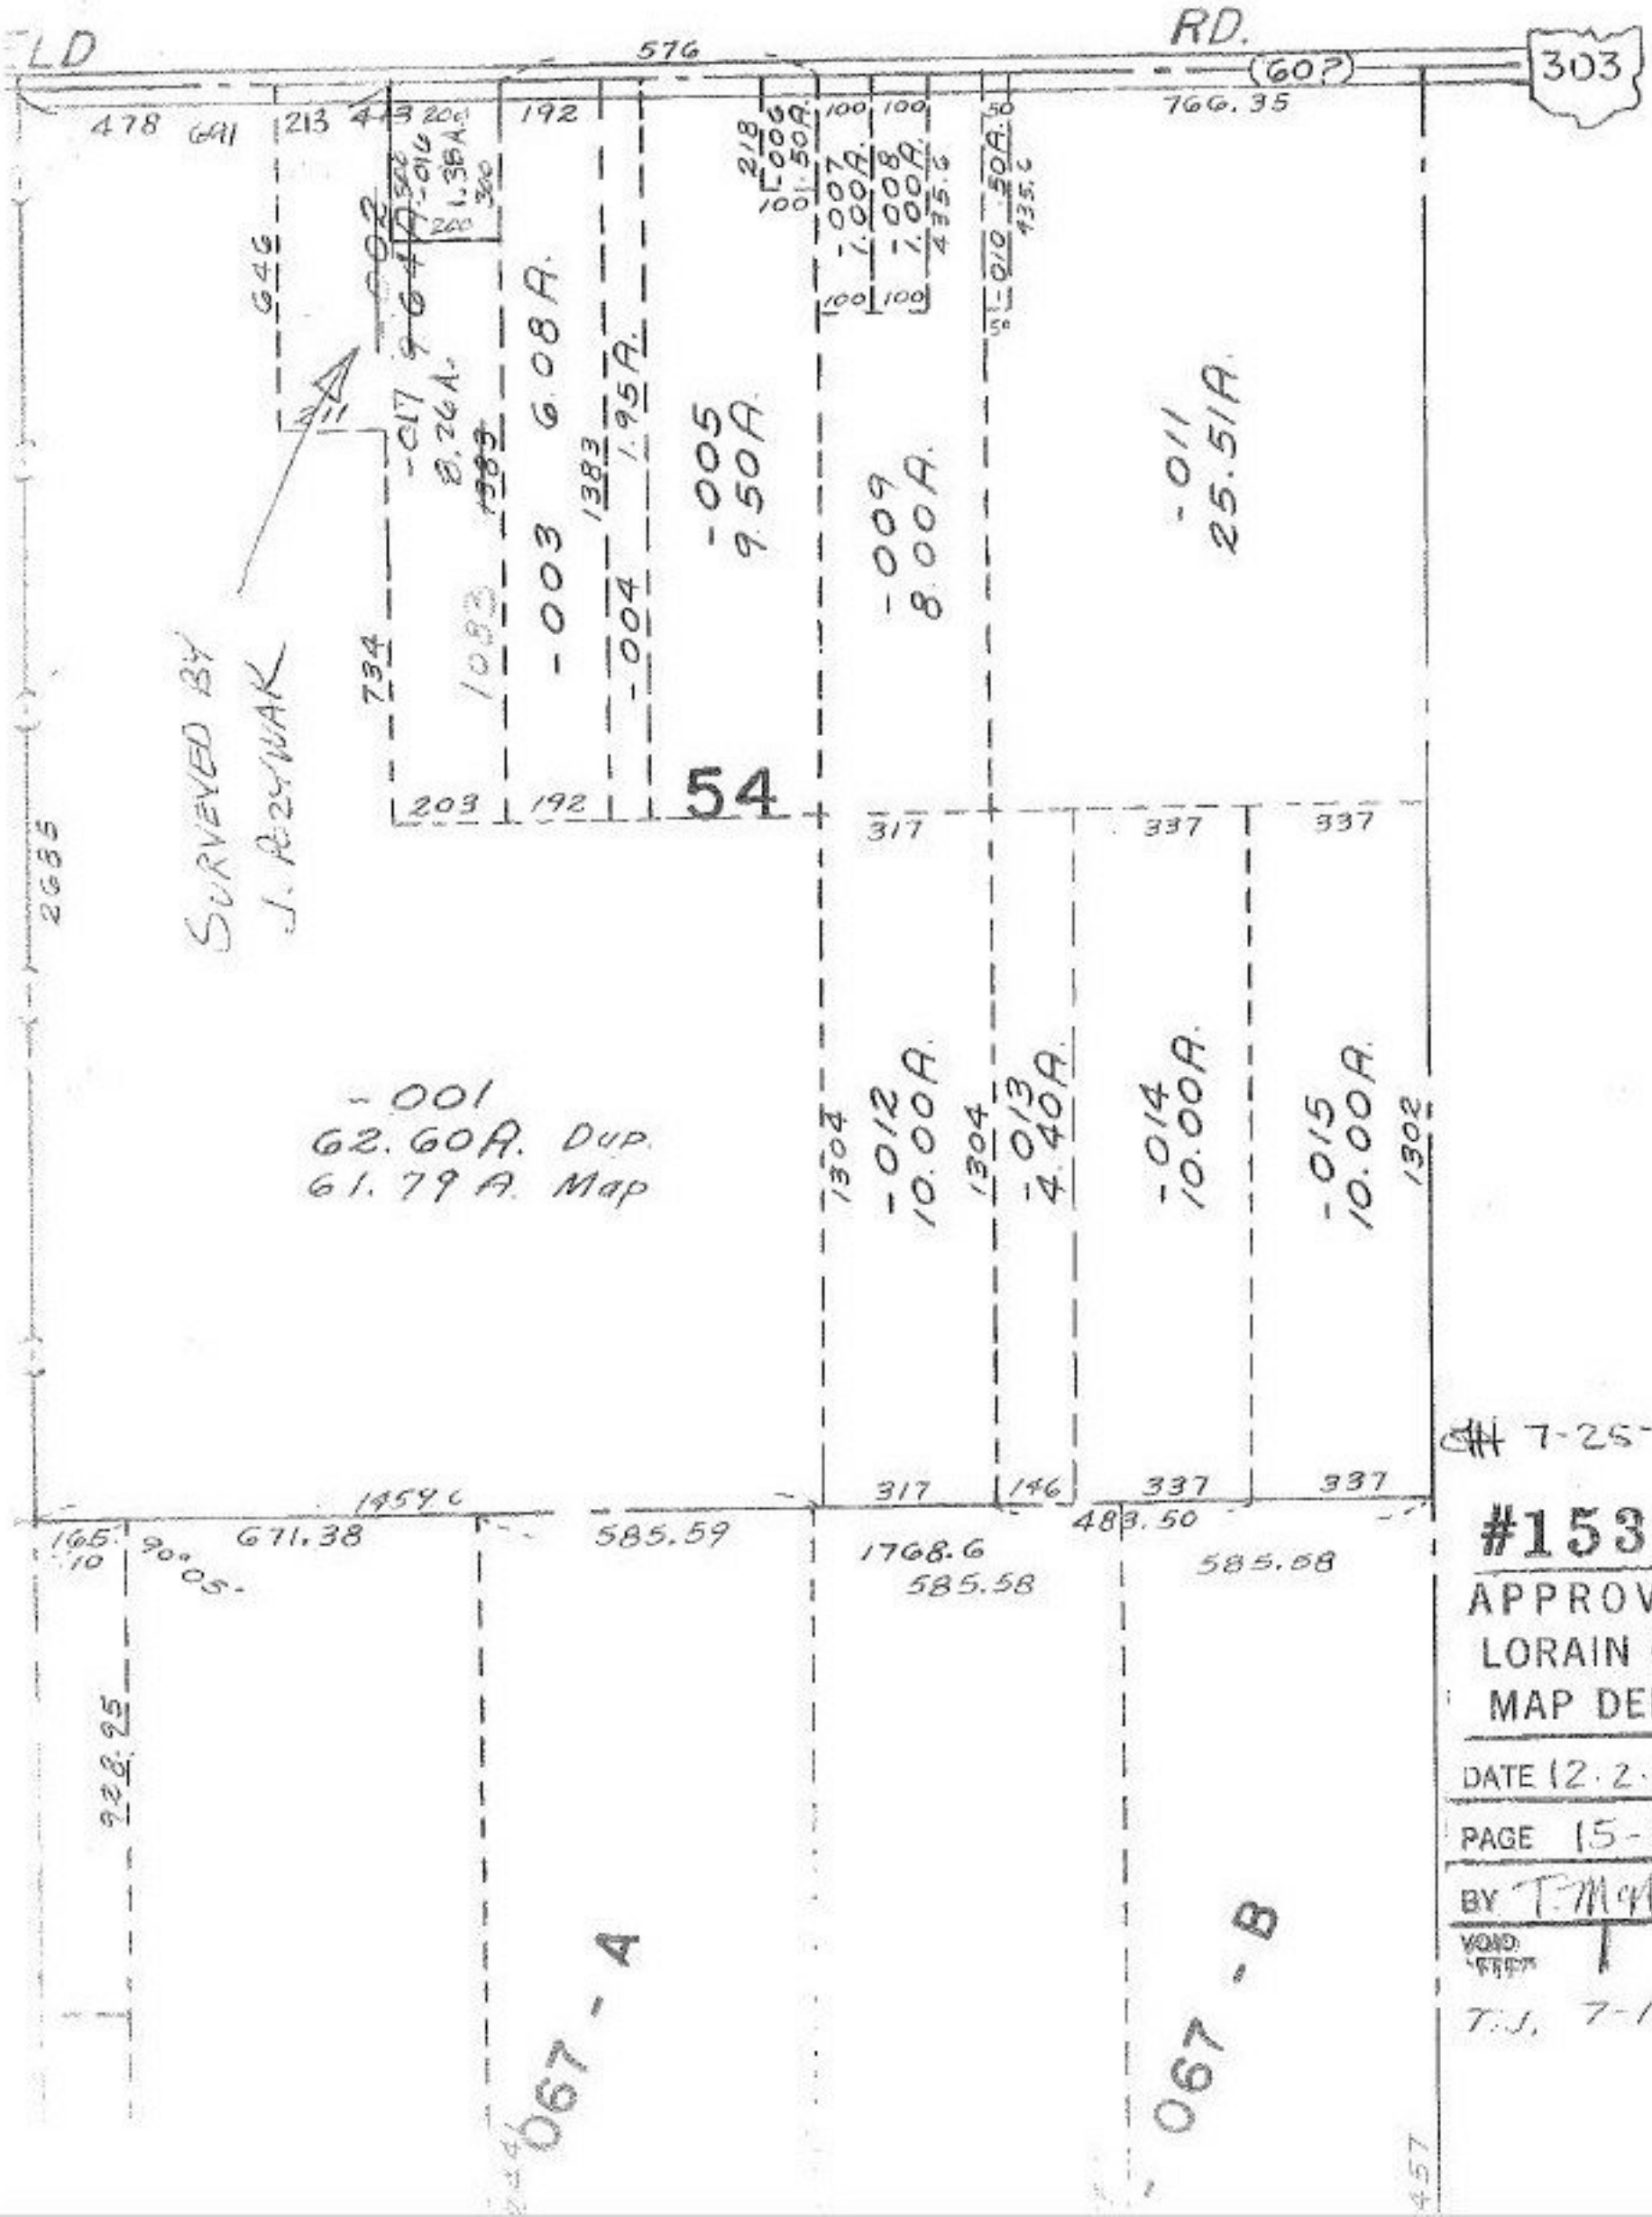

7-25-86

#15383

APPROVED
LORAIN CO.
MAP DEPT.

DATE 12.2.83

PAGE 15-G

BY T. McNair

VOID

T.J. 7-17-84