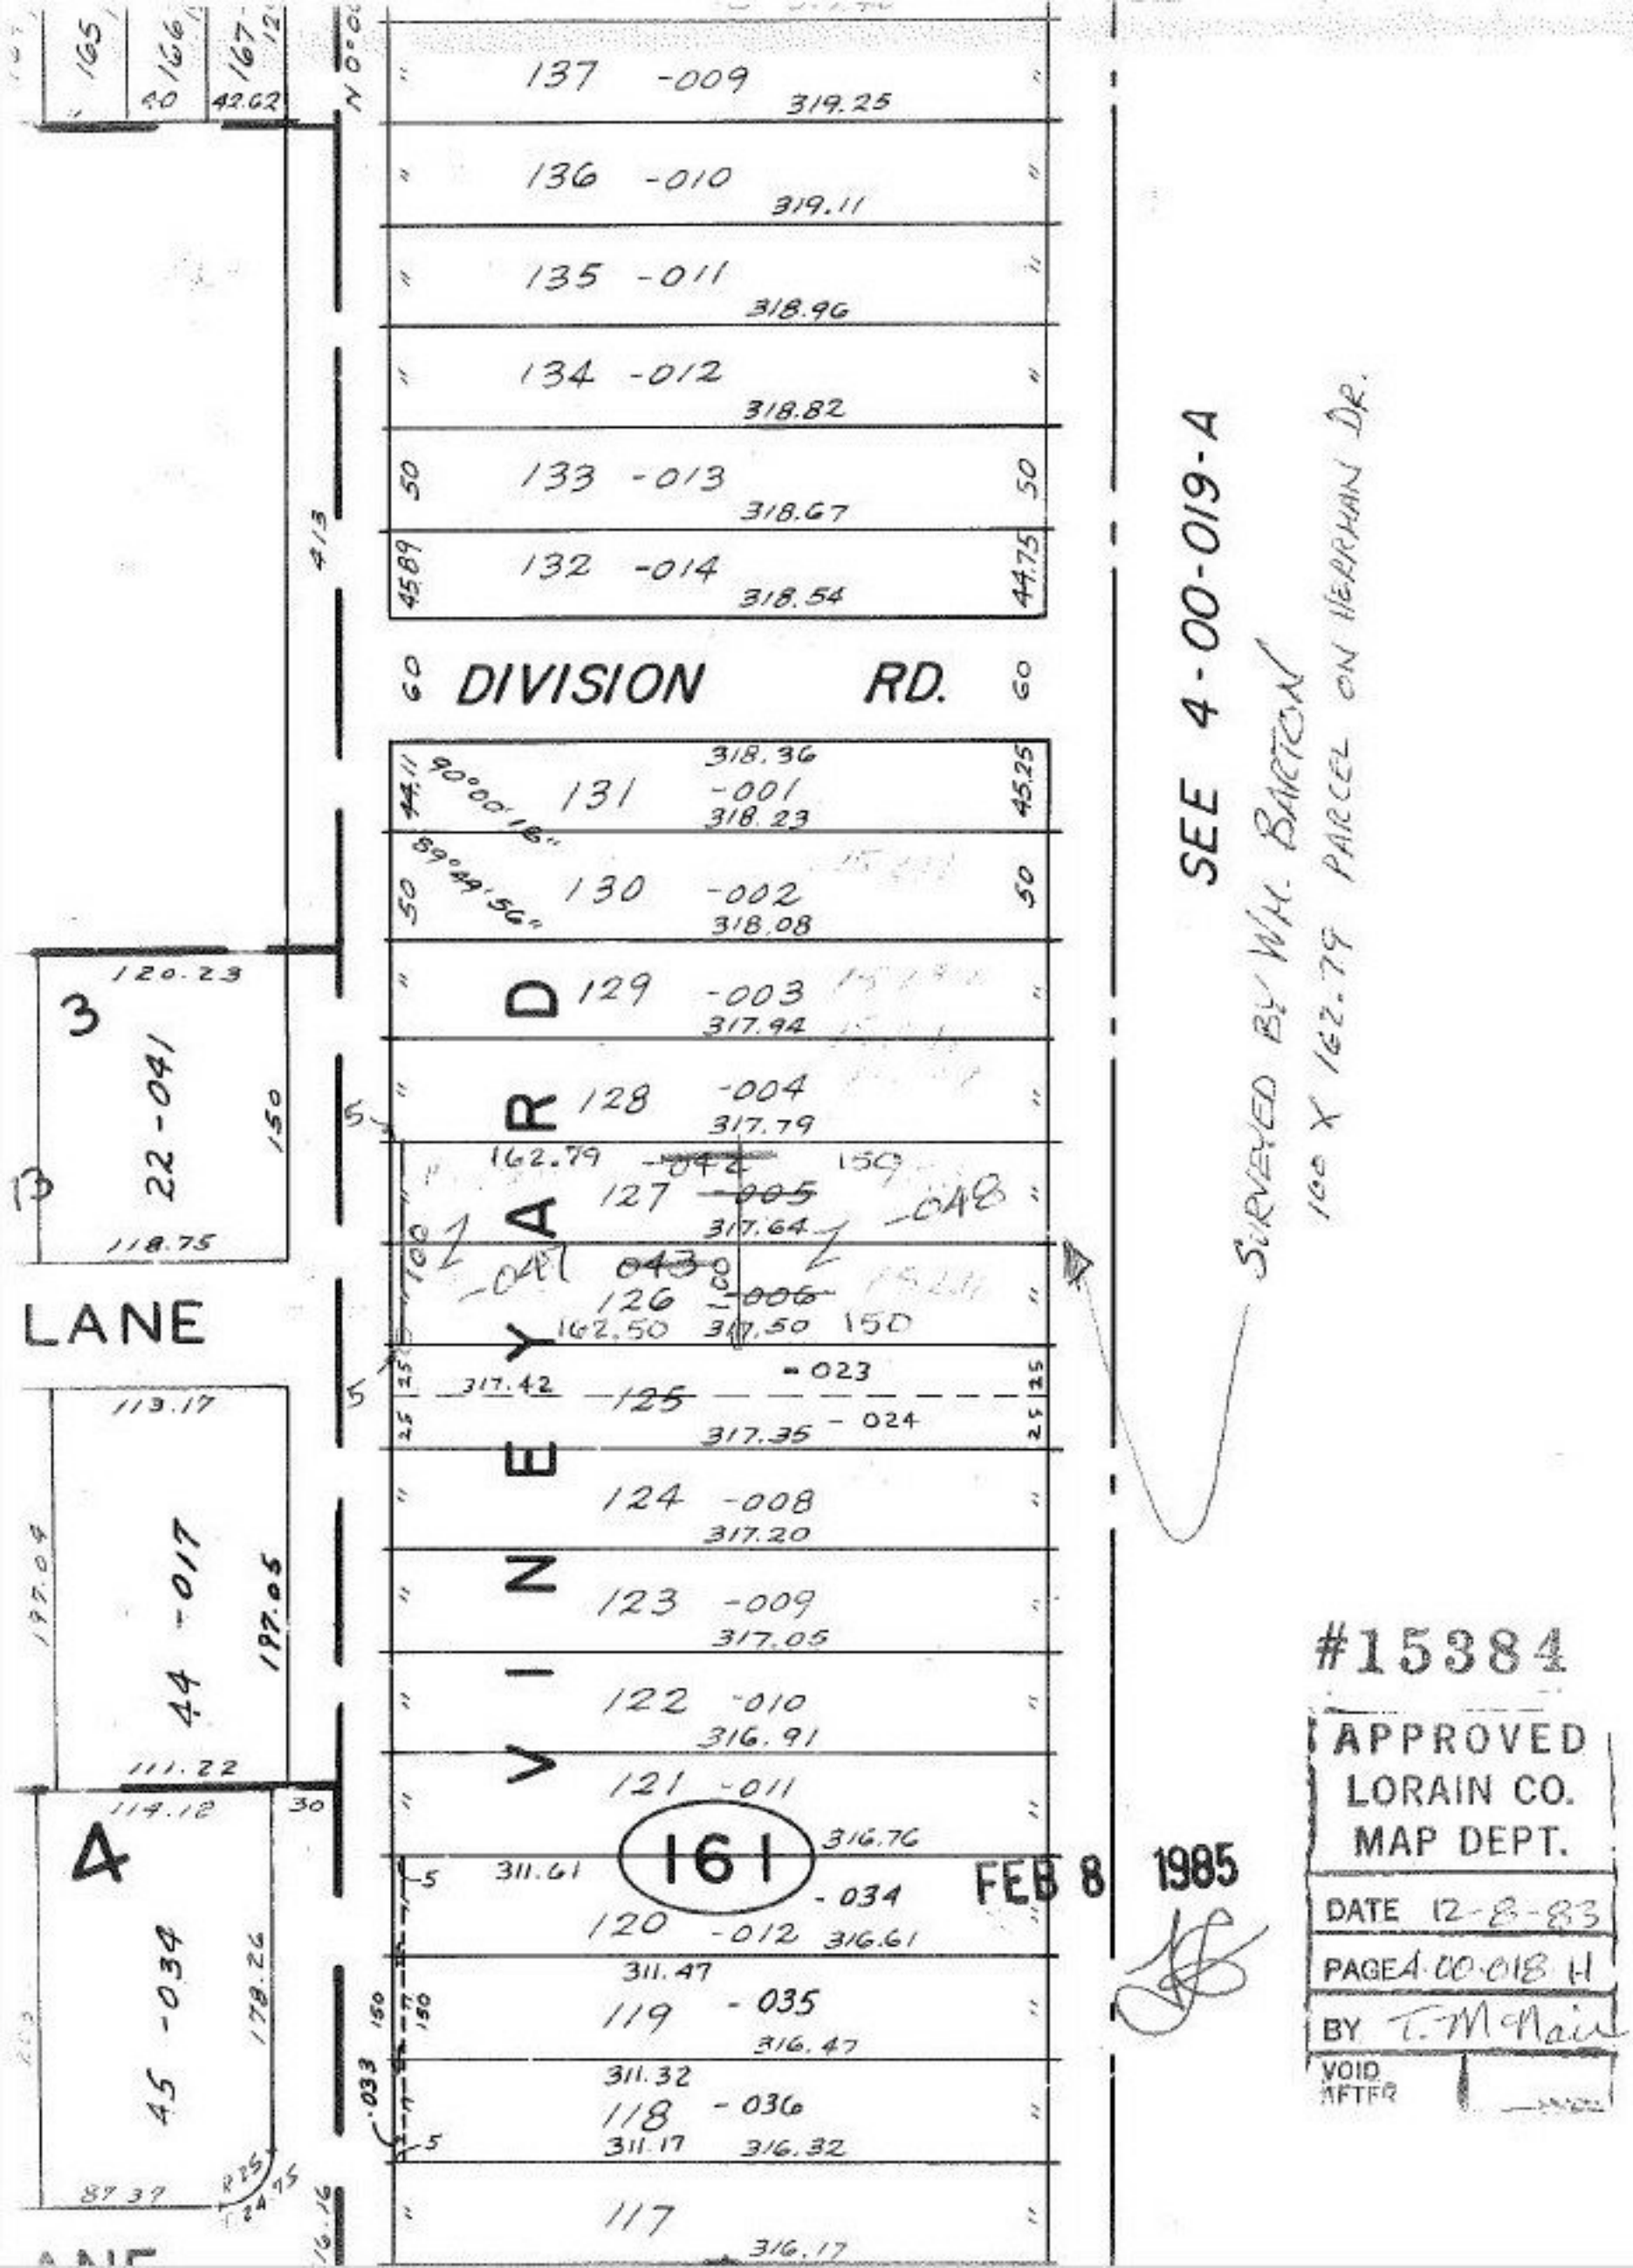

#15384

APPROVED
LORAIN CO.
MAP DEPT.
DATE 12-8-83
PAGE 4-00-018 H
BY T. McNair
VOID AFTER