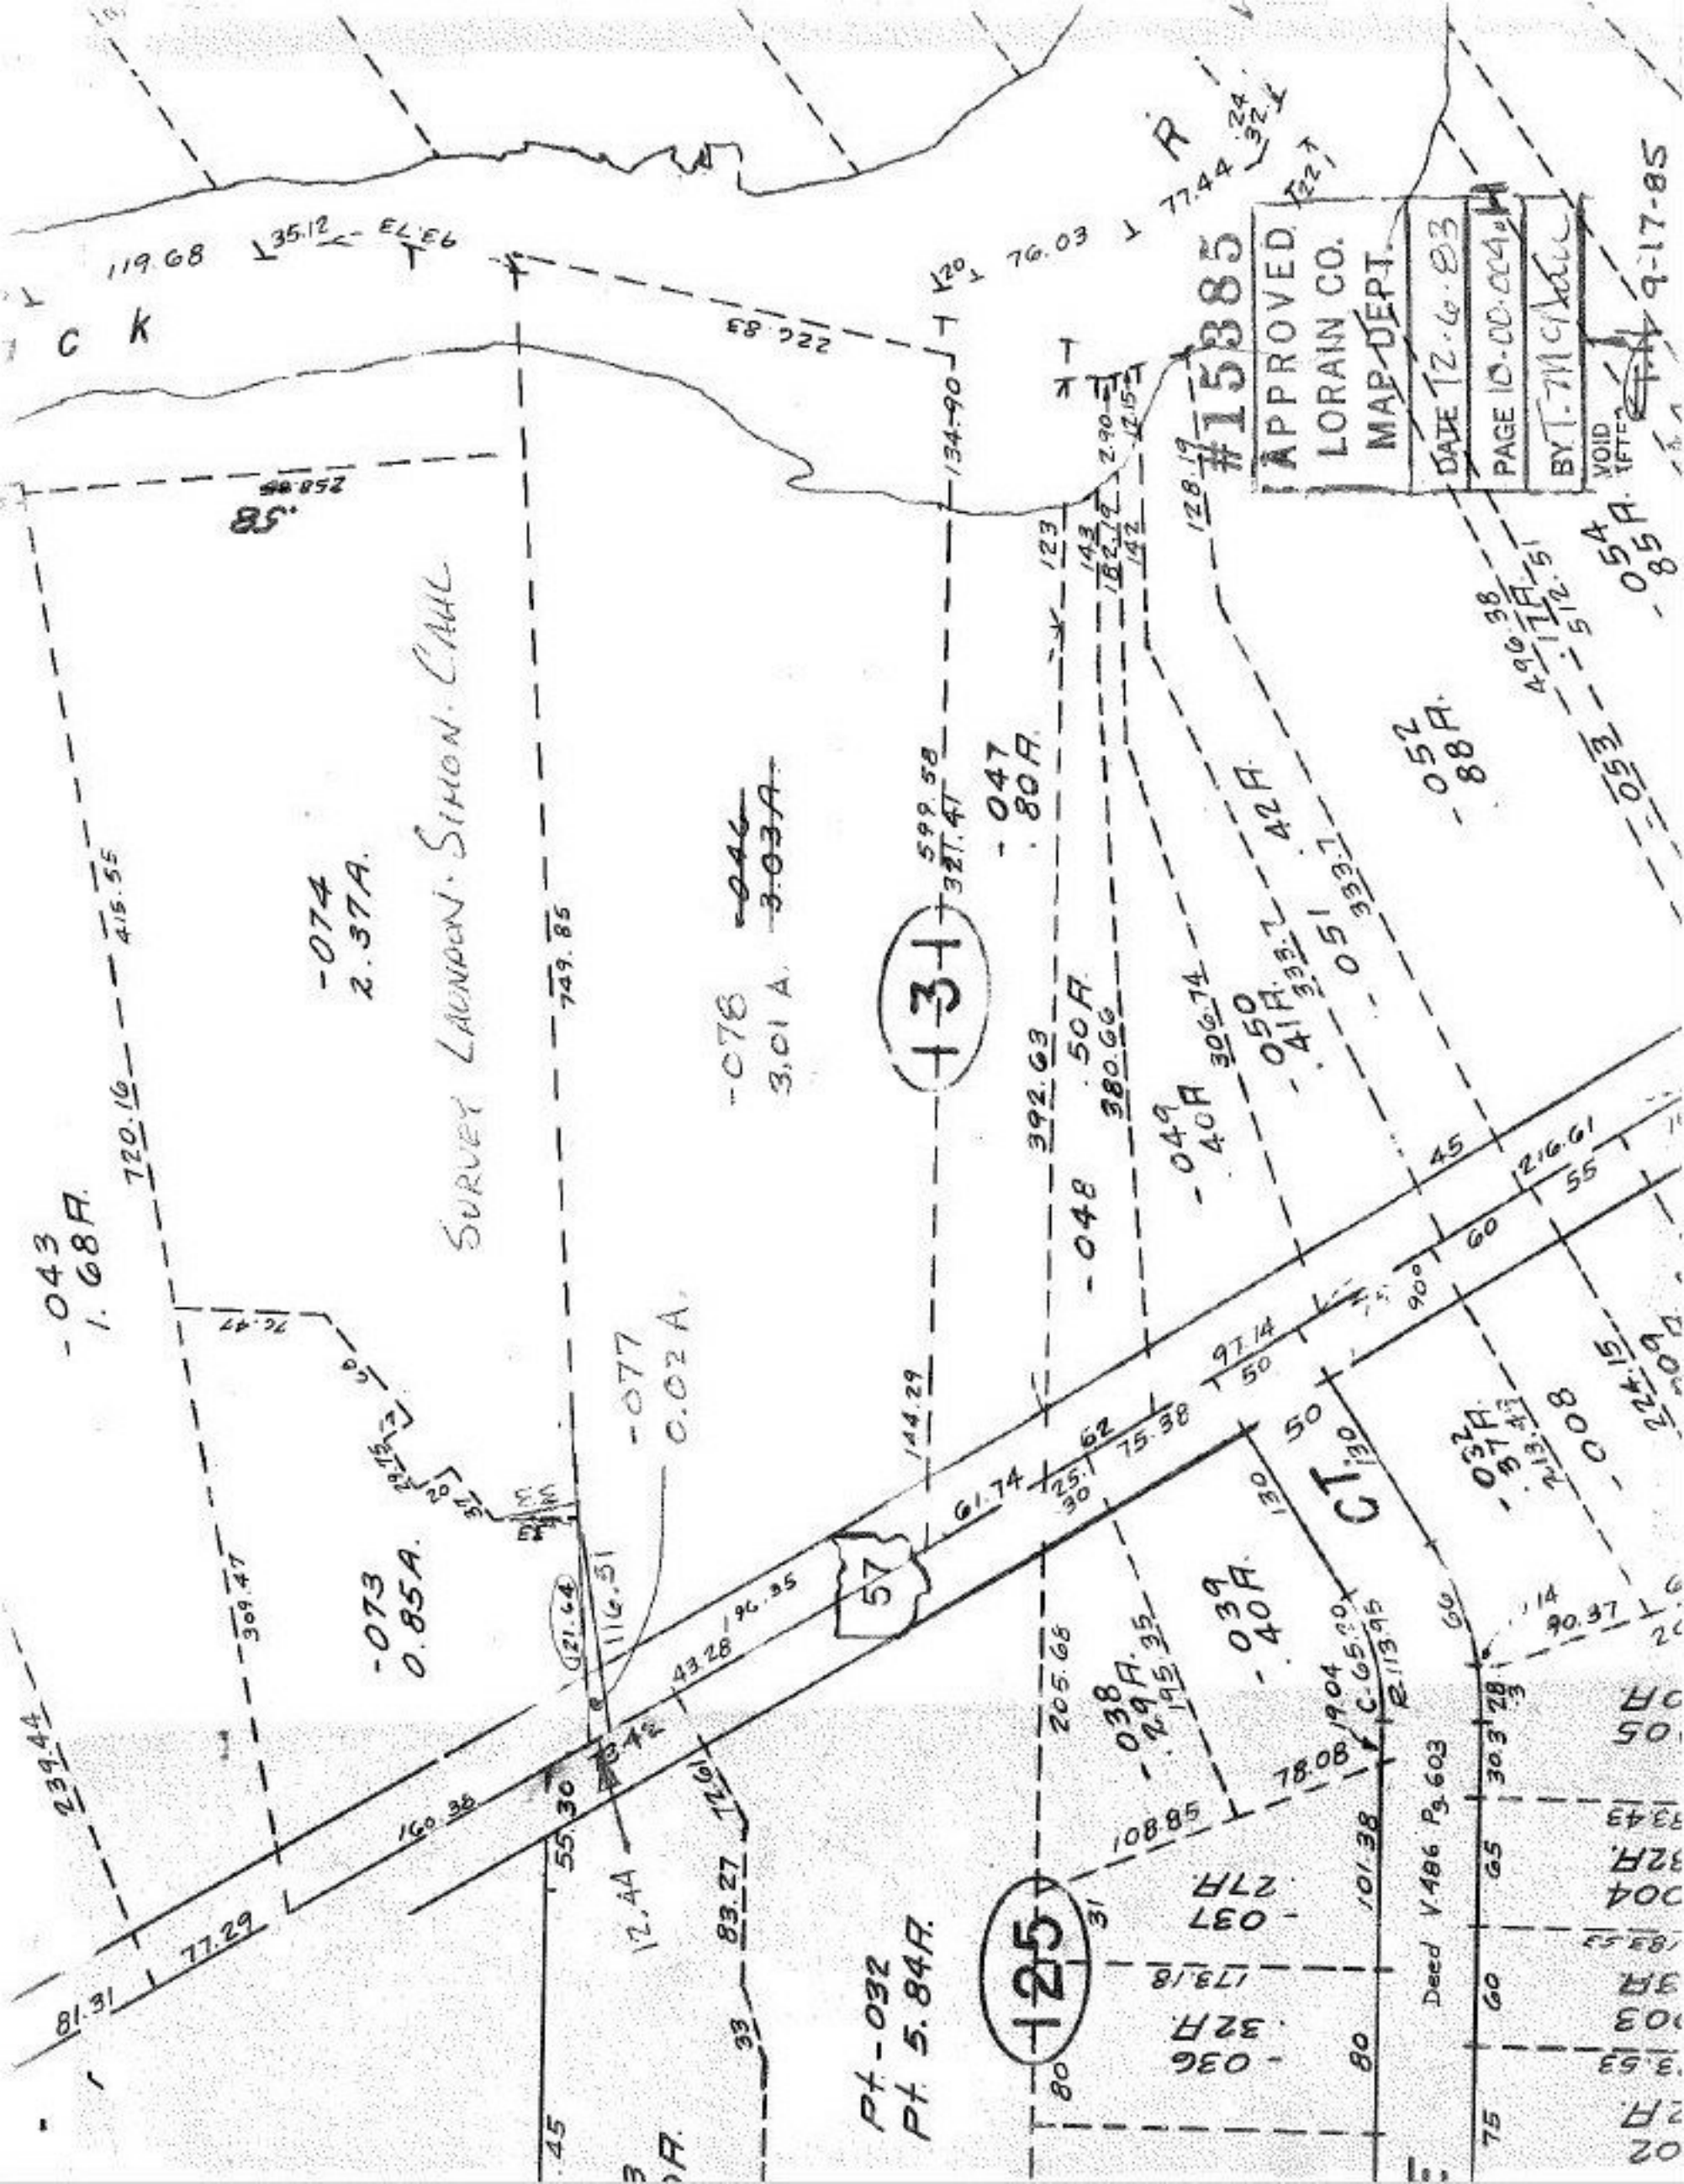

#15385
APPROVED
LORAIN CO.
MAP DEPT.
DATE 12-6-83
PAGE 10-00-004
BY T. McAdam
VOID AFTER
9-17-85
SURVEY LAUNDON SIMON CAHL
-074
2.37A.
-078
3.01 A.
-077
0.02 A.
-073
0.85A.
-043
1.68A.
-047
.80A.
-048
.50A.
-049
.40A.
-050
.41A.
-051
.42A.
-052
.88A.
-054
.85A.
-032
.37A.
-038
.29A.
-039
.40A.
-037
.27A.
-036
.32A.
Pt. -032
Pt. 5.84A.
131
125
57
CT.
Deed V.486 Pg.603