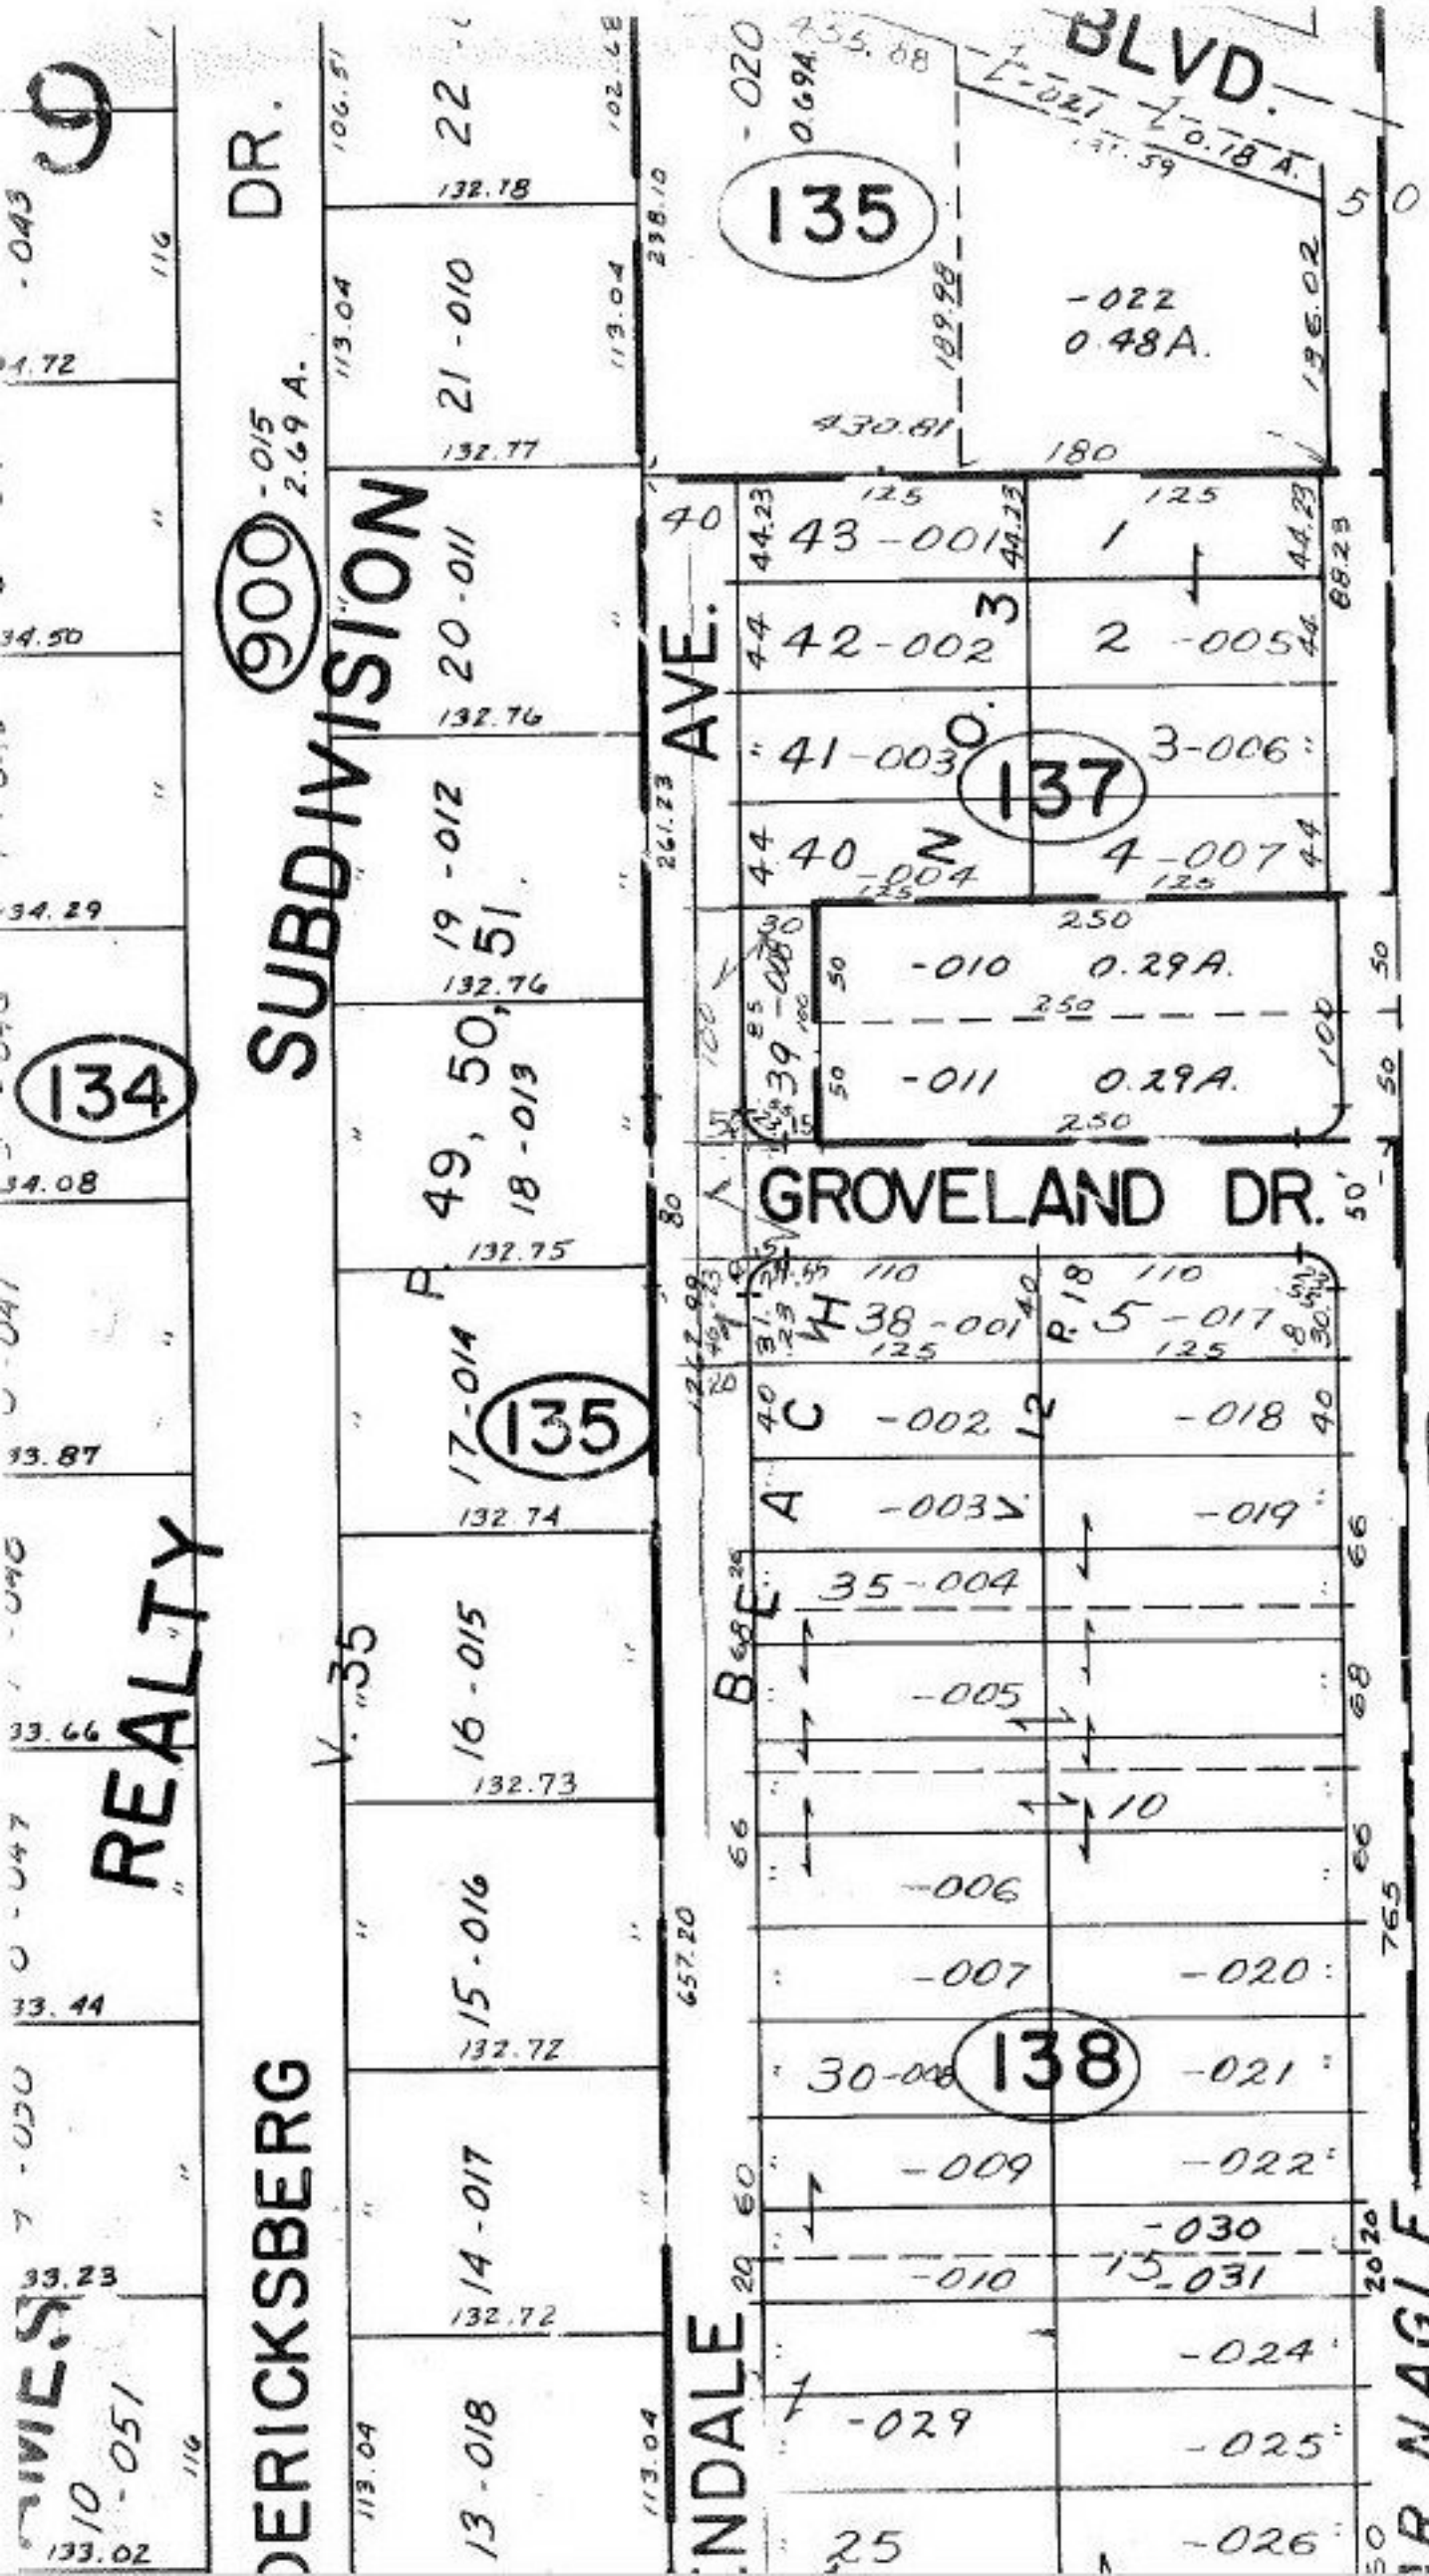

CORRECTION

#15394

APPROVED
LORAIN CO.
MAP DEPT.
DATE 12-13-83
PAGE 4-00-019-D
BY T. McNair
VOID
AFTER

12-19-83