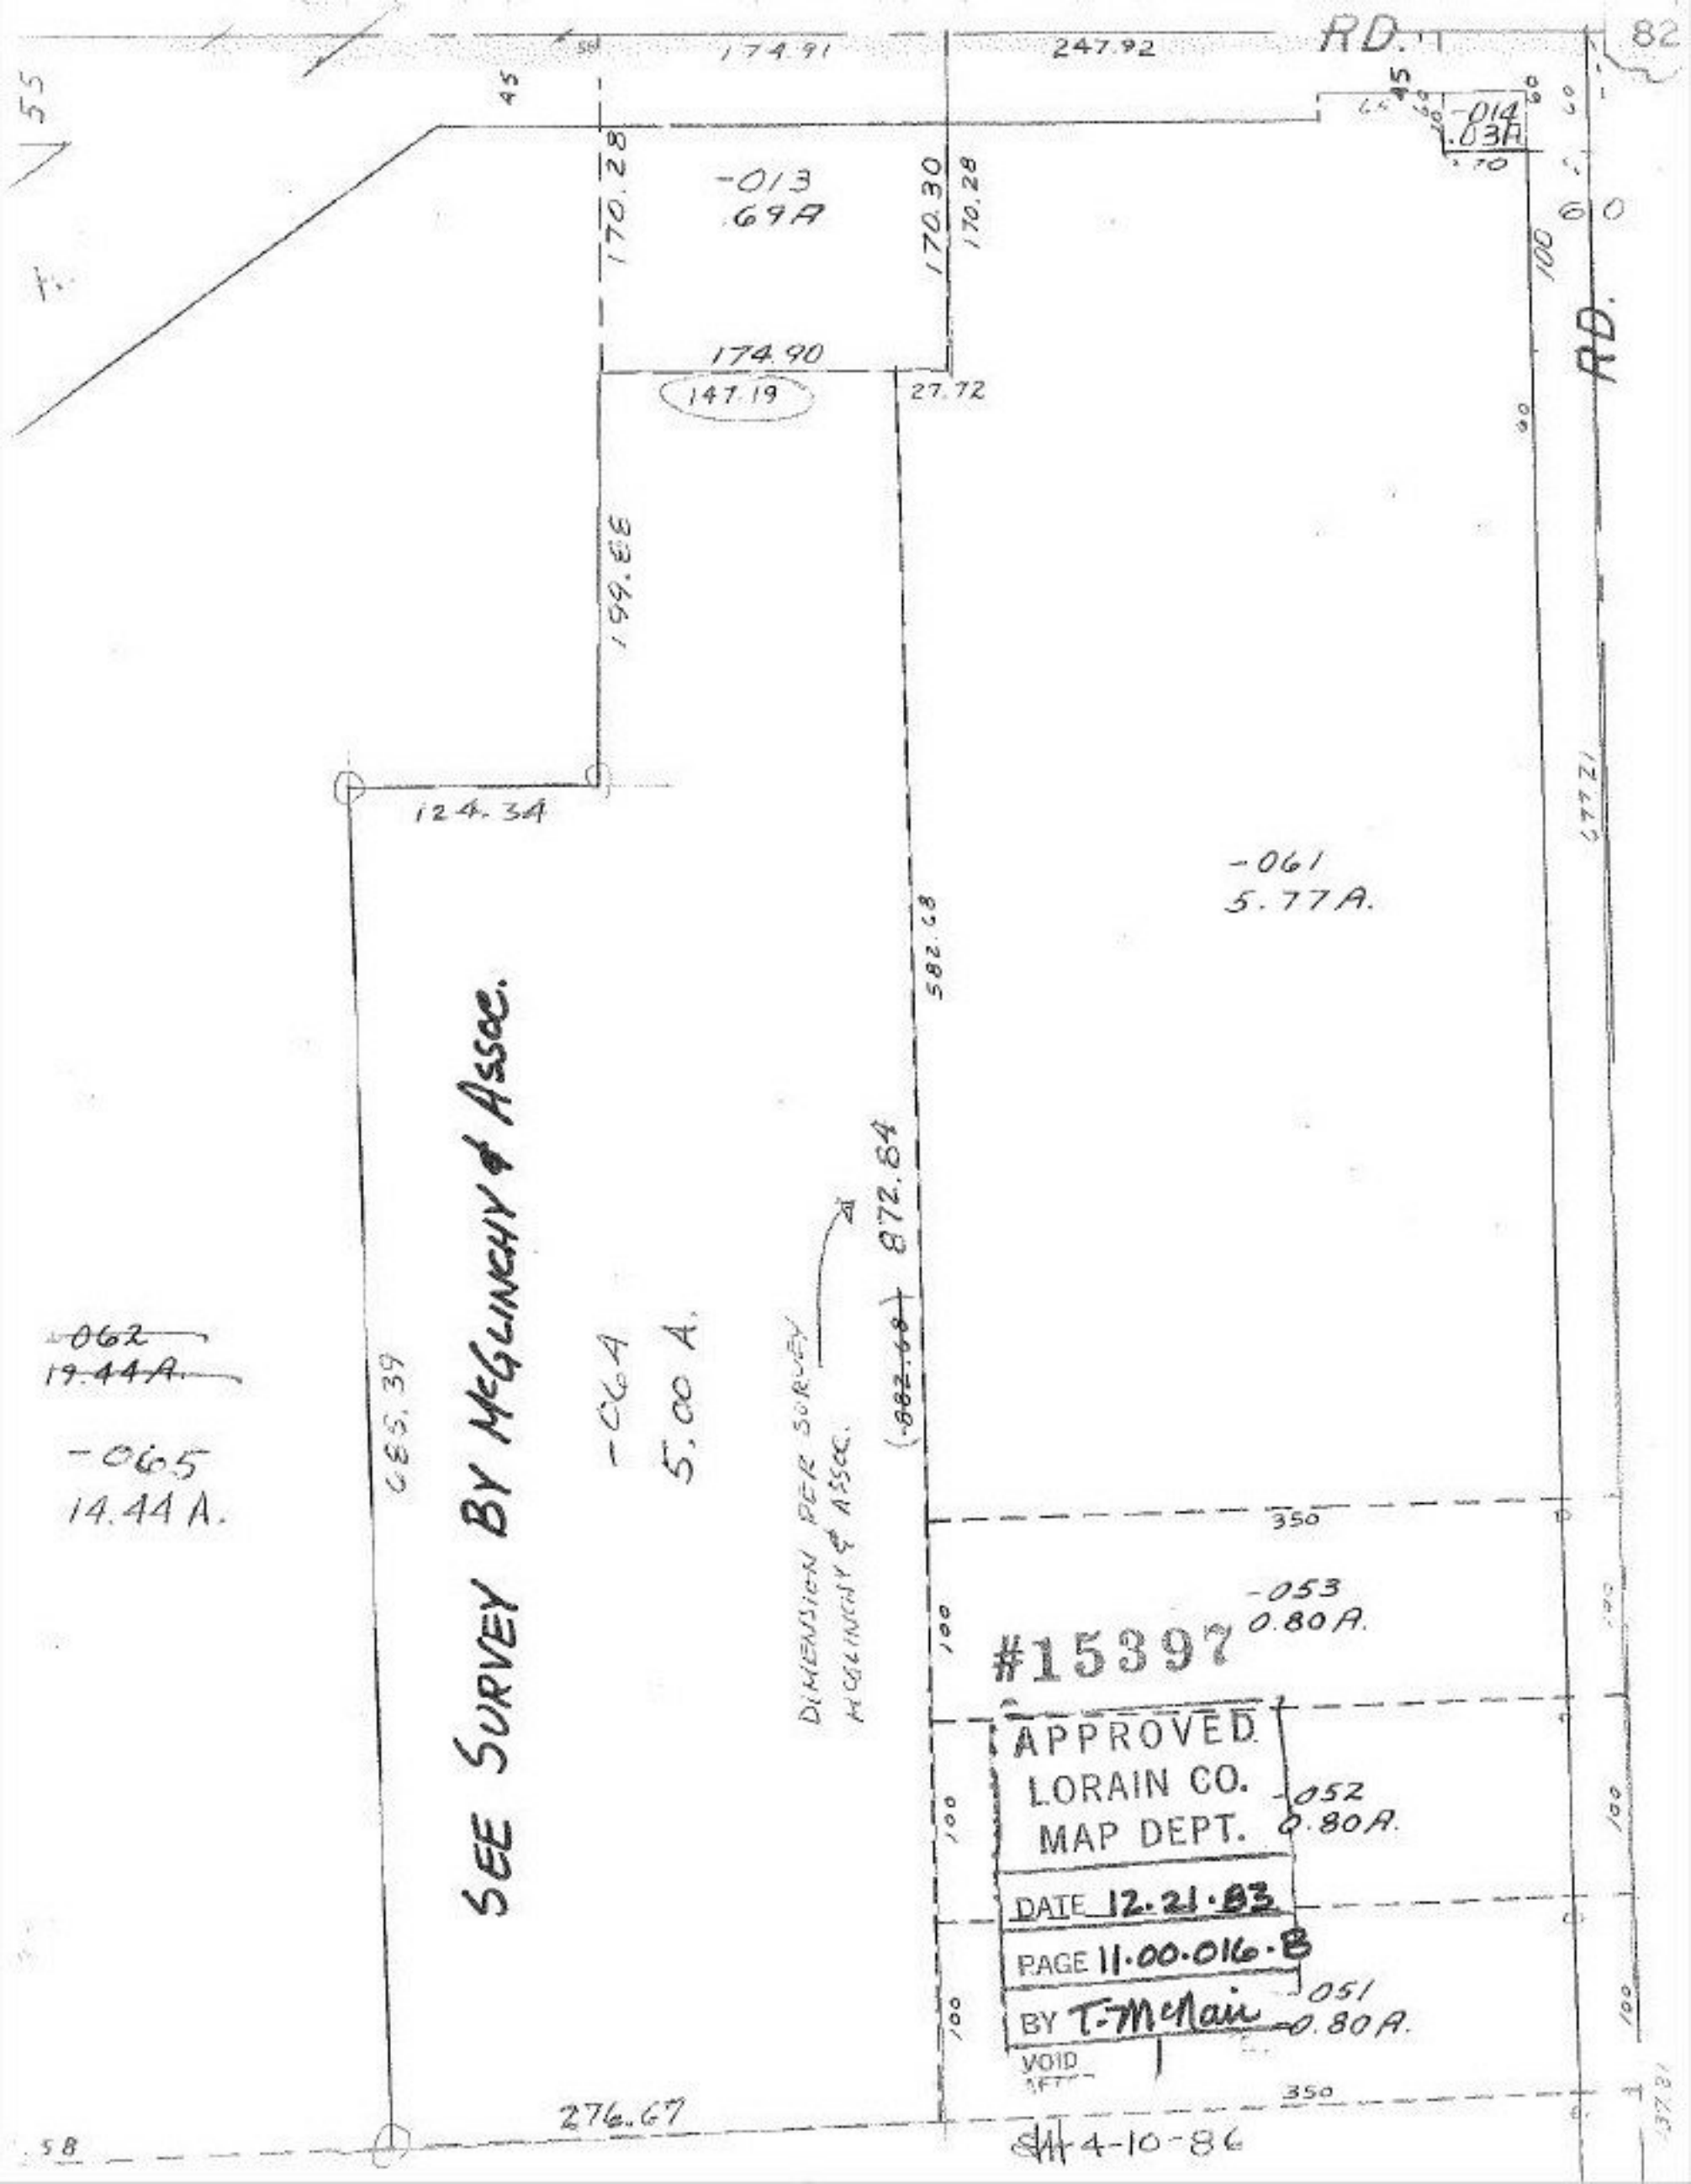

RD.
82
174.91
247.92
-014
.03A
-013
.69A
170.28
170.30
170.28
174.90
147.19
27.72
199.88
124.34
-061
5.77A.
582.68
872.84
(882.68)
SEE SURVEY BY McGLINCHY & Assoc.
-064
5.00 A.
DIMENSION PER SURVEY
McGLINCHY & ASSOC.
685.39
~~-062~~
~~19.44A.~~
-065
14.44 A.
350
-053
0.80A.
#15397
APPROVED
LORAIN CO.
MAP DEPT.
DATE 12.21.83
PAGE 11.00.016.B
BY T. McNair
VOID
-052
0.80A.
-051
0.80A.
276.67
4-10-86