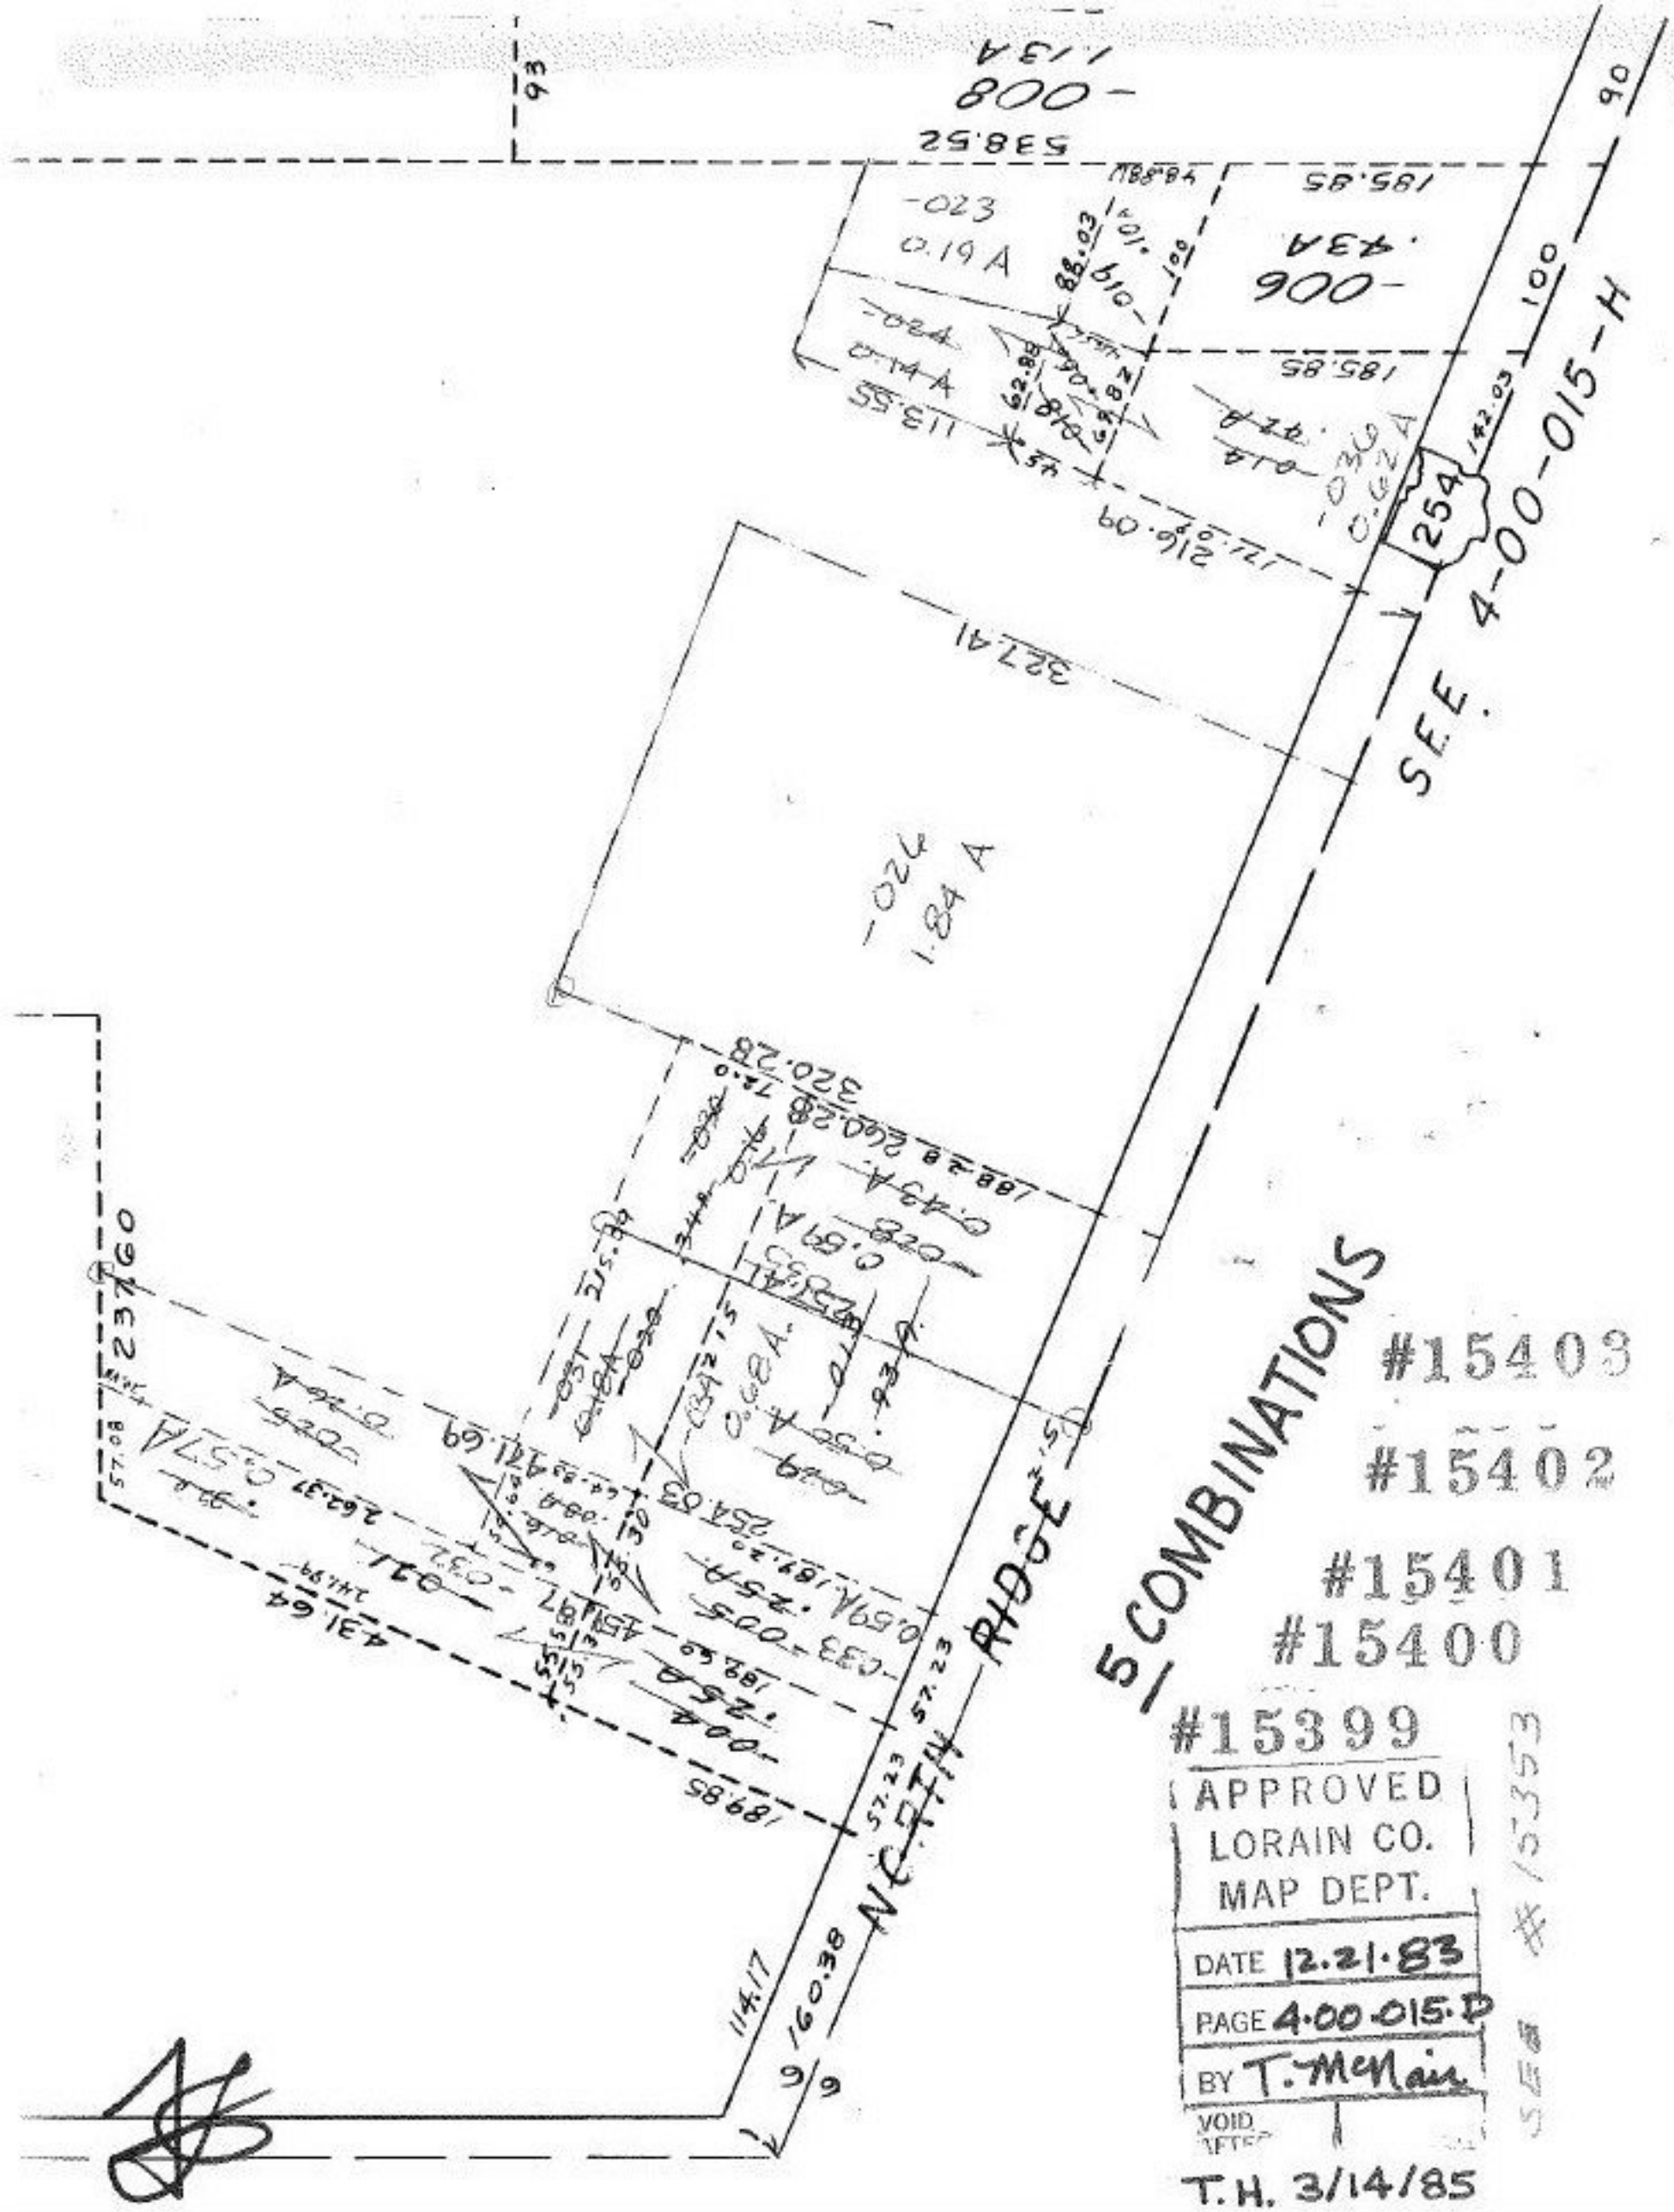

#15403

#15402

#15401

#15400

#15399

APPROVED
LORAIN CO.
MAP DEPT.

DATE 12.21.83

PAGE 4.00.015.D

BY T. McNair

VOID AFTER

SEE #15353

T.H. 3/14/85