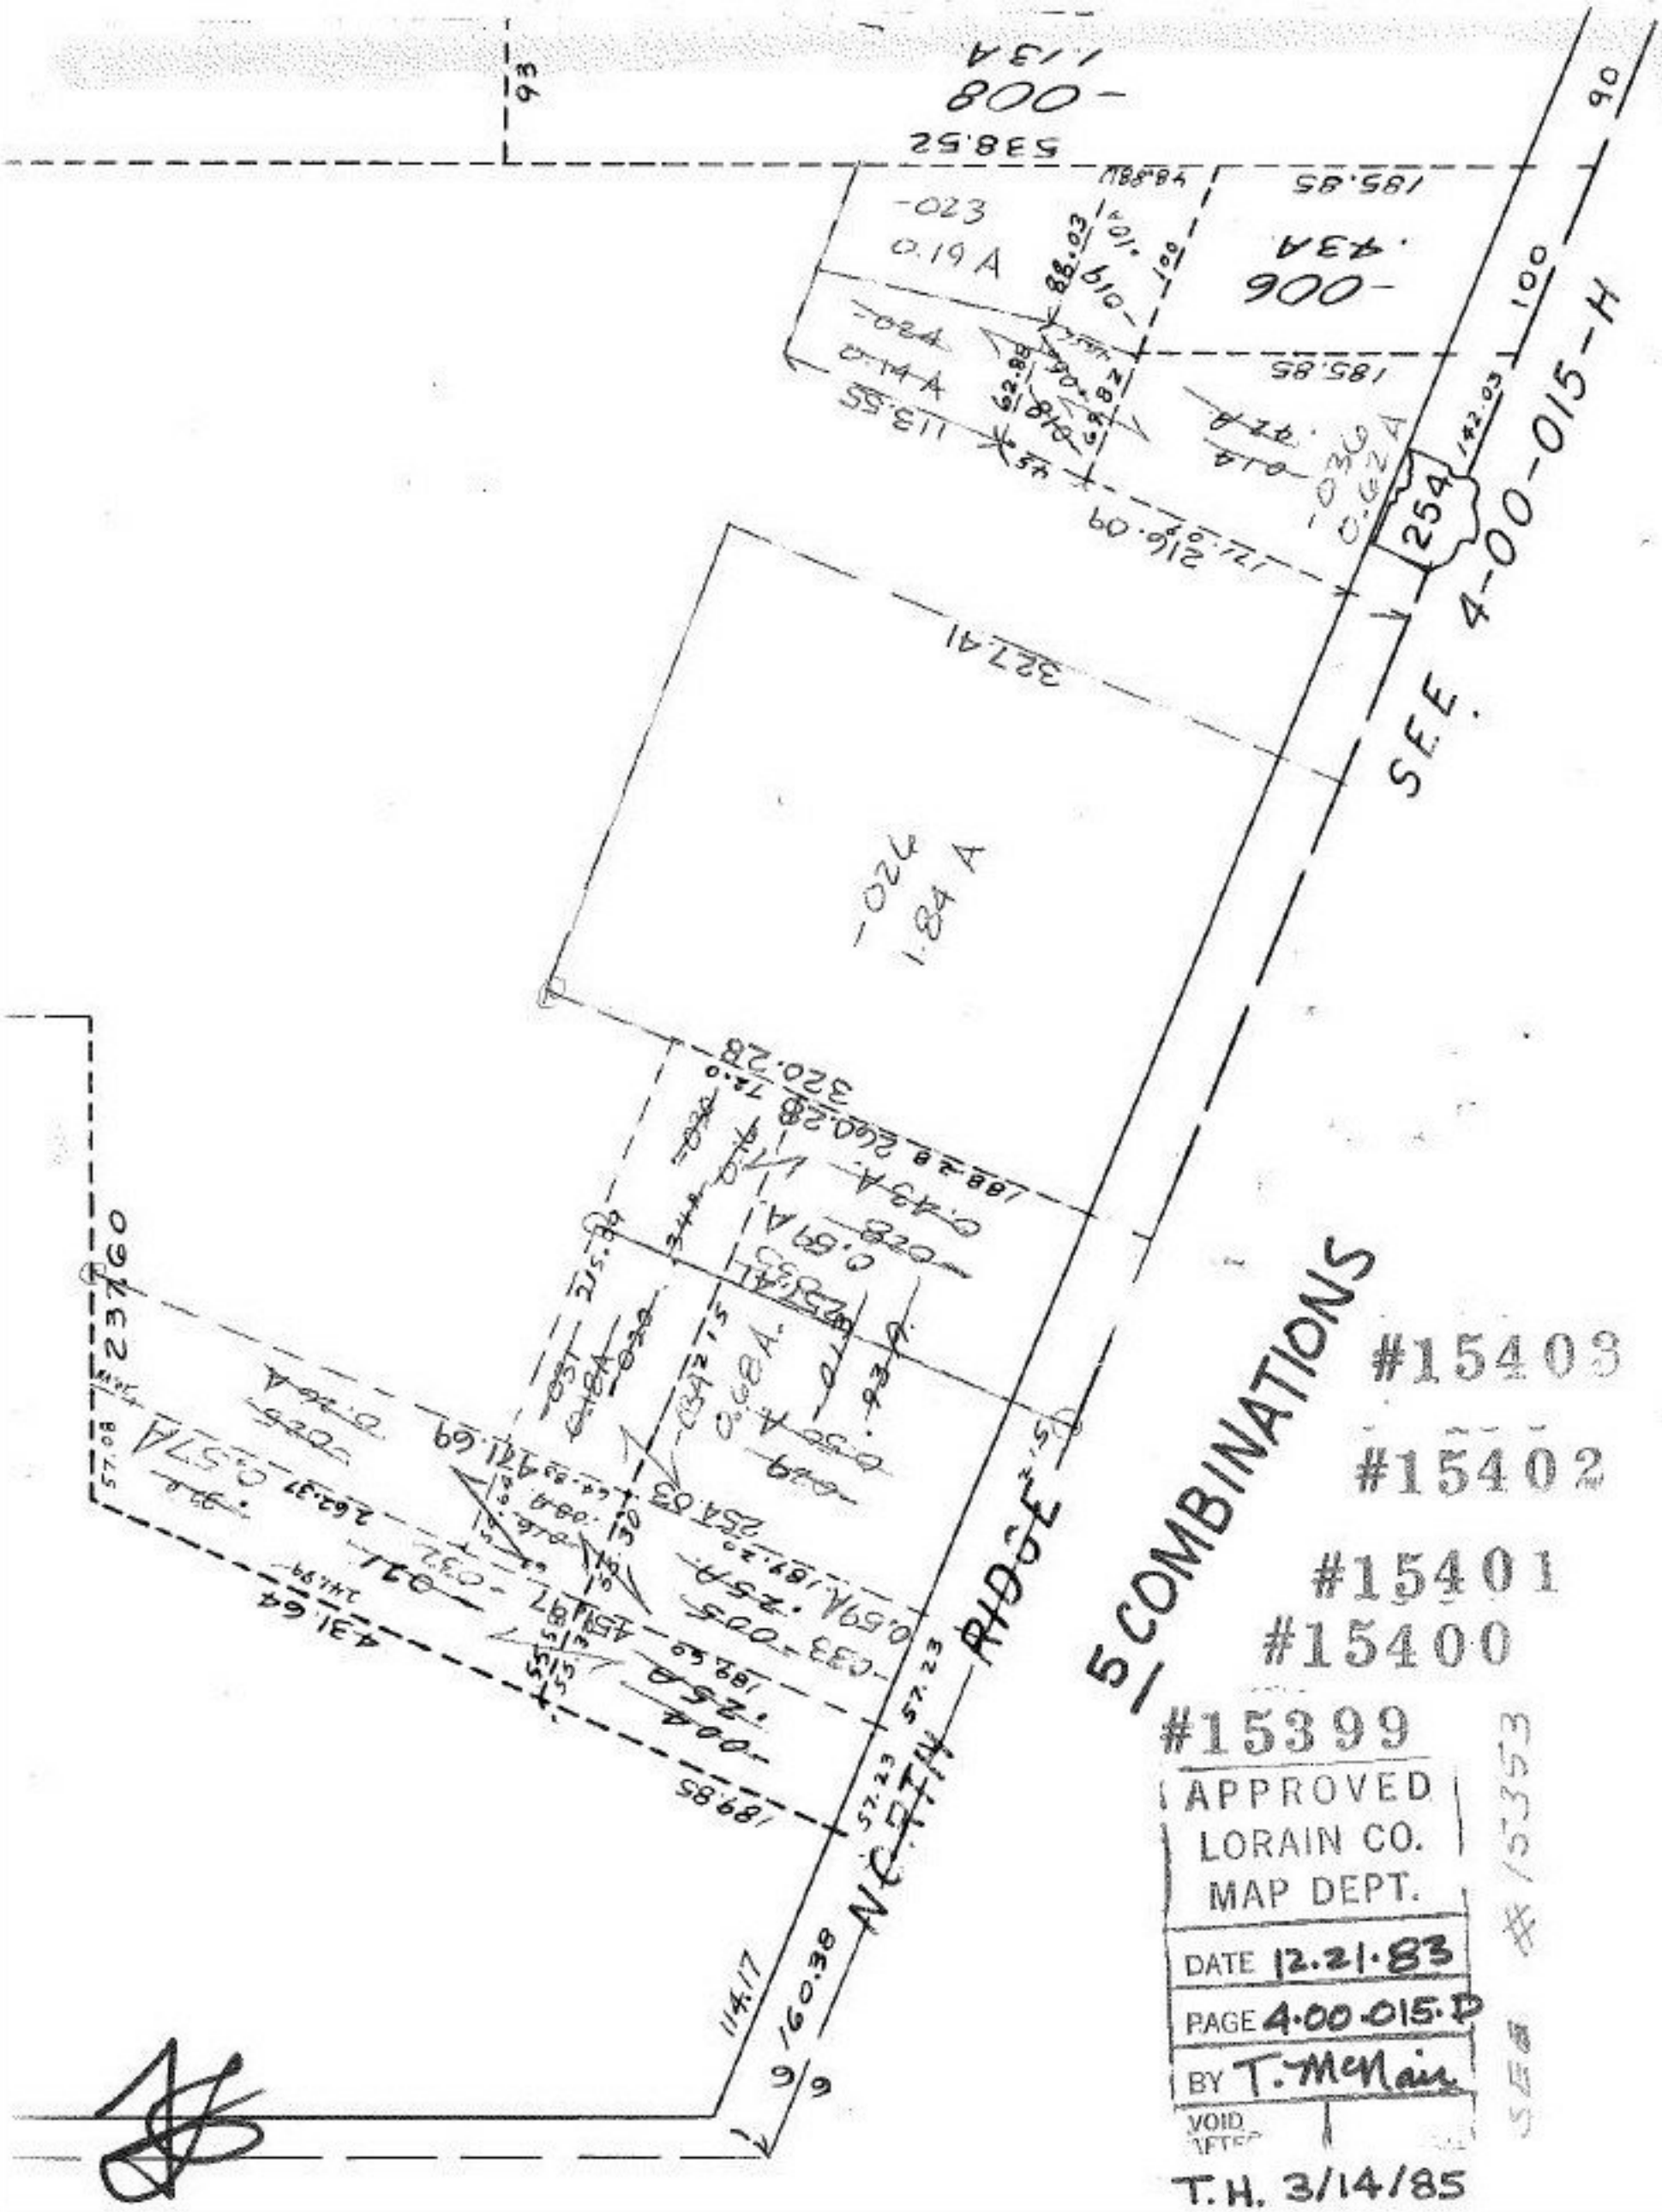

SEE 4-00-015-H
254
NORTH RIDGE
5 COMBINATIONS
#15403
#15402
#15401
#15400
#15399
APPROVED
LORAIN CO.
MAP DEPT.
DATE 12.21.83
PAGE 4.00.015.D
BY T. McNair
VOID AFTER
T.H. 3/14/85
SEE #15353