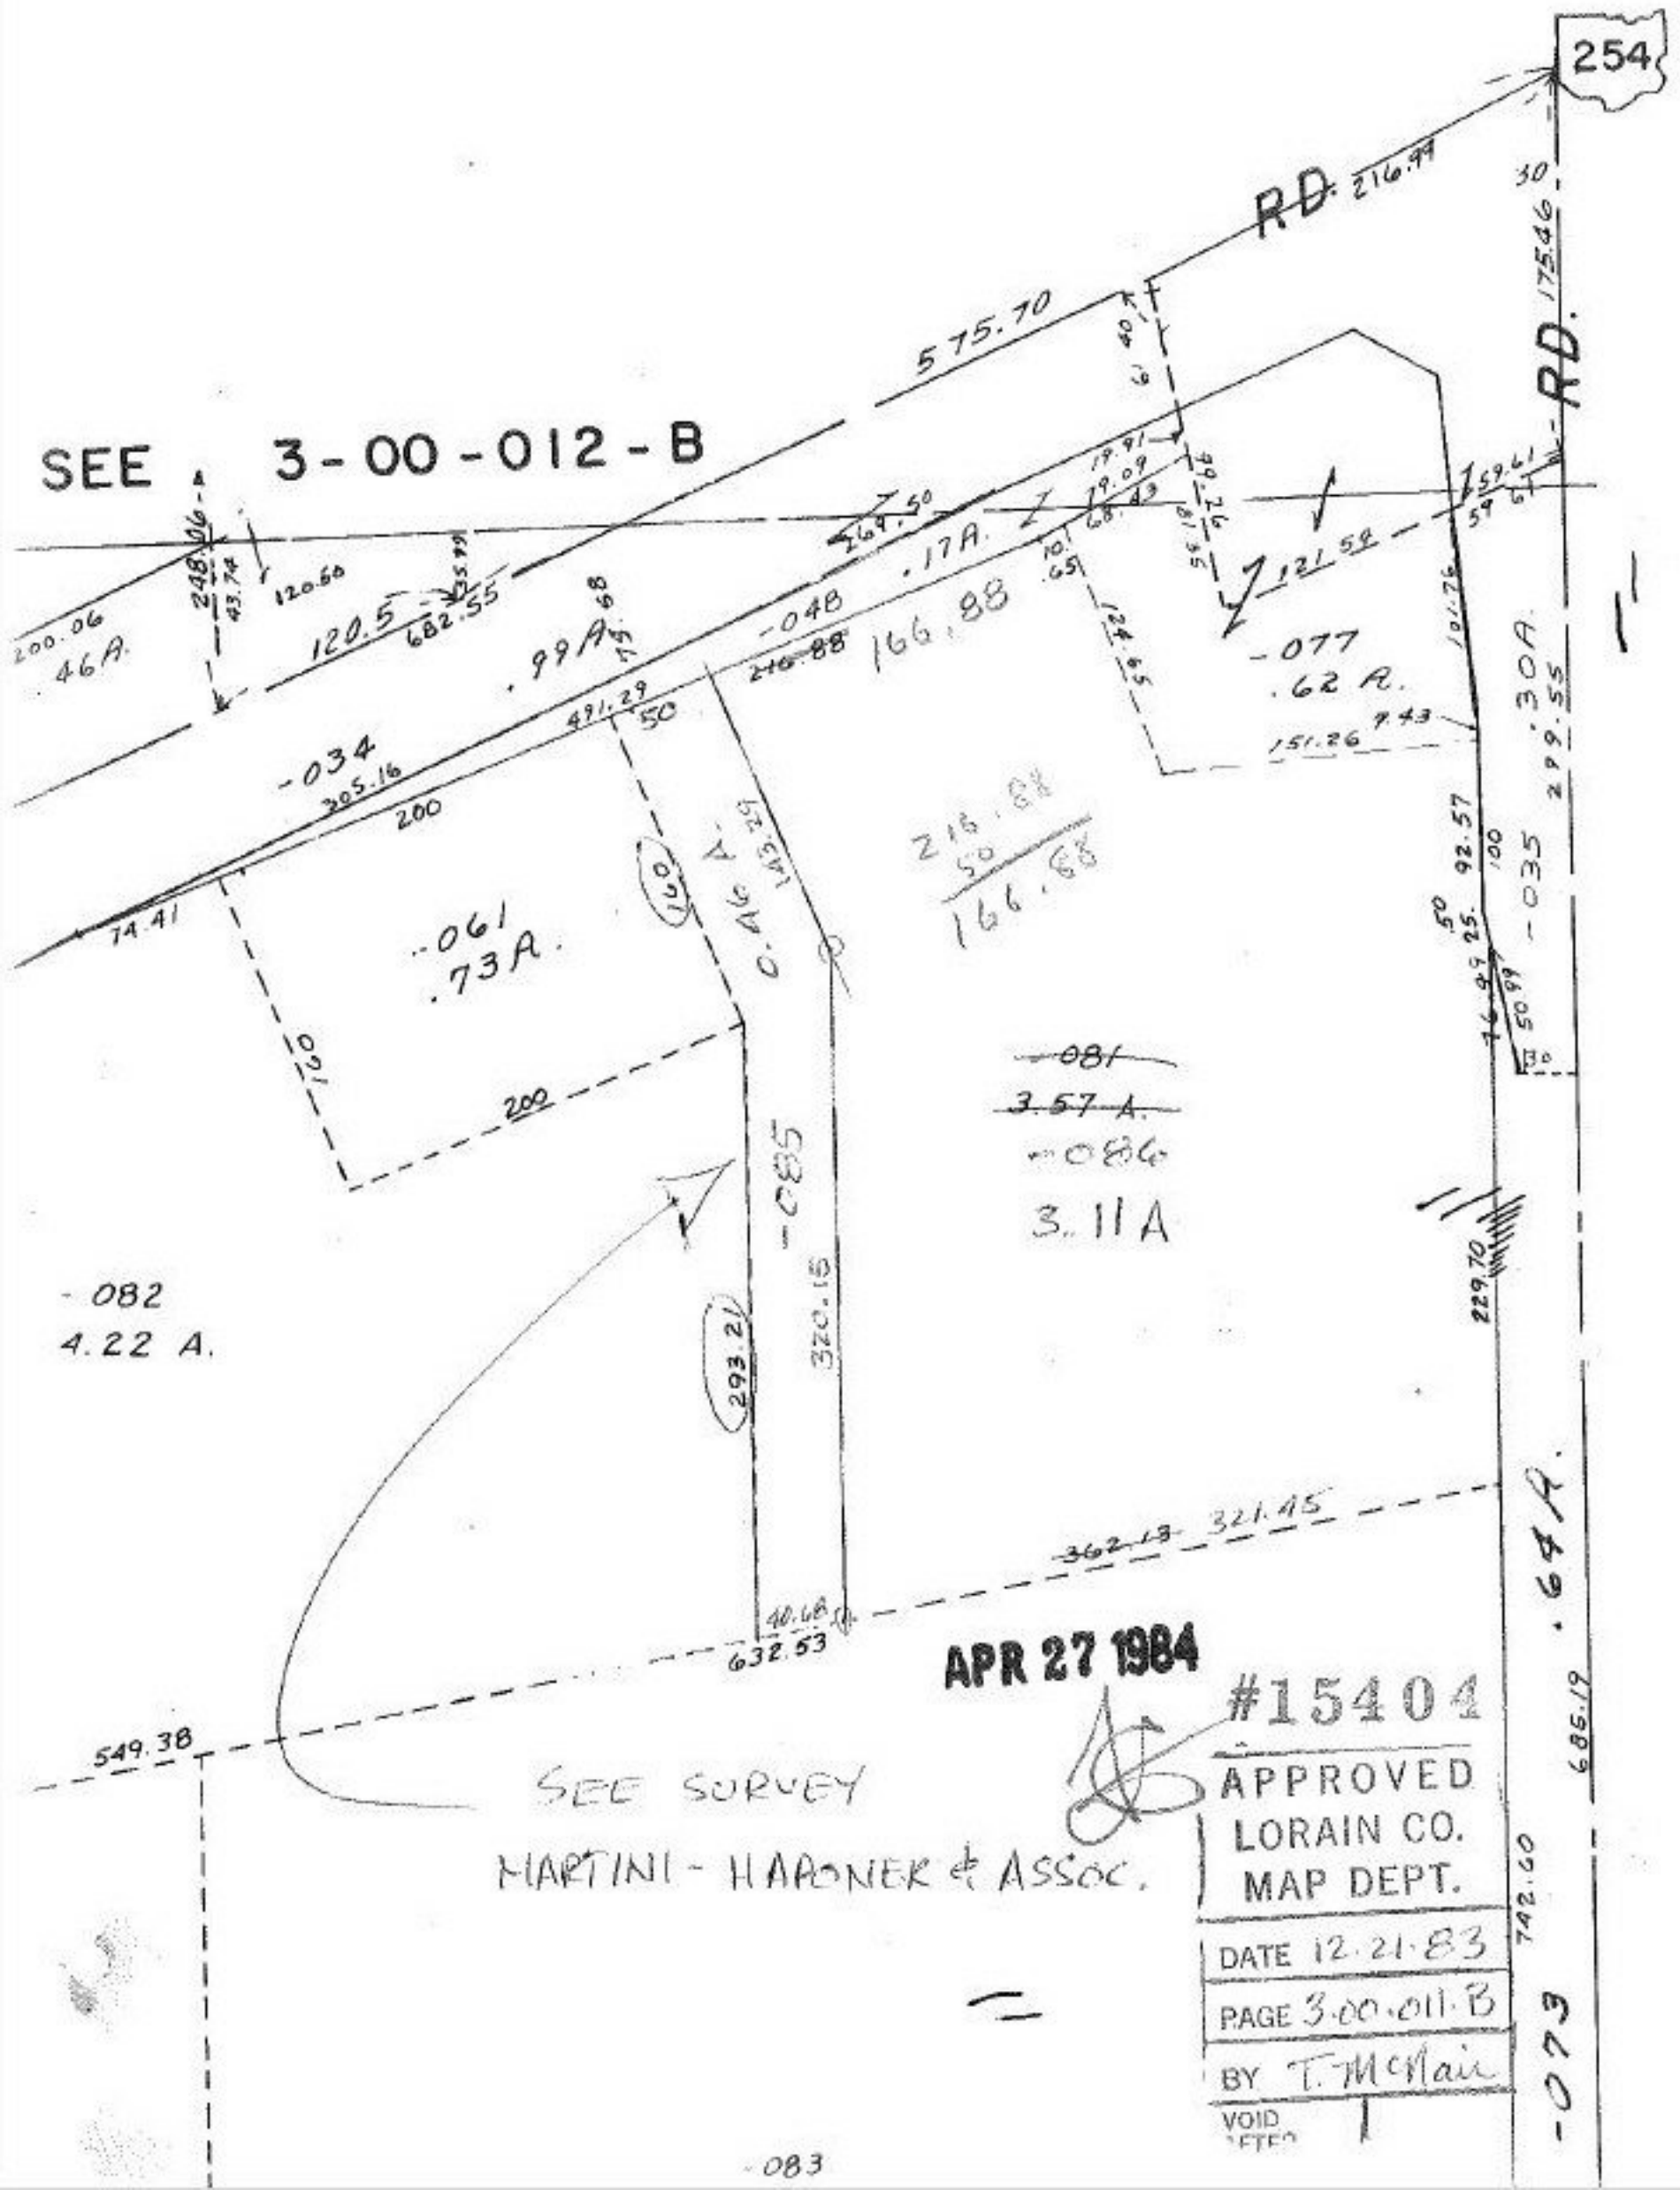
SEE 3-00-012-B
254
RD.
216.99
575.70
RD.
1754.6
30
61.40
19.91
19.09
68.43
59.61
59.61
121.58
101.26
-077
.62 A.
151.26
7.43
-035
.30A.
299.55
-034
.99A
491.29
50
200
305.16
74.41
-048
.17A.
166.88
216.88
-061
.73A.
100
200
100
-085
320.15
293.21
-086
3.11A
-081
3.57 A.
-082
4.22 A.
216.68
50
166.68
92.57
100
25.
50
229.70
-083
362.18
321.45
40.68
632.53
549.38
APR 27 1984
#15404
APPROVED
LORAIN CO.
MAP DEPT.
DATE 12-21-83
PAGE 3-00-011-B
BY T. McNair
VOID
SEE SURVEY
MARTINI - HARONER & ASSOC.
742.60
686.19
.64A.
-073