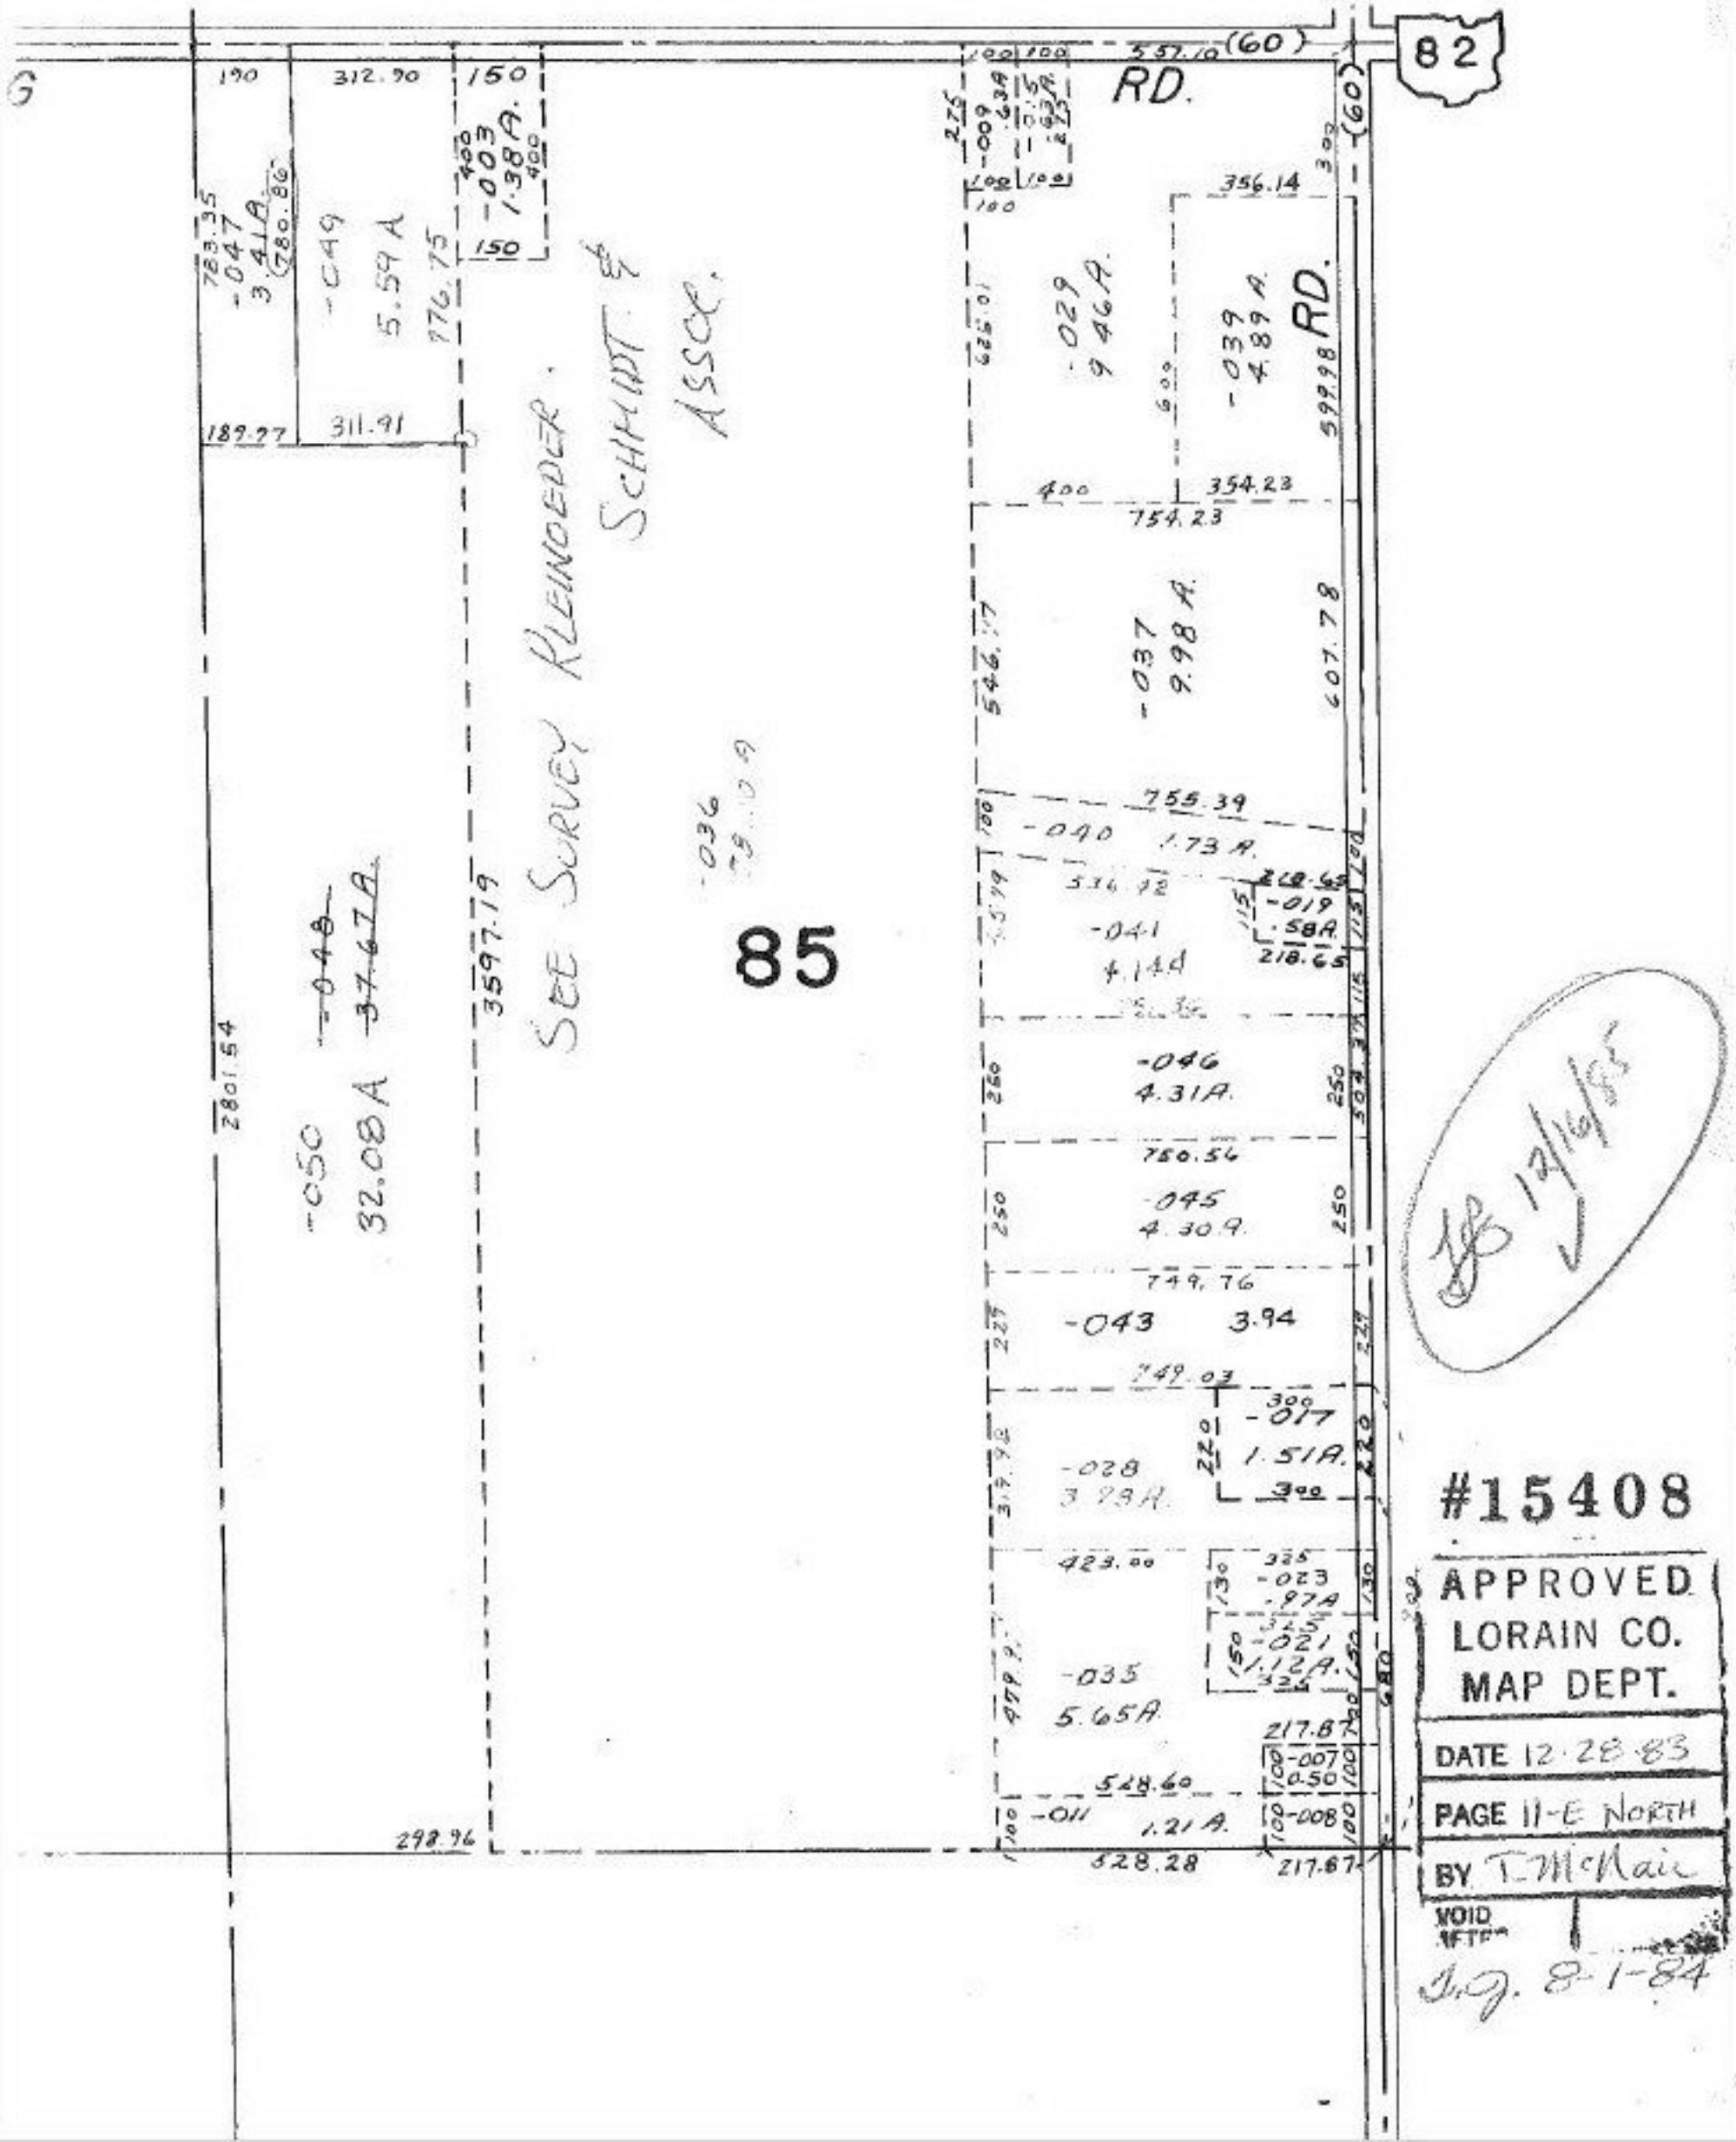

#15408

APPROVED
LORAIN CO.
MAP DEPT.

DATE 12-28-83

PAGE 11-E NORTH

BY T. McNair

VOID AFTER

J.J. 8-1-84