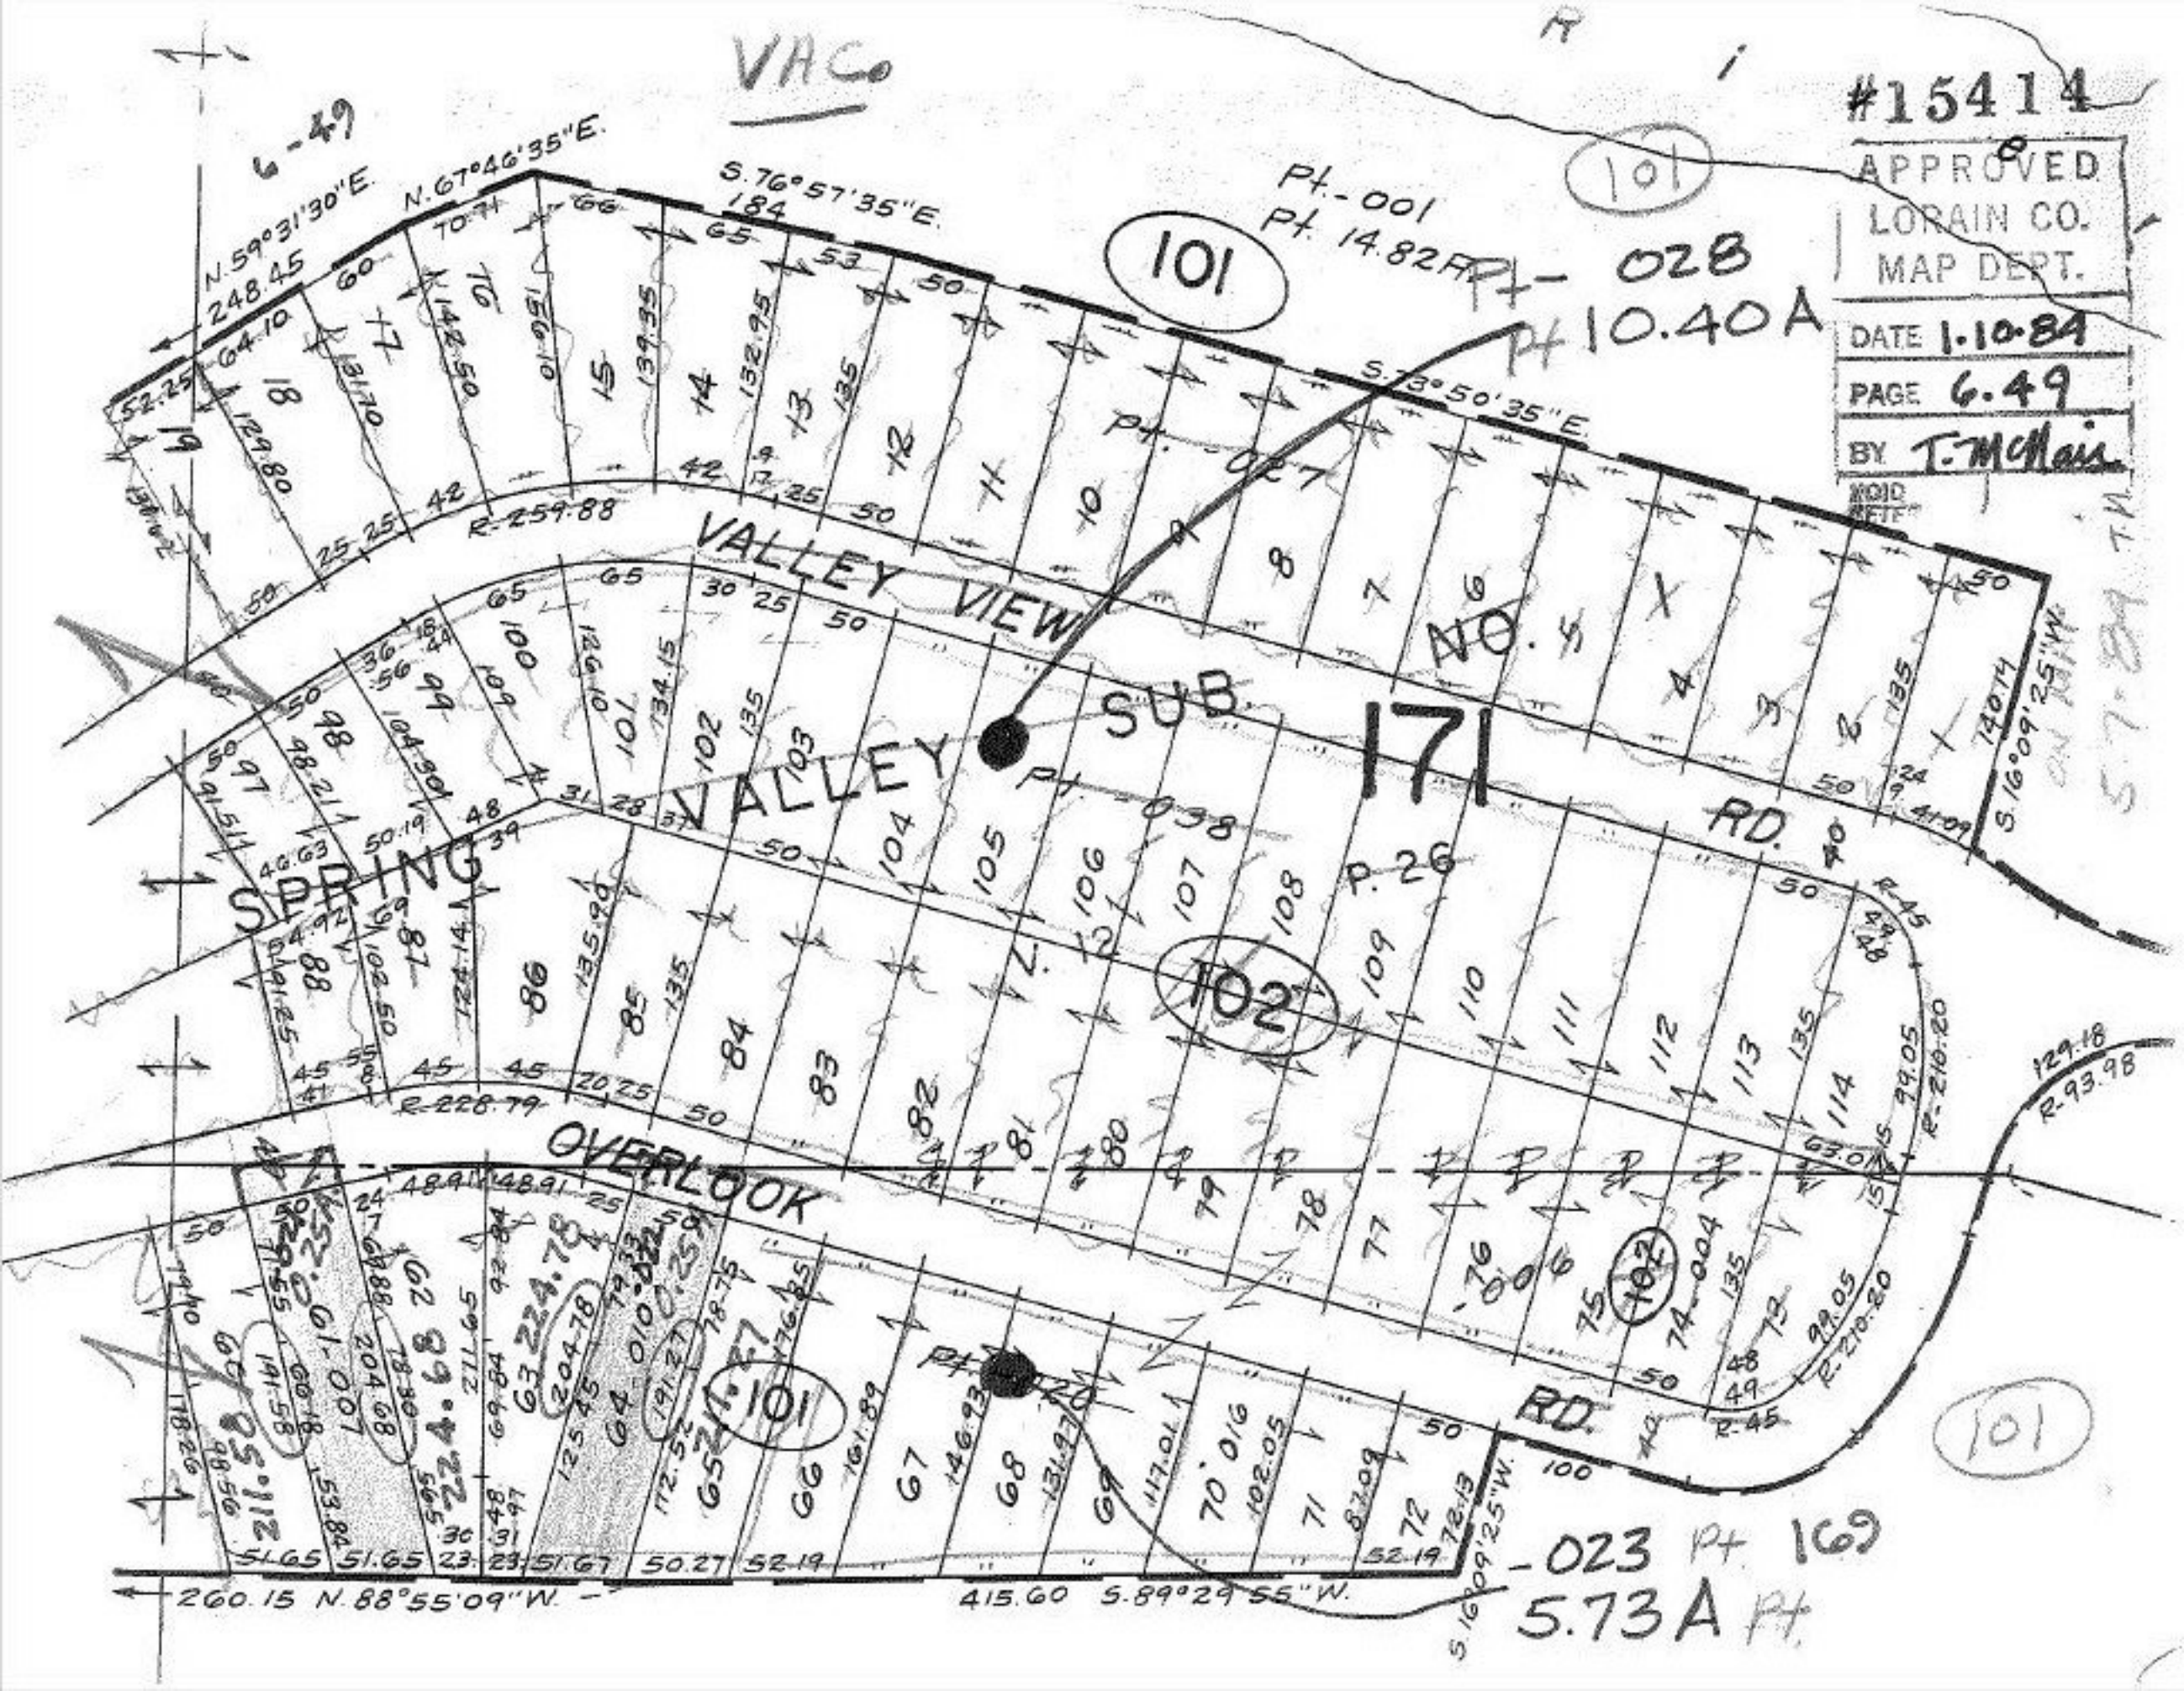

VAC
6-49
#15414
APPROVED
LORAIN CO.
MAP DEPT.
DATE 1.10.84
PAGE 6.49
BY T. McNair
VALLEY VIEW
VALLEY SUB. NO. 171
SPRING
OVERLOOK
RD.
101
102
Pt.-001
Pt. 14.82 Ft.
Pt.-028
Pt 10.40 A
Pt.-027
Pt.-038
Pt.-020
-023 Pt 169
5.73 A Pt.
N.59°31'30"E.
N.67°46'35"E.
S.76°57'35"E.
S.73°50'35"E.
S.16°09'25"W.
N.88°55'09"W.
S.89°29'55"W.
260.15
415.60
R-259.88
R-228.79
R-210.20
R-93.98
R-45