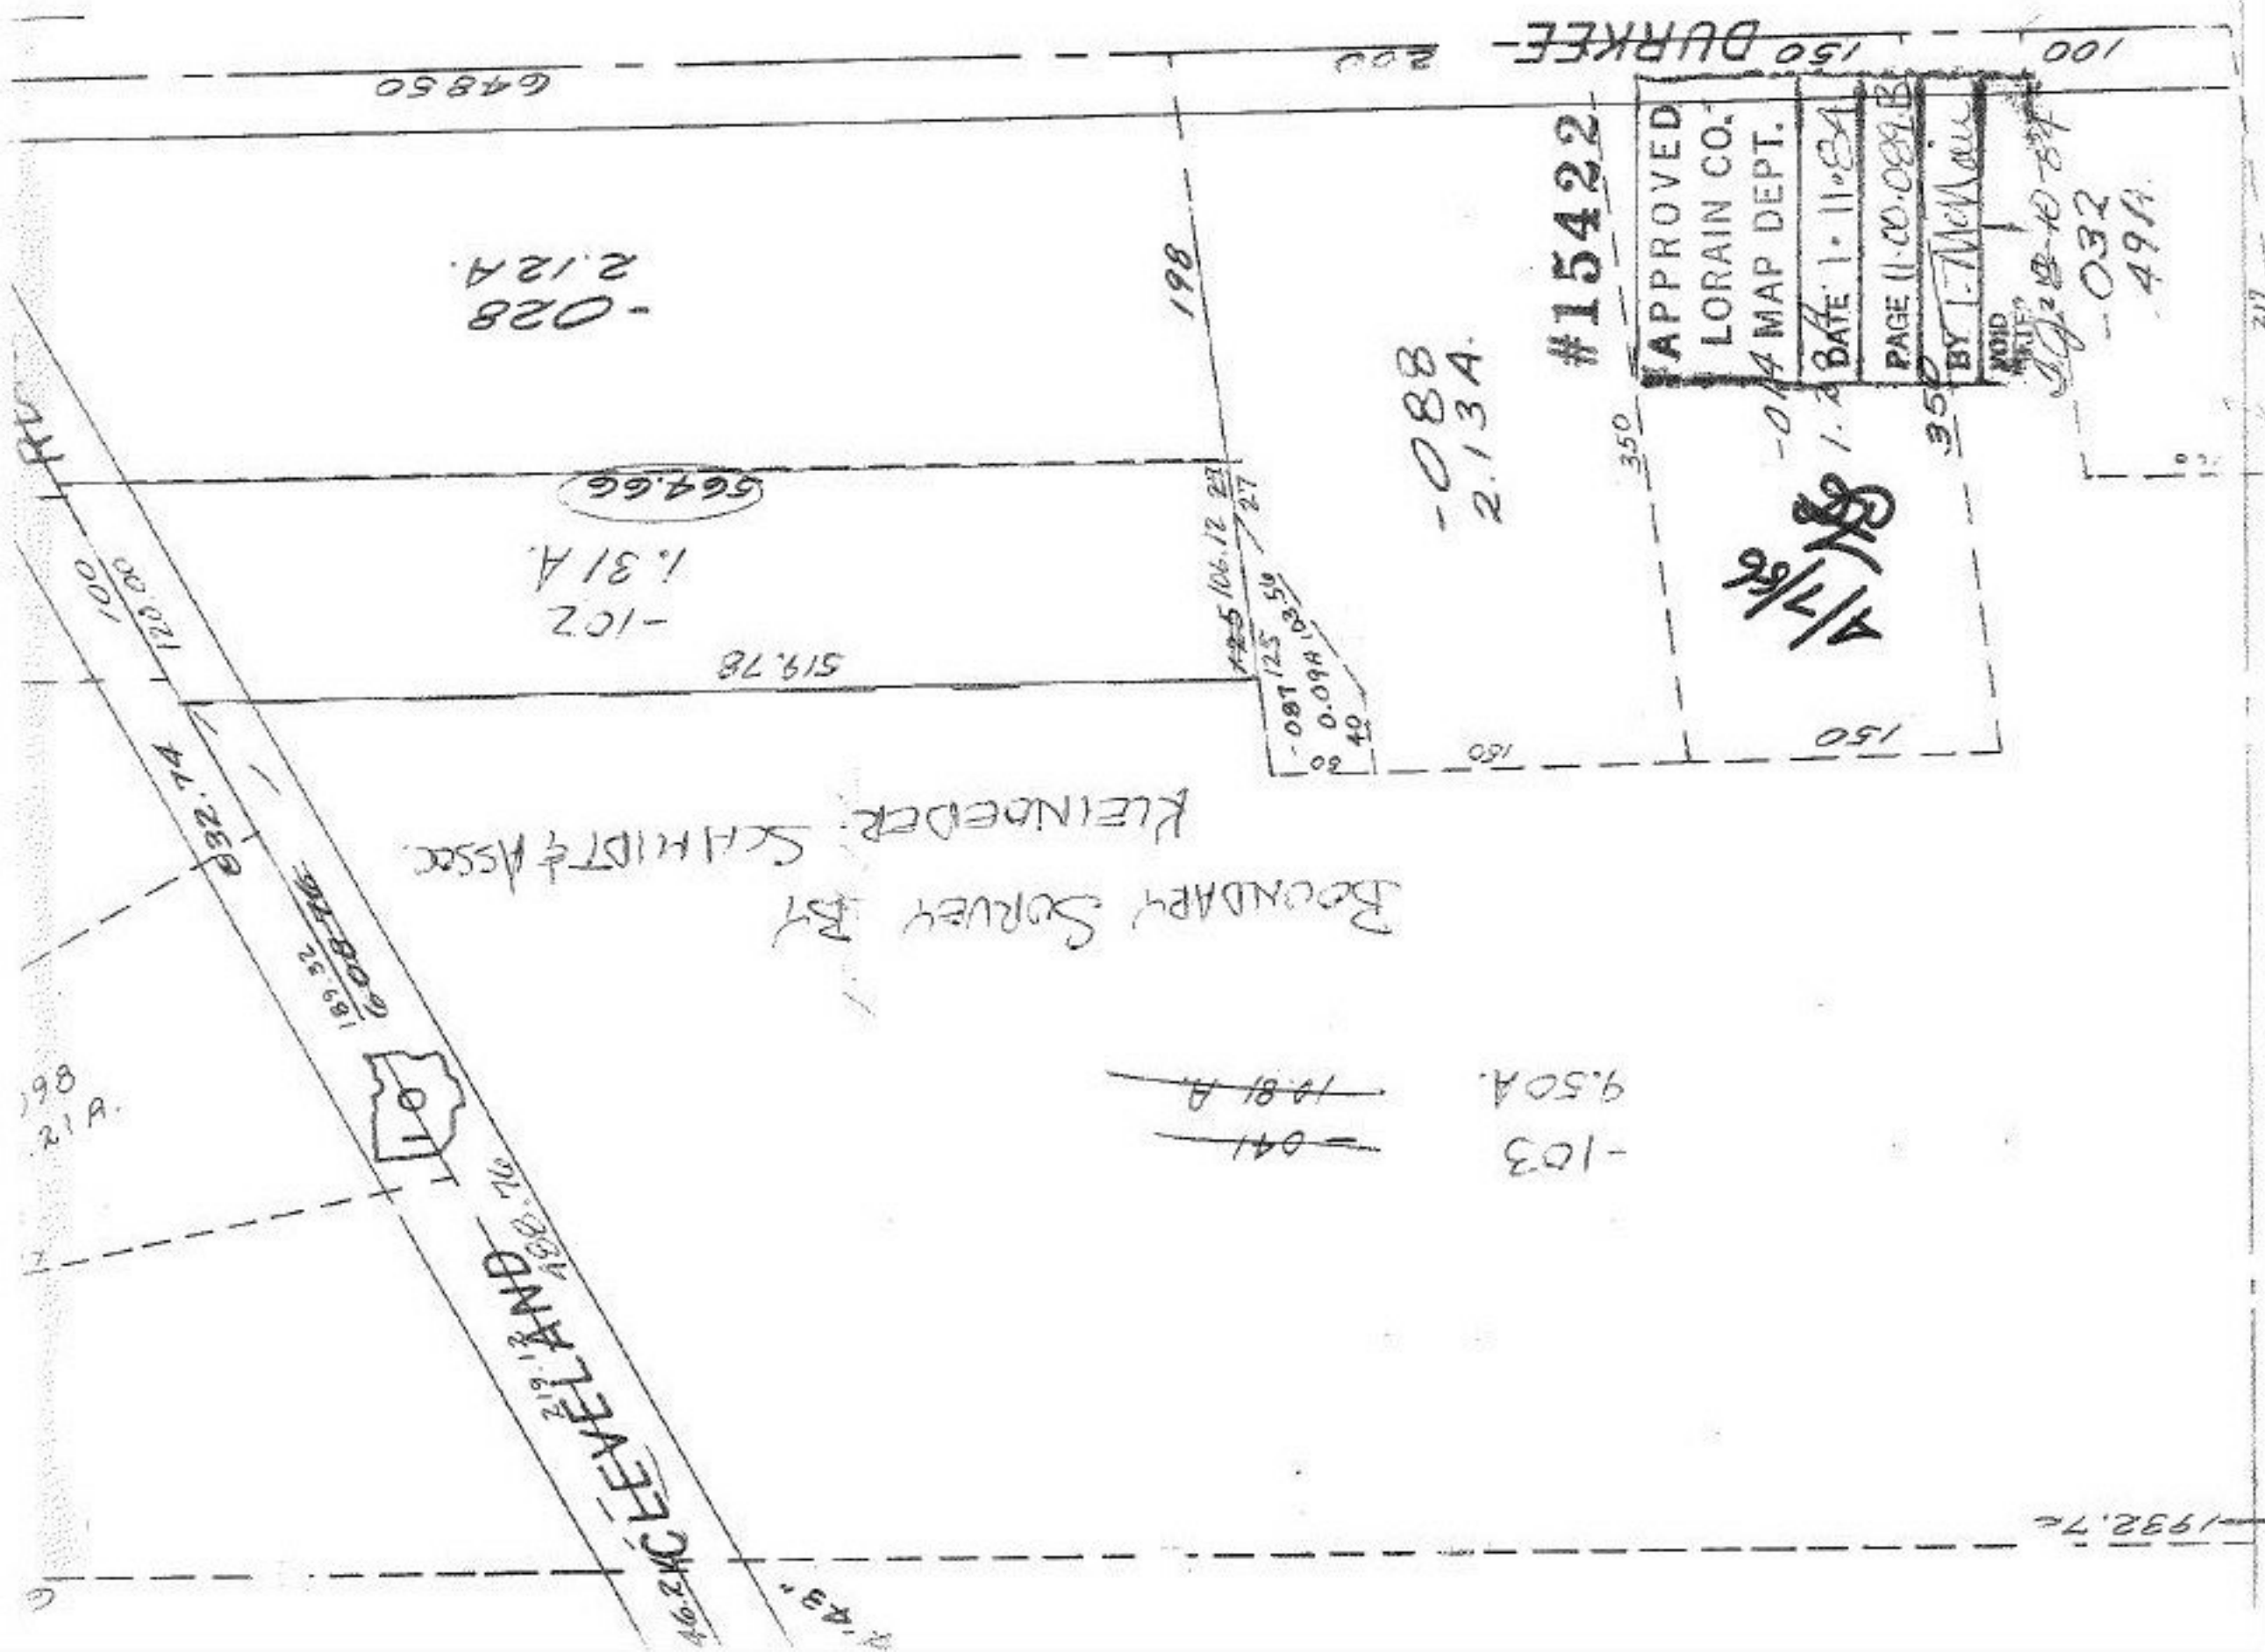
BOUNDARY SURVEY BY
KLEINHELDER SCHMIDT & ASSOC.
-103
9.50A.
-041
1.81 A.
-102
1.31A.
564.66
-028
2.12A.
-088
2.13A.
#15422
APPROVED
LORAIN CO.
MAP DEPT.
DATE 1-11-84
PAGE 11-00-089-B
BY L. McNair
VOID AFTER
-032
4.91A.
DURKEE
150
100
200
648.50
198
519.78
100
120.00
150
350
350
150
100
198
1932.7±
46.24 CLEVELAND AVE.
219.61
432.74
189.32
C08-06
32.74
RR