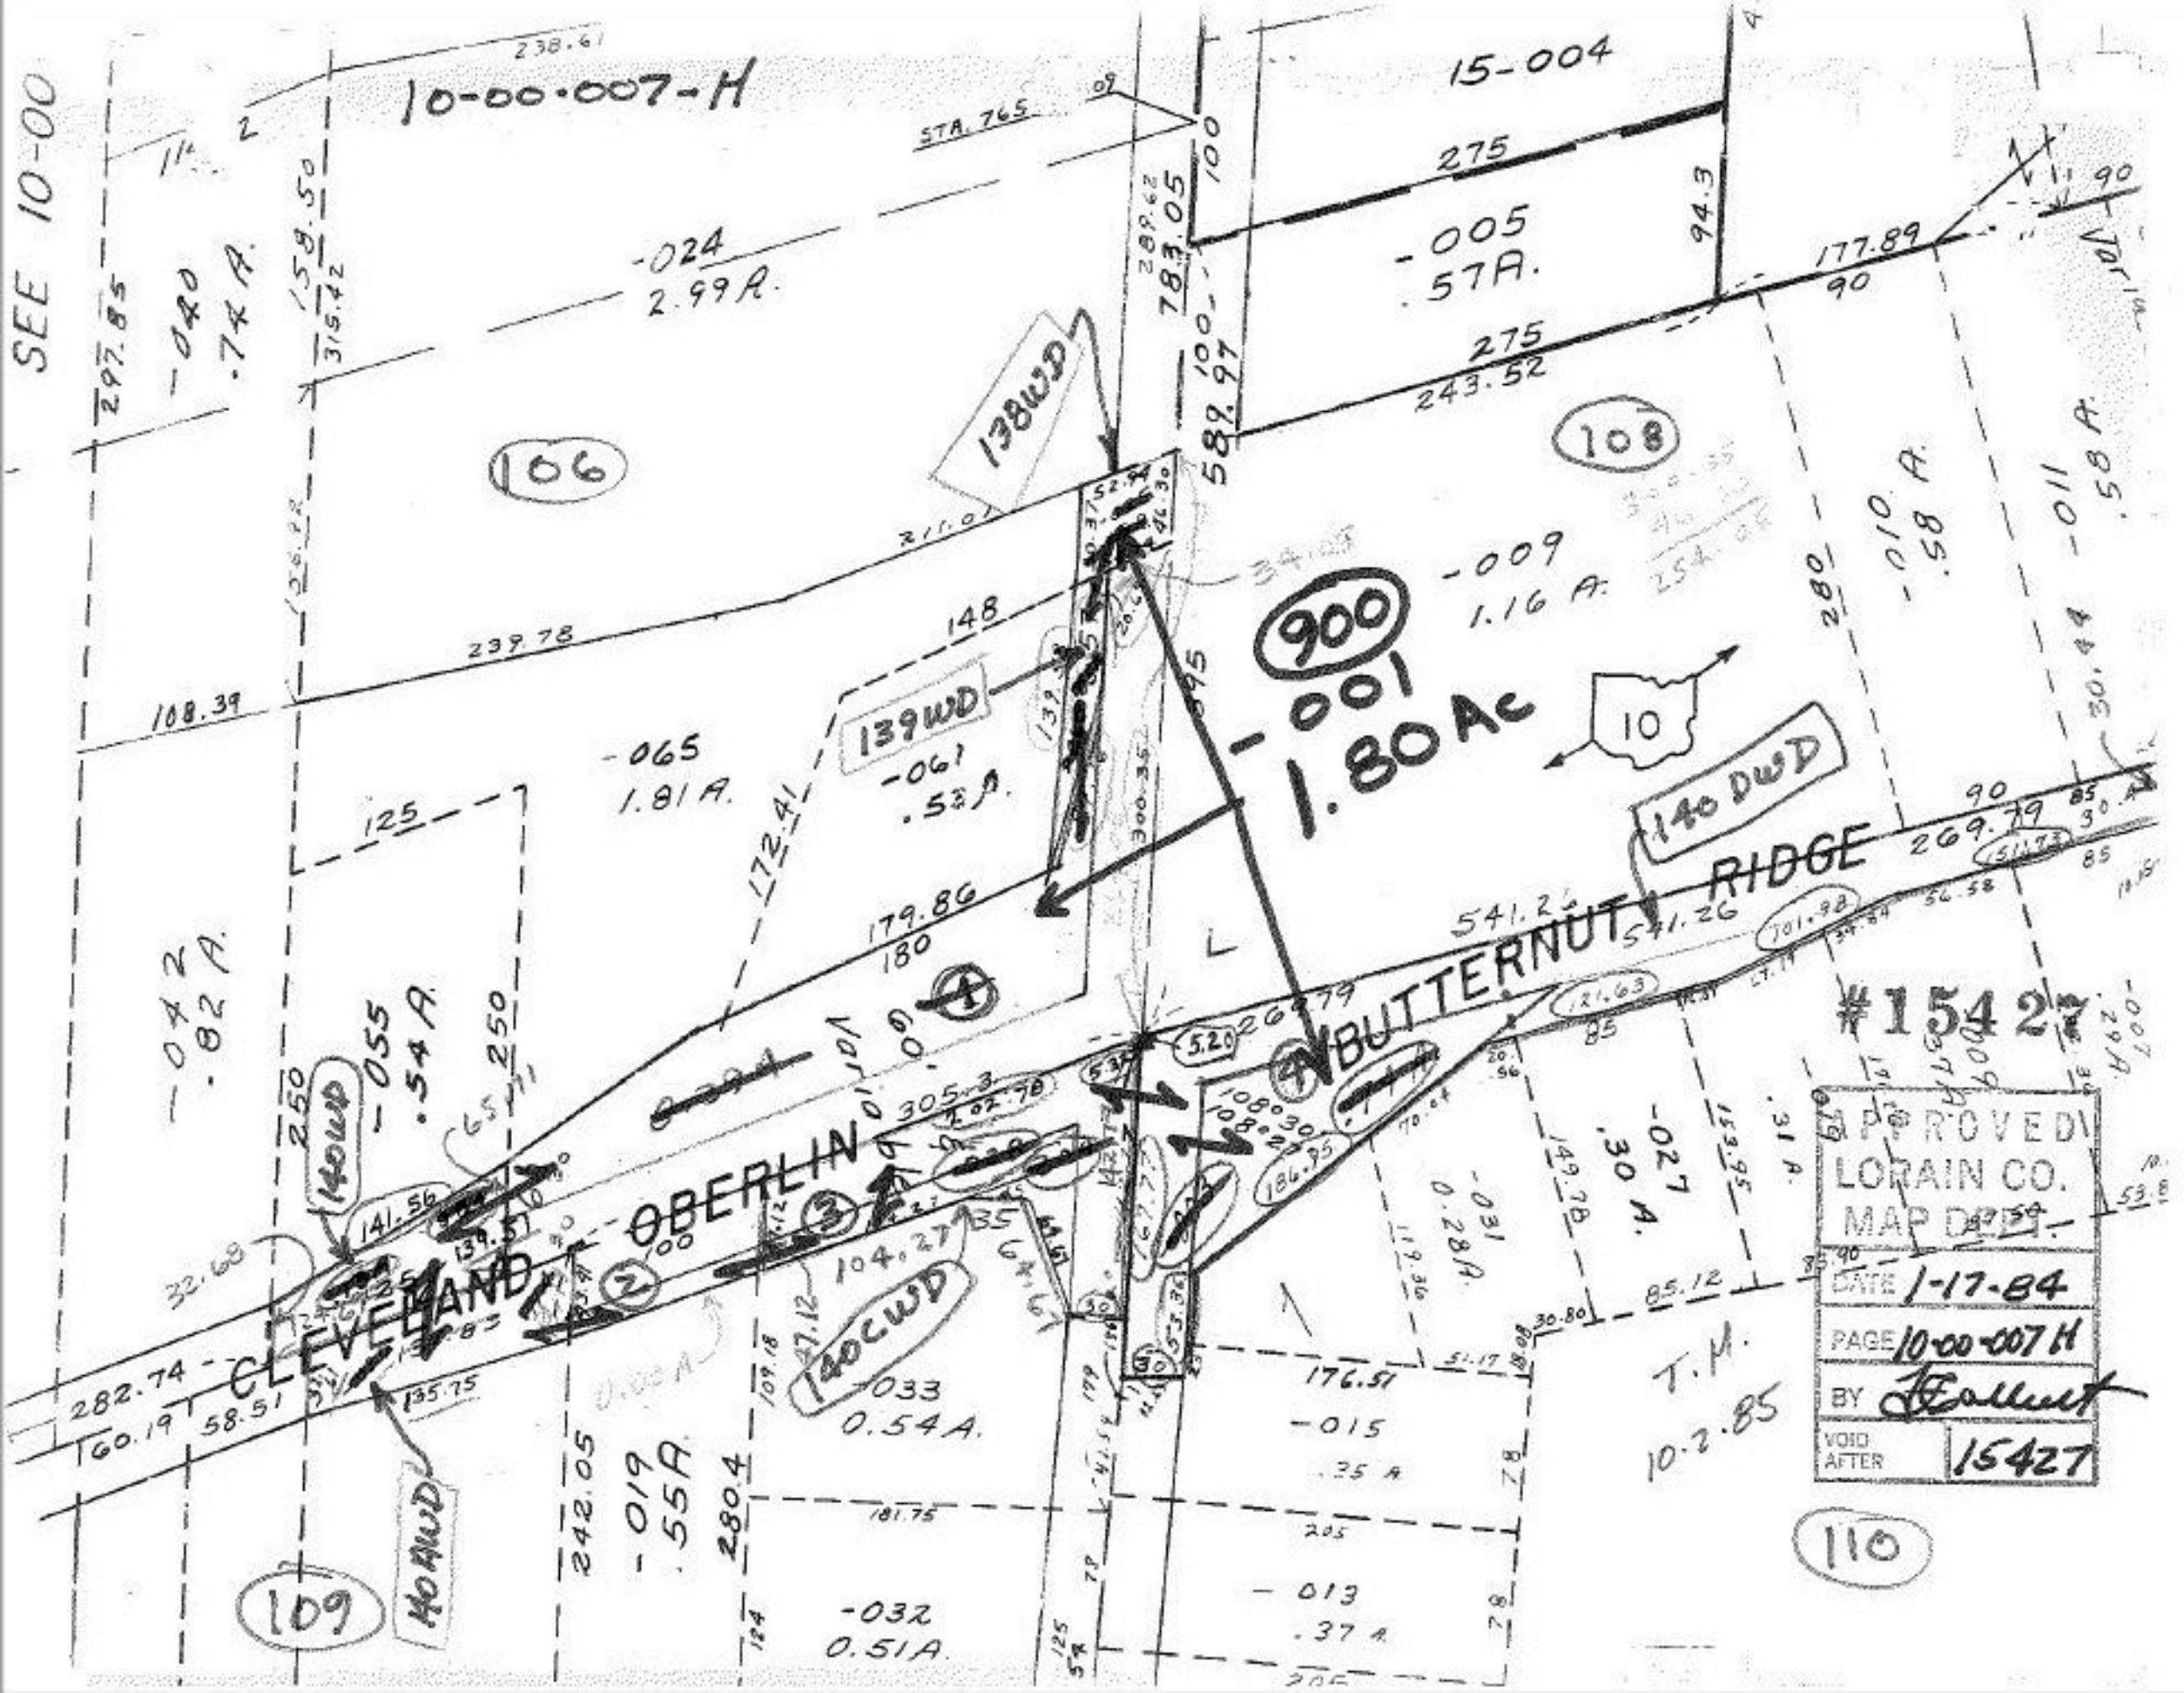

SEE 10-00
10-00-007-H
15-004
-024
2.99 A.
-005
.57 A.
275
243.52
177.89
90
106
108
138WD
139WD
140WD
140CWD
140DWD
900
-001
1.80 Ac
-009
1.16 A.
-010
.58 A.
-011
.58 A.
-065
1.81 A.
-061
.53 A.
-042
.82 A.
-055
.54 A.
-033
0.54 A.
-032
0.51 A.
-019
.55 A.
-015
.35 A.
-013
.37 A.
-031
0.28 A.
-027
.30 A.
CLEVELAND - OBERLIN
BUTTERNUT RIDGE
109
110
T.M.
10.2.85
#15427
APPROVED
LORAIN CO.
MAP DEPT.
DATE 1-17-84
PAGE 10-00-007 H
BY
VOID AFTER 15427