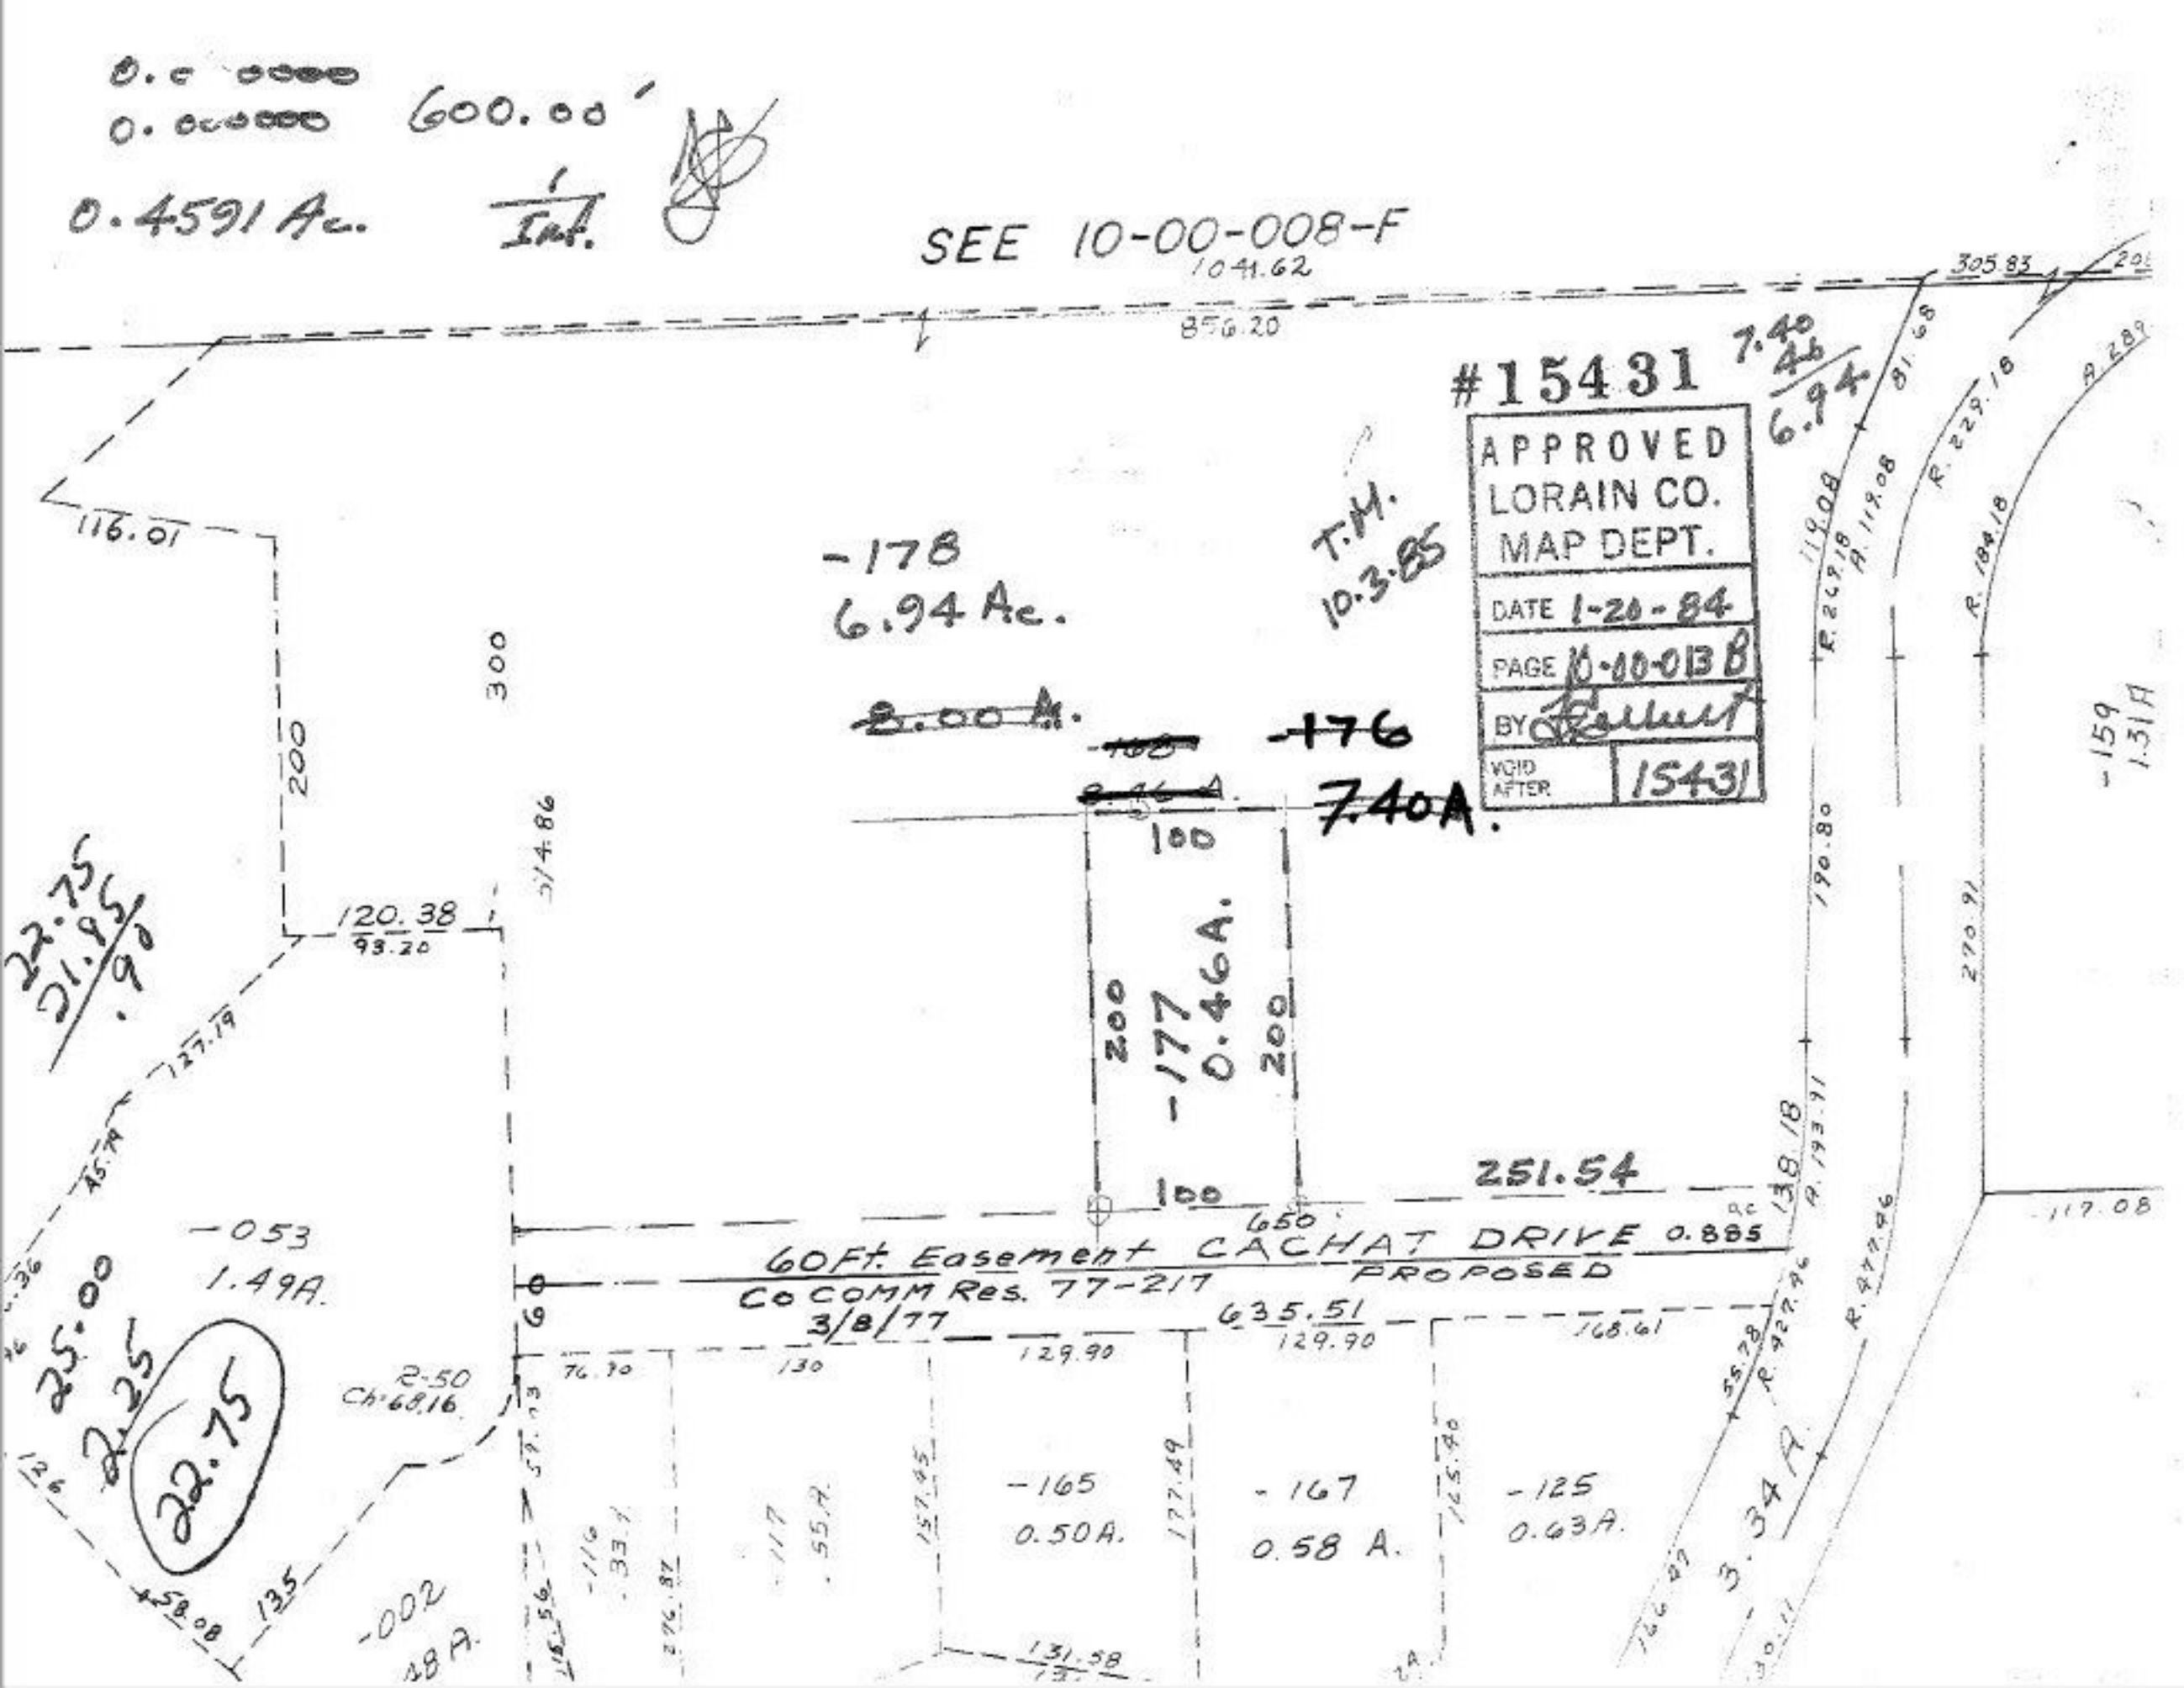

0.0 0000
0.000000
600.00'
0.4591 Ac.
1/Int.
SEE 10-00-008-F
1041.62
856.20
305.83
#15431
7.40
46
6.94
APPROVED
LORAIN CO.
MAP DEPT.
DATE 1-20-84
PAGE 10-00-013 B
BY
VOID AFTER 15431
T.M.
10.3.85
-178
6.94 Ac.
8.00 A.
-176
7.40A.
116.01
300
200
100
-177
0.46A.
200
100
251.54
650
60Ft. Easement CACHAT DRIVE 0.885
PROPOSED
CoCOMM Res. 77-217
3/8/77
635.51
129.90
129.90
168.61
-053
1.49A.
25.00
2.25
22.75
22.75
21.85
.90
120.38
93.20
127.19
45.74
R-50
Ch-68.16
76.90
130
-165
0.50A.
-167
0.58 A.
-125
0.63A.
-002
48 A.
135
58.08
131.58
3.34 A.
-159
1.31A
117.08
190.80
270.91
138.18
R. 229.18
R. 184.18
R. 119.08
R. 269.18
R. 193.91
R. 427.46
R. 477.46