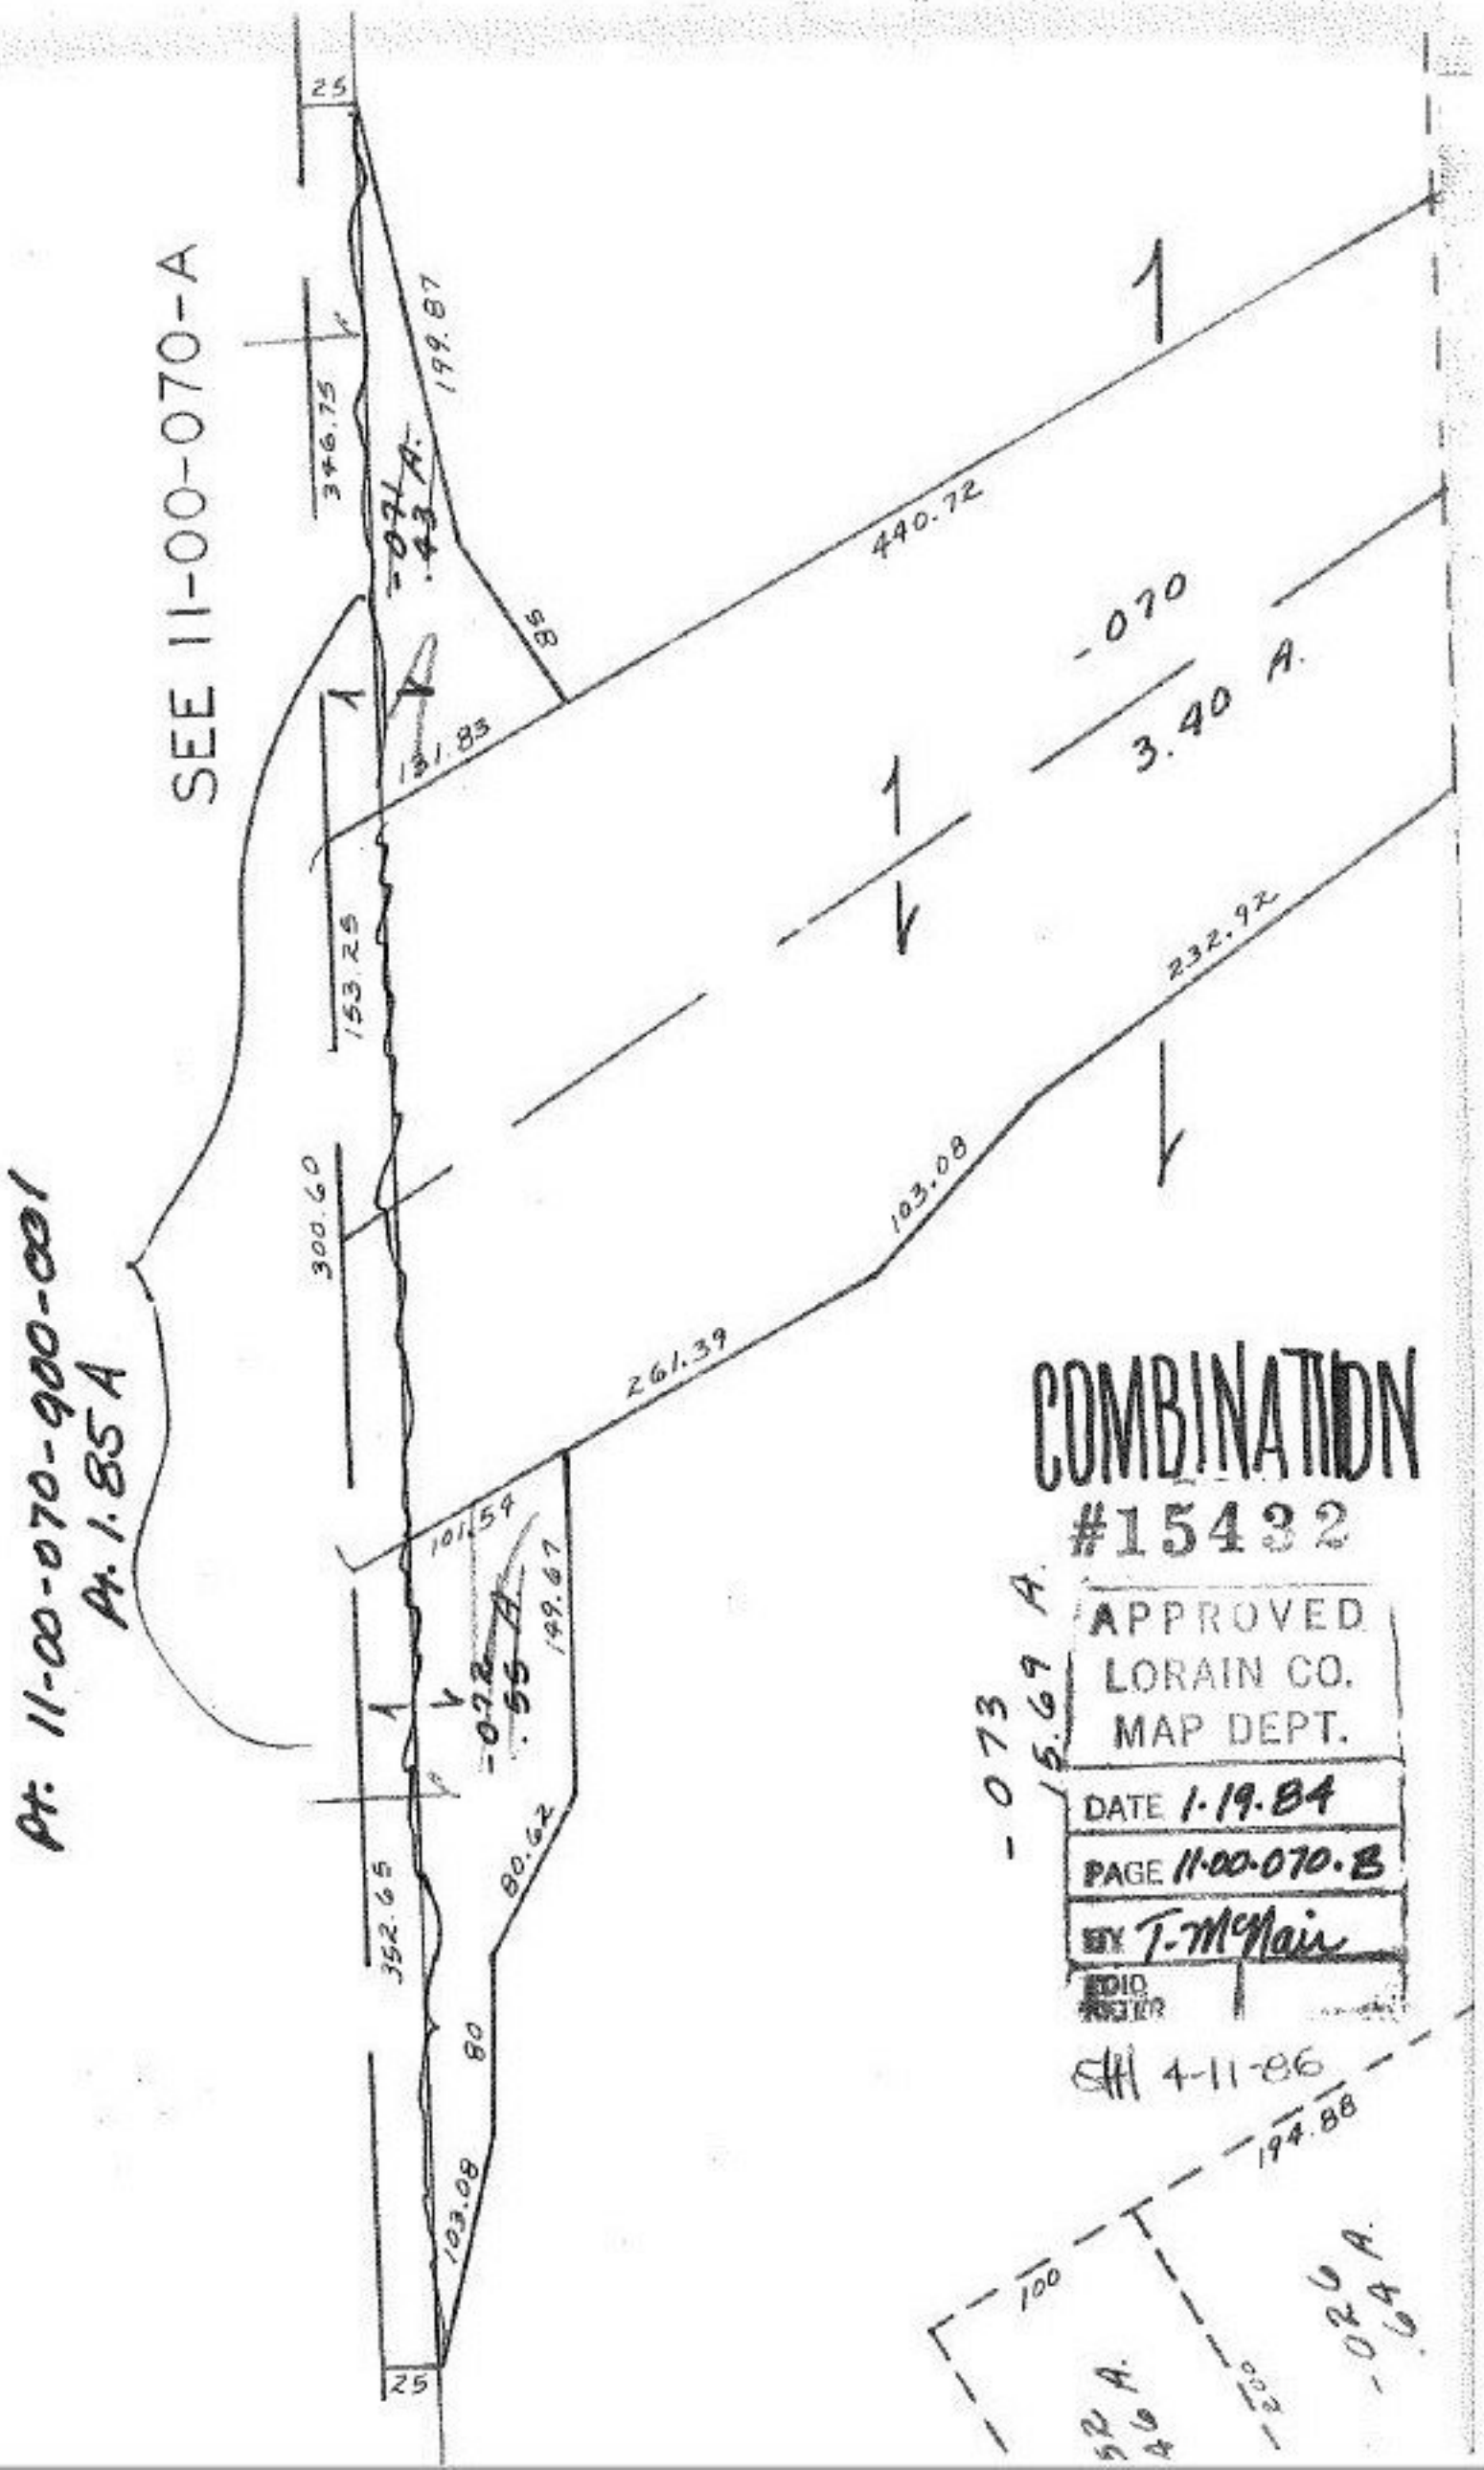
SEE 11-00-070-A
Pt. 11-00-070-900-001
Pt. 1.85 A
25
346.75
199.87
-071
.43 A.
85
440.72
-070
3.40 A.
131.83
153.25
232.92
300.60
103.08
261.39
101.54
149.67
-072
.55 A.
352.65
80.62
80
103.08
25
-073
15.69 A.
194.88
100
200
-026
.64 A.
COMBINATION
#15432
APPROVED
LORAIN CO.
MAP DEPT.
DATE 1-19-84
PAGE 11-00-070-B
BY T. McNair
EDIO
4-11-86