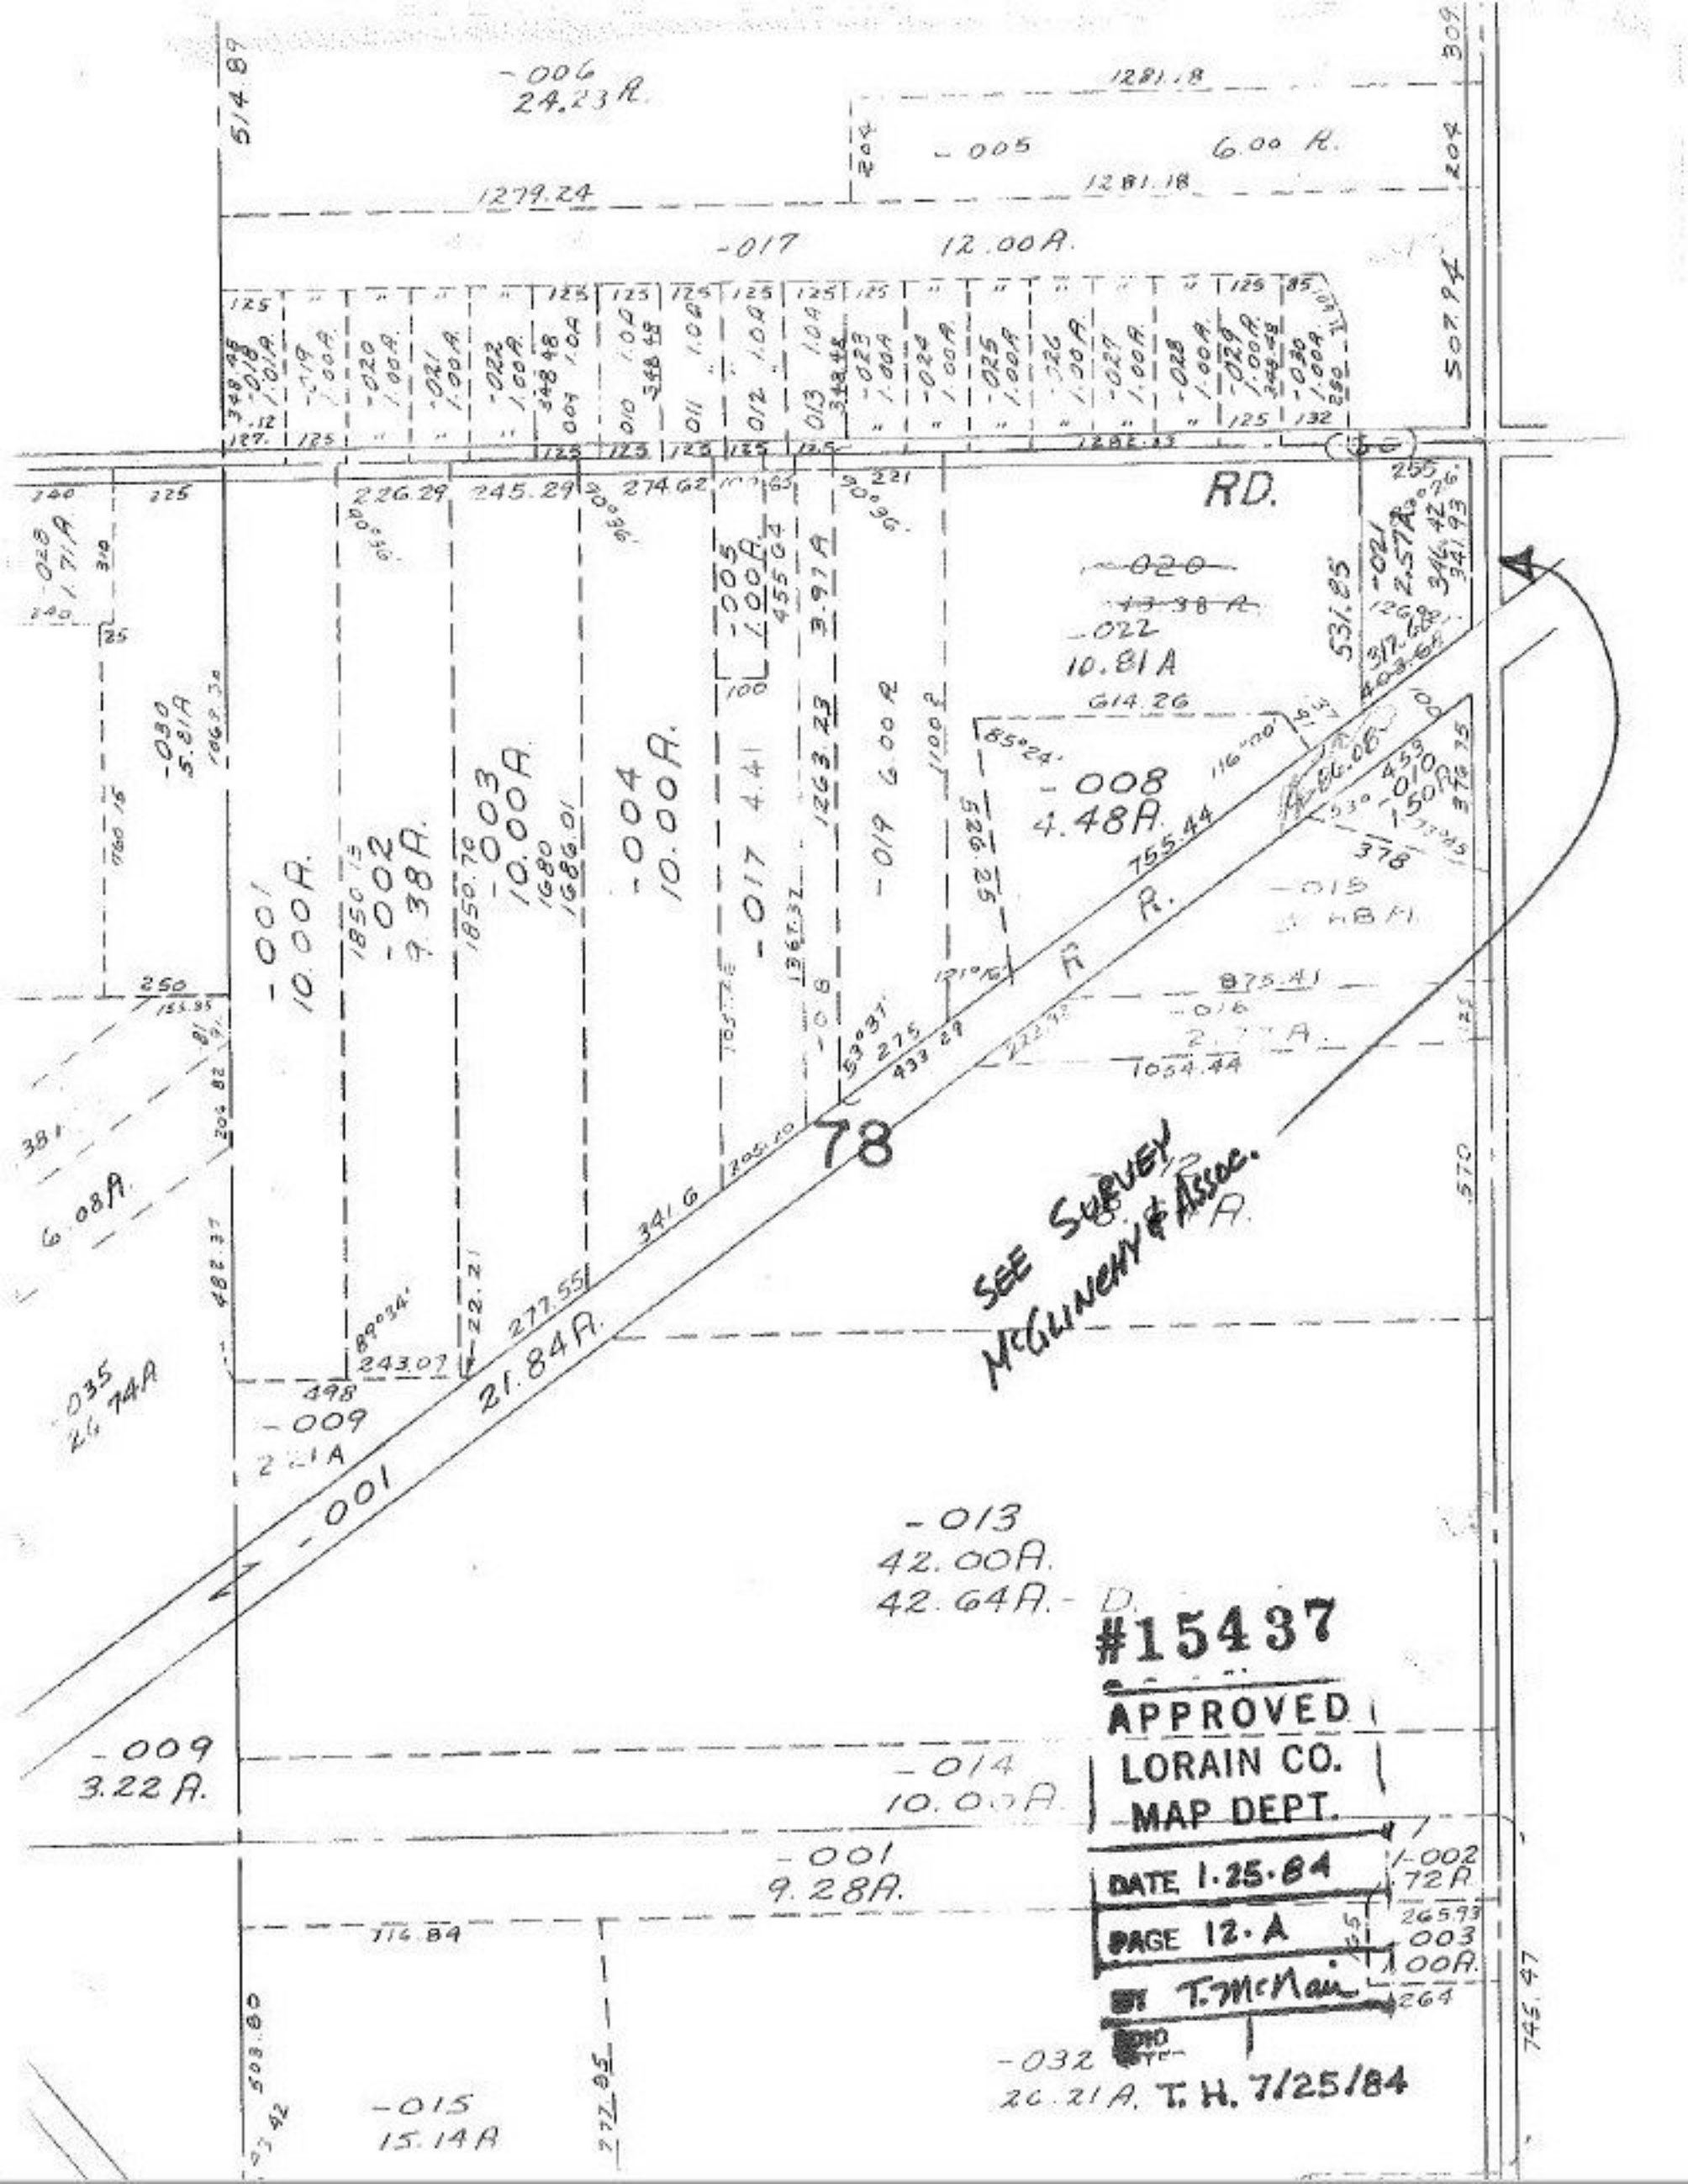

-006
24.23 A.
-005
6.00 A.
-017
12.00 A.
RD.
-020
-022
10.81 A
-008
4.48 A.
-001
10.00 A.
-002
9.38 A.
-003
10.00 A.
-004
10.00 A.
-017
4.41
-019
6.00 A.
-015
-016
-001
21.84 A.
78
SEE SURVEY
McGLINCHY & ASSOC.
-013
42.00 A.
42.64 A.
-009
3.22 A.
-014
10.00 A.
-001
9.28 A.
-032
26.21 A.
-015
15.14 A
#15437
APPROVED
LORAIN CO.
MAP DEPT.
DATE 1.25.84
PAGE 12.A
BY T. McNair
T. H. 7/25/84