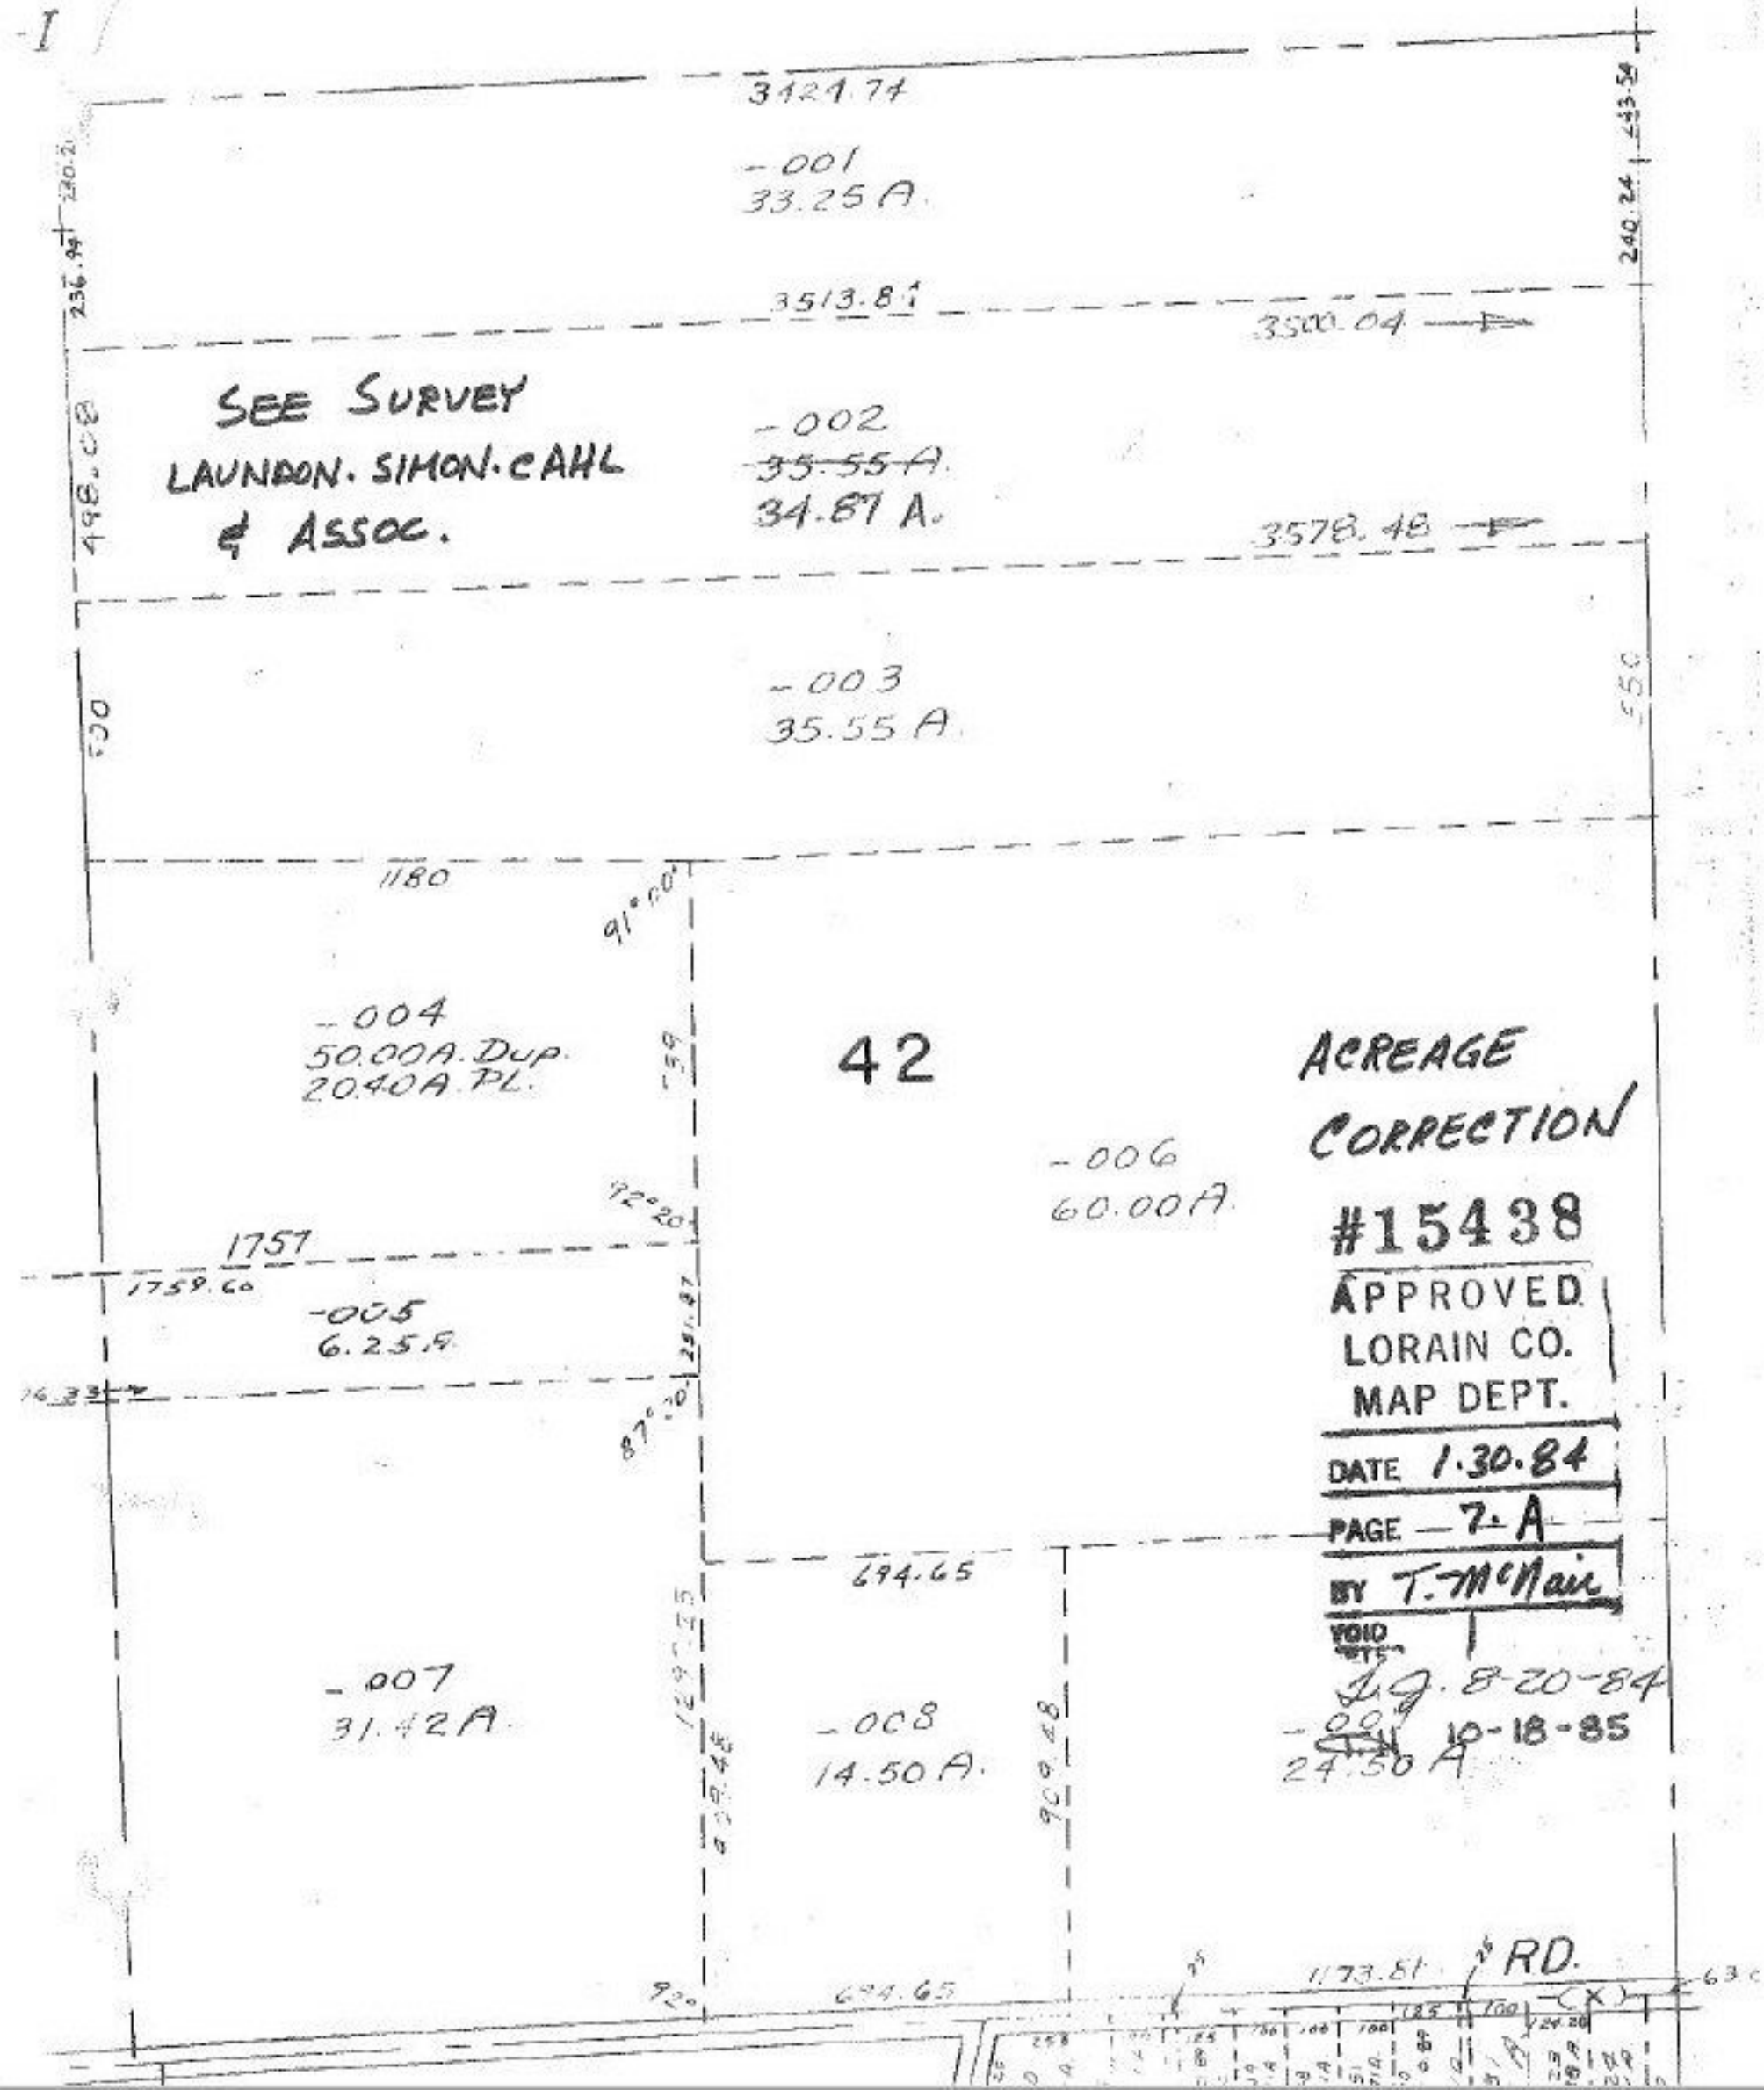

#15438
APPROVED
LORAIN CO.
MAP DEPT.
DATE 1.30.84
PAGE 7. A
BY T. McNair
VOID
Lg. 8-20-84
10-18-85